



Note: Bars wH2 not shown for clarity. See sheet 5 of 10 for reinforcement not shown.

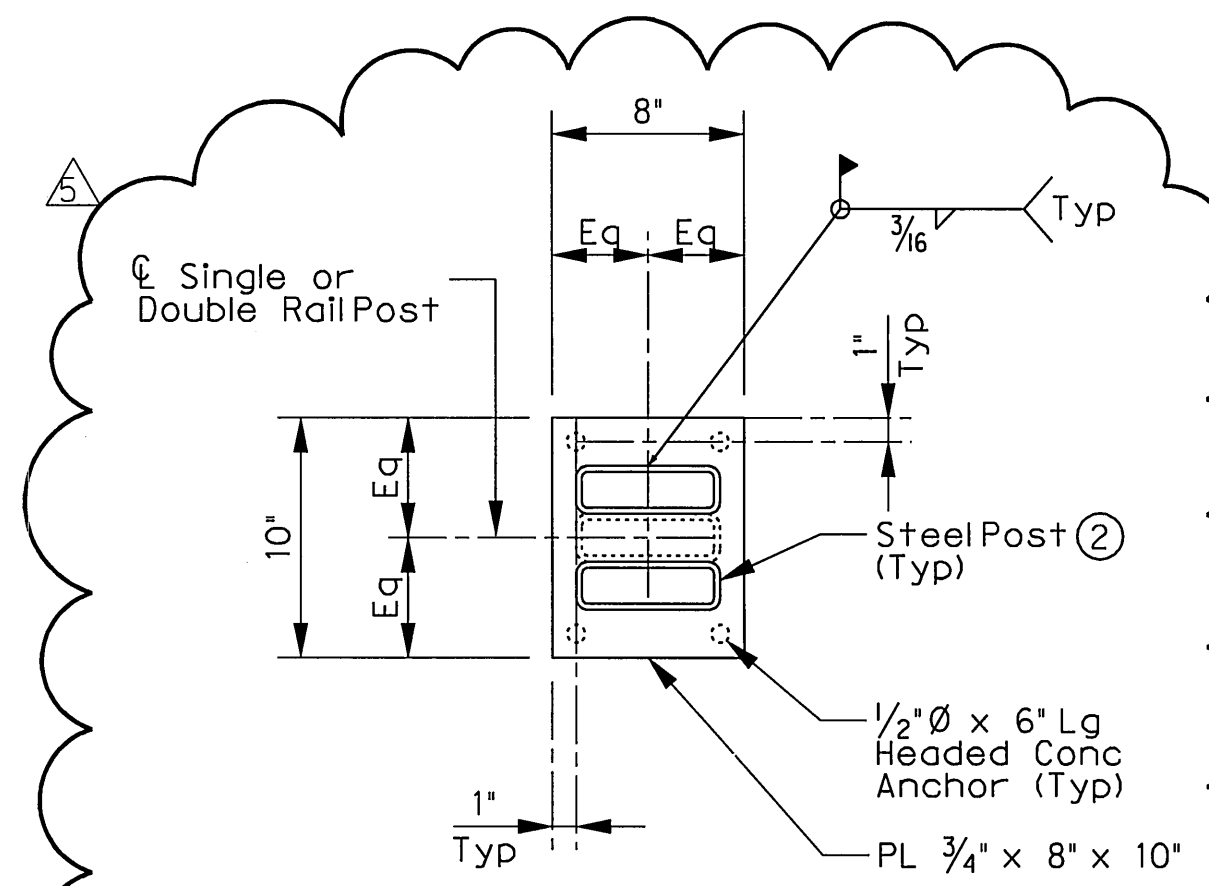


TYPICAL RAIL POST EMBED PLATE DETAIL

SCALE: 1/4" = 1'-0"

② Leave bottom one inch of post ungalvanized.

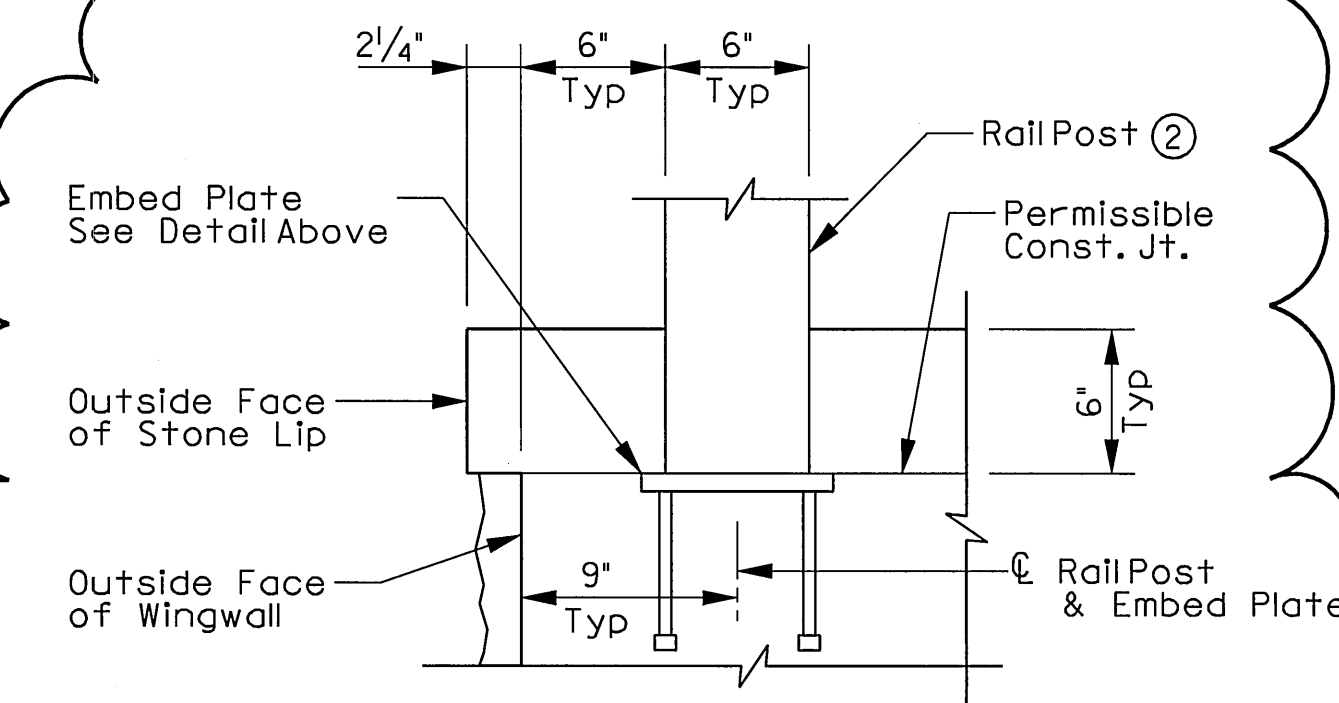

NOTE: Railposts shall be placed plumb and level.

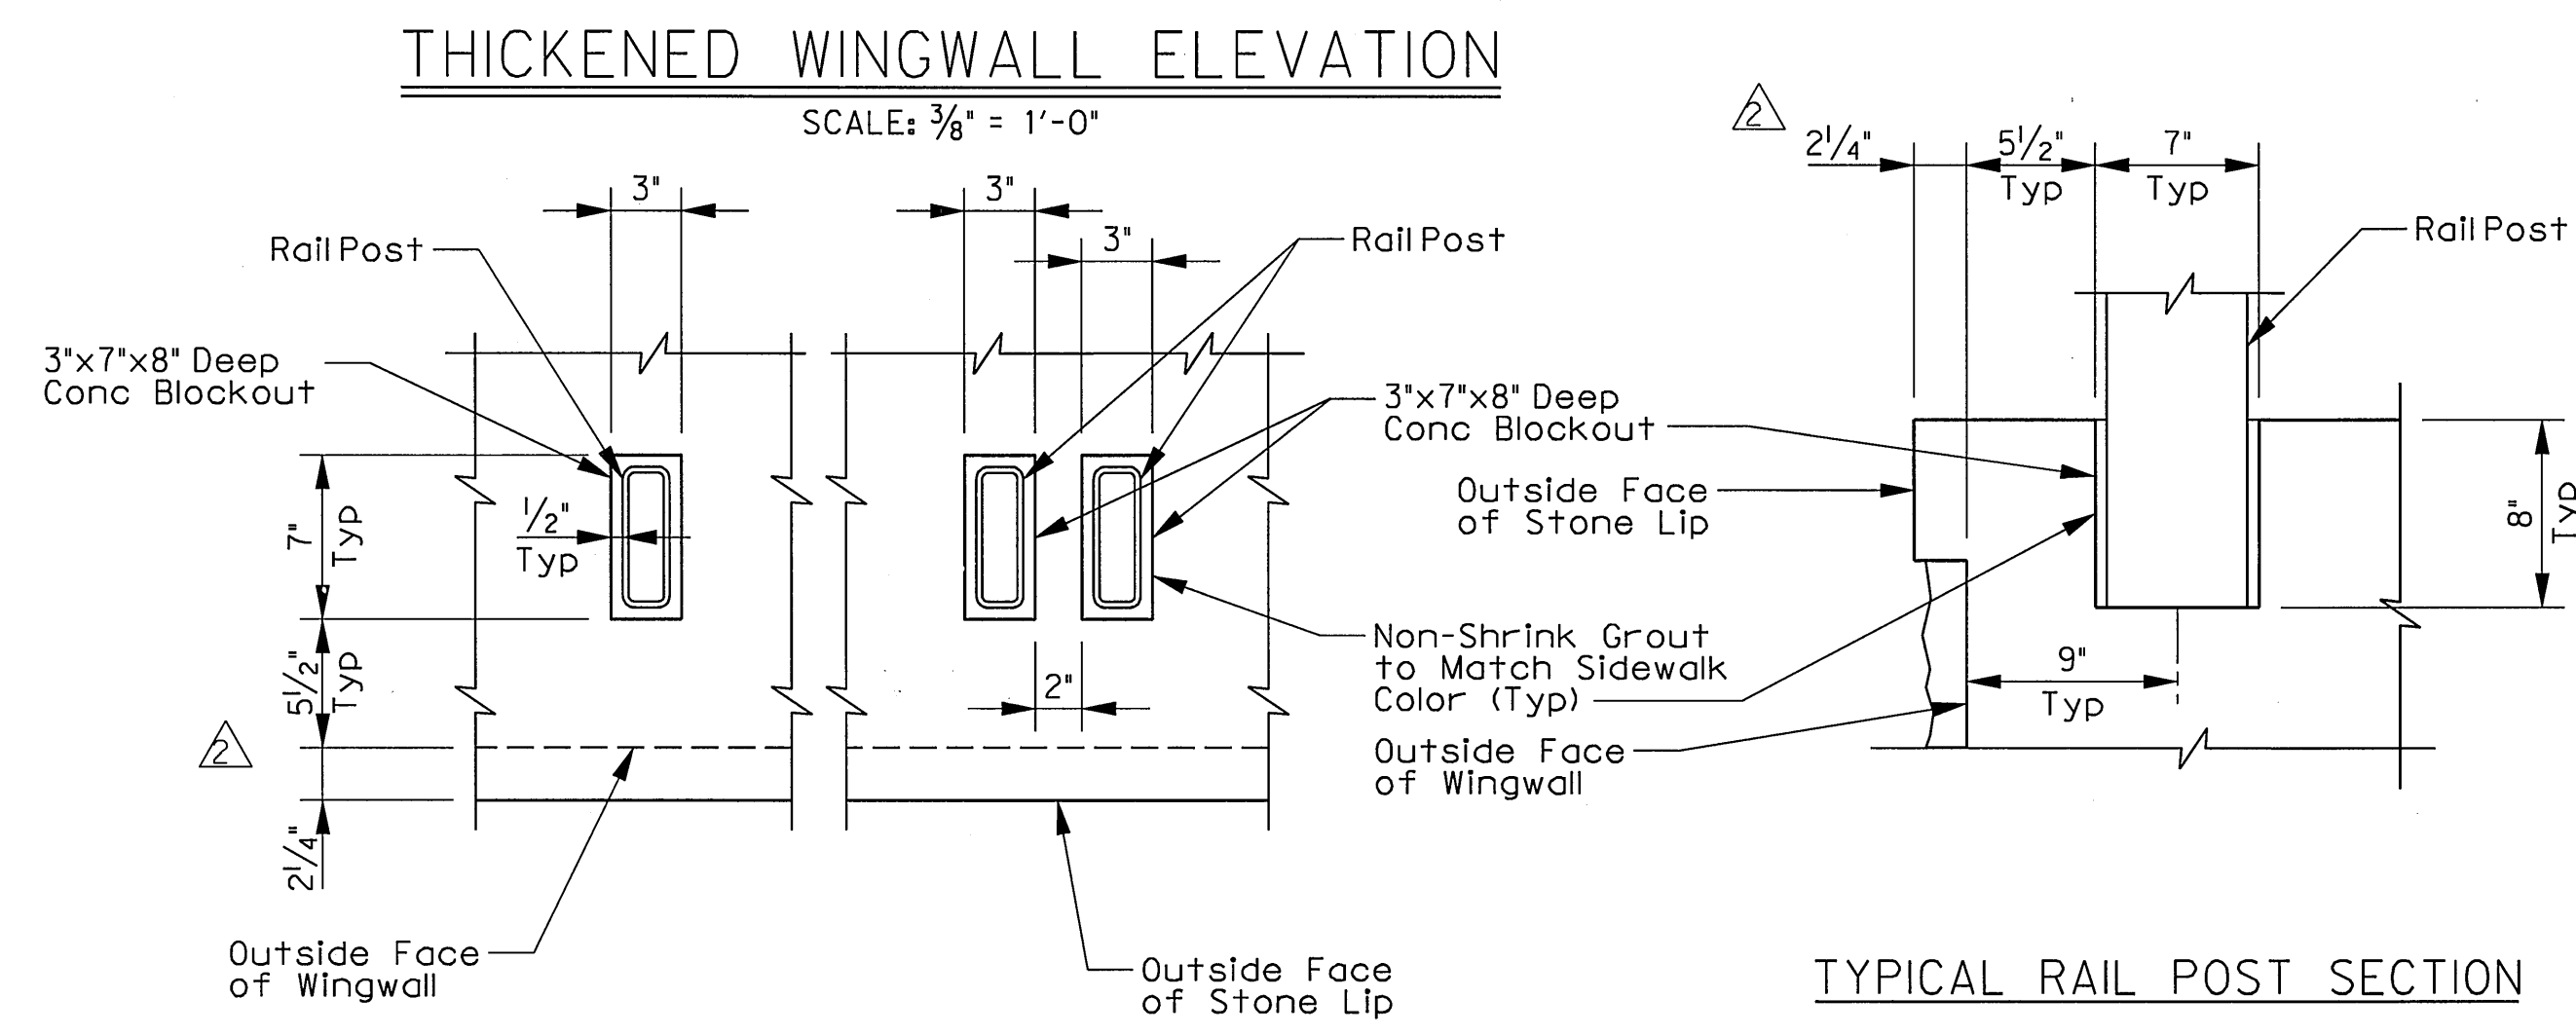

SINGLE POST DOUBLE POST

RAIL POST EMBED DETAIL OPTION 'A'

NTS

NOTE: Railposts shall be placed plumb and level.

① Bars wG spaced at every other Bar wV7 (horizontally) and every other Bar wZ (vertically). Omit Bars wG where they interfere with the steel embed.



THE SEAL APPEARING ON THIS DOCUMENT WAS AUTHORIZED BY ERIC S. CHRISTENSEN, P.E. #85412 ON 08-18-2010. ALTERATION OF A SEALED DOCUMENT WITHOUT PROPER NOTIFICATION TO THE RESPONSIBLE ENGINEER IS AN OFFENSE UNDER THE TEXAS ENGINEERING PRACTICE ACT. THE RECORD COPY OF THIS DRAWING IS ON FILE AT THE OFFICES OF HALFF ASSOCIATES, 1201 NORTH BOWSER ROAD, RICHARDSON, TEXAS, 75081, TPBE FIRM #F-312.

ADDENDUM #5	ESC	08/18/10
ADDENDUM #2	ESC	05/19/10
NO.	REVISION	BY DATE

ADDISON TOWN OF ADDISON DALLAS COUNTY, TEXAS

VITRUVIAN PARK BRIDGES PONTE AVENUE

ABUTMENT DETAILS - WINGWALL DETAILS

HALFF 1201 NORTH BOWSER ROAD, RICHARDSON, TEXAS 75081-2275  
TEL (214) 346-6200 FAX (214) 738-0065

PROJECT	DESIGN	DRAWN	DATE	FILE	SHEET
27379	ESC	AHH	APRIL 2010	-	S1-10