


NOTE: REFERENCE SHEET S1-09 FOR STRUCTURAL CONSTRUCTION.

01 WINGWALL ELEVATION
SCALE: N.T.S.

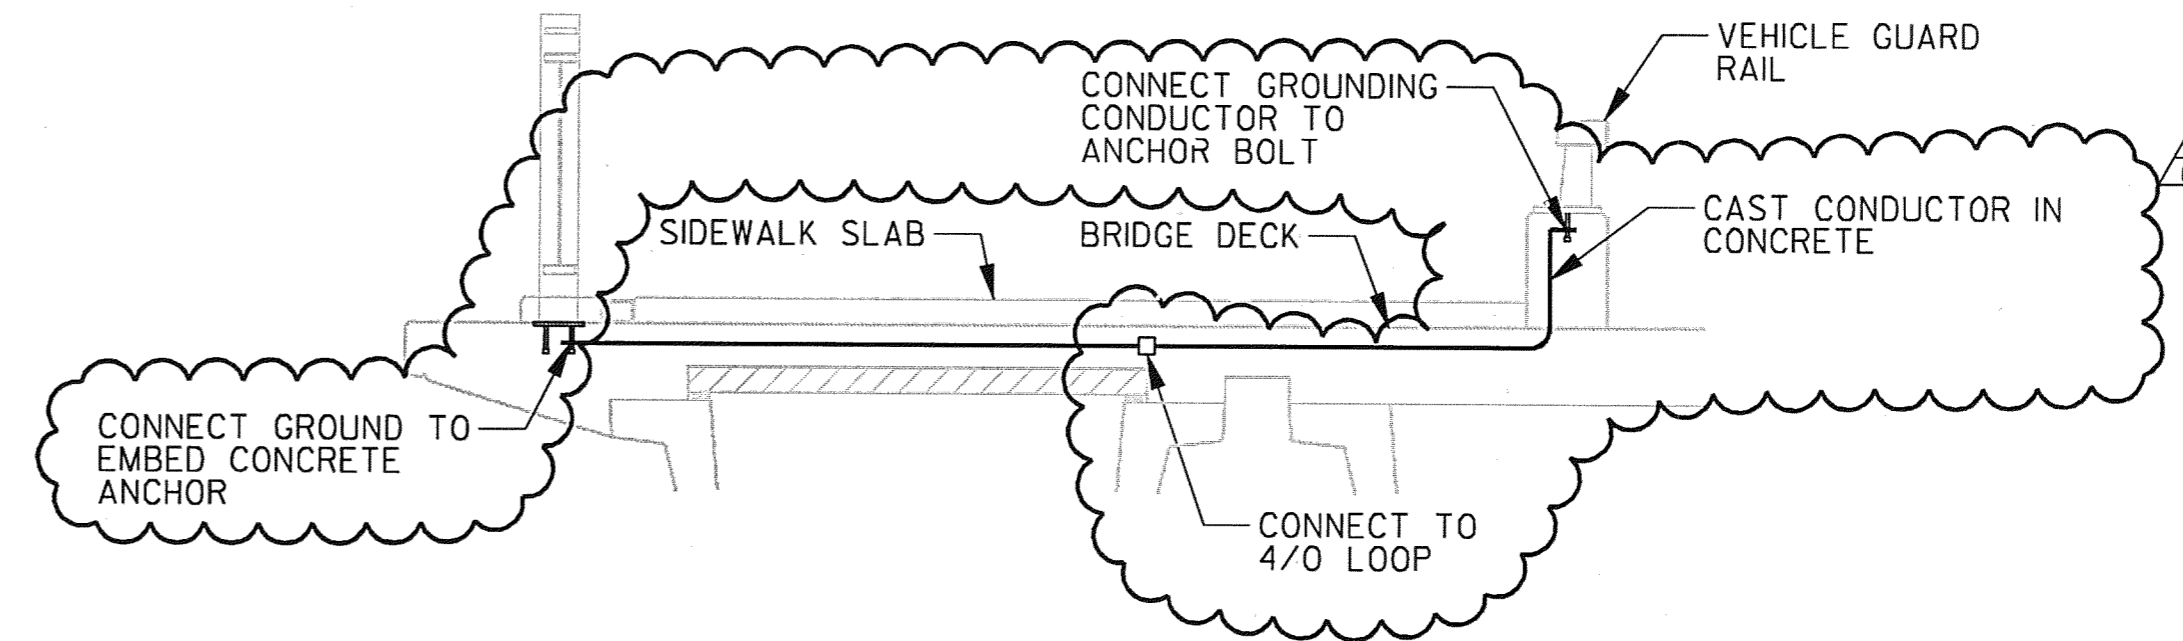

NOTE: REFERENCE SHEET S1-17 FOR STRUCTURAL CONSTRUCTION

02 HANDRAIL AND GUARDRAIL GROUNDING DETAIL
SCALE: N.T.S.



THE SEAL APPEARING ON THIS DOCUMENT WAS AUTHORIZED BY DIANNE M. POPKEN, P.E., #41979 ON 04-29-2010, ALTERATION OF A SEALED DOCUMENT WITHOUT PROPER NOTIFICATION TO THE RESPONSIBLE ENGINEER IS AN OFFENSE UNDER THE TEXAS ENGINEERING PRACTICE ACT. THE RECORD COPY OF THIS DRAWING IS ON FILE AT THE OFFICES OF HALFF ASSOCIATES, 1201 NORTH BOWSER ROAD, RICHARDSON, TEXAS, 75081-1275, FROM #2-312.

10-6-10

NO.	REVISION	BY	DATE
	REVISED GROUNDING	DMP	10/06/10
	RESPONSE TO RFI #4	DMP	09/21/10

Addison TOWN OF ADDISON
DALLAS COUNTY, TEXAS

VITRUVIAN PARK BRIDGES
PONTE AVENUE

BRIDGE GROUNDING DETAILS

HALFF 1201 NORTH BOWSER ROAD, RICHARDSON, TEXAS 75081-2275
TEL (214) 346-8200 FAX (214) 739-0095

PROJECT	DESIGN	DRAWN	DATE	FILE	SHEET
27379	DMP	AHH	APRIL 2010	-	E1-05