

GENERAL NOTES

- REF. STRUCTURAL DRAWINGS FOR ALL BRIDGE DIMENSIONS AND COORDINATES.
- ALL RAILING SHALL BE SPACED AT TYPICAL 10'-0" INCREMENTS AS SHOWN ON SHEET L3-01 UNLESS OTHERWISE NOTED.
- ALL WALK DIMENSIONS ARE GIVEN FROM BACK OF CURB UNLESS OTHERWISE NOTED.
- REF. ELECTRICAL DRAWINGS FOR ALL LIGHT FIXTURE TYPES.
- ALL ITEMS AND APPURTANANCES N.I.C. TO BE COORDINATED BY THE CONTRACTOR PRIOR TO WORK COMMENCEMENT.
- ALL DIMENSIONS AND ITEM LOCATIONS ARE TO MIRROR ALONG THE ROAD CENTERLINE UNLESS OTHERWISE NOTED.
- ALL PAVER SQUARE FOOTAGES NOTED. REPRESENT TOTAL BRIDGE QUANTITIES UNLESS OTHERWISE NOTED.

DESIGN SELECTION: PAVING

CONCRETE PAVERS:

CONCRETE PAVER TYPE 'A'

CITY STONE I
 SIZE: 11 3/4" x 5 13/16" x 2 3/8"
 COLOR: TRAVERTINE BLEND
 PATTERN: HERRINGBONE

△ QUANTITY: 1,415 S.F.

CONCRETE PAVER TYPE 'B'

CITY STONE I
 SIZE: 11 3/4" x 5 13/16" x 2 3/8"
 COLOR: BELLOW BROWN
 PATTERN: SINGLE BRICK HEADER

△ QUANTITY: 330 S.F.

CONCRETE PAVING:

CONCRETE PAVING TYPE 'A'

FINISH: HEAVY SANDBLAST
 △ COLOR: NONE

CONCRETE PAVING TYPE 'B'

FINISH: ROCK SALT
 △ COLOR: NONE
 SAW-CUT PATTERN

PAVING GENERAL NOTES:

- SEE ON-SITE MOCK-UP FOR ALL REFERENCED CONCRETE AND STONE COLORS AND TEXTURES.
- CONTRACTOR TO PROVIDE A 4' x 4' MOCK-UP OF ALL REFERENCED CONCRETE PAVING AND PAVER COLOR, PATTERNS AND TEXTURES FOR APPROVAL PRIOR TO WORK COMMENCEMENT.



THE SEAL APPEARING ON THIS DOCUMENT WAS AUTHORIZED BY LENNY L. HUGHES, R.L.A. #2067 ON 05-19-2010. ALTERATION OF A SEALED DOCUMENT WITHOUT PROPER NOTIFICATION TO THE RESPONSIBLE LANDSCAPE ARCHITECT IS AN OFFENSE UNDER THE TEXAS ENGINEERING PRACTICE ACT. THE RECORD COPY OF THIS DRAWING IS ON FILE AT THE OFFICES OF HALFF ASSOCIATES, INC., 1201 NORTH BOWSER, RICHARDSON, TEXAS 75081. TYPE FIRM #F-312

ADDENDUM #2	JDB	05/19/10
ADDENDUM #1	JDB	05/14/10
NO.	REVISION	BY DATE


Addison TOWN OF ADDISON
DALLAS COUNTY, TEXAS

VITRUVIAN PARK BRIDGES
PONTE AVENUE


ENLARGED
PAVING LAYOUT

HALFF 1201 NORTH BOWSER ROAD, RICHARDSON, TEXAS 75081-2275
TEL (214) 346-6200 FAX (214) 739-0095

PROJECT	DESIGN	DRAWN	DATE	FILE	SHEET
27379	JDB	AHH	APRIL 2010	-	L1-10

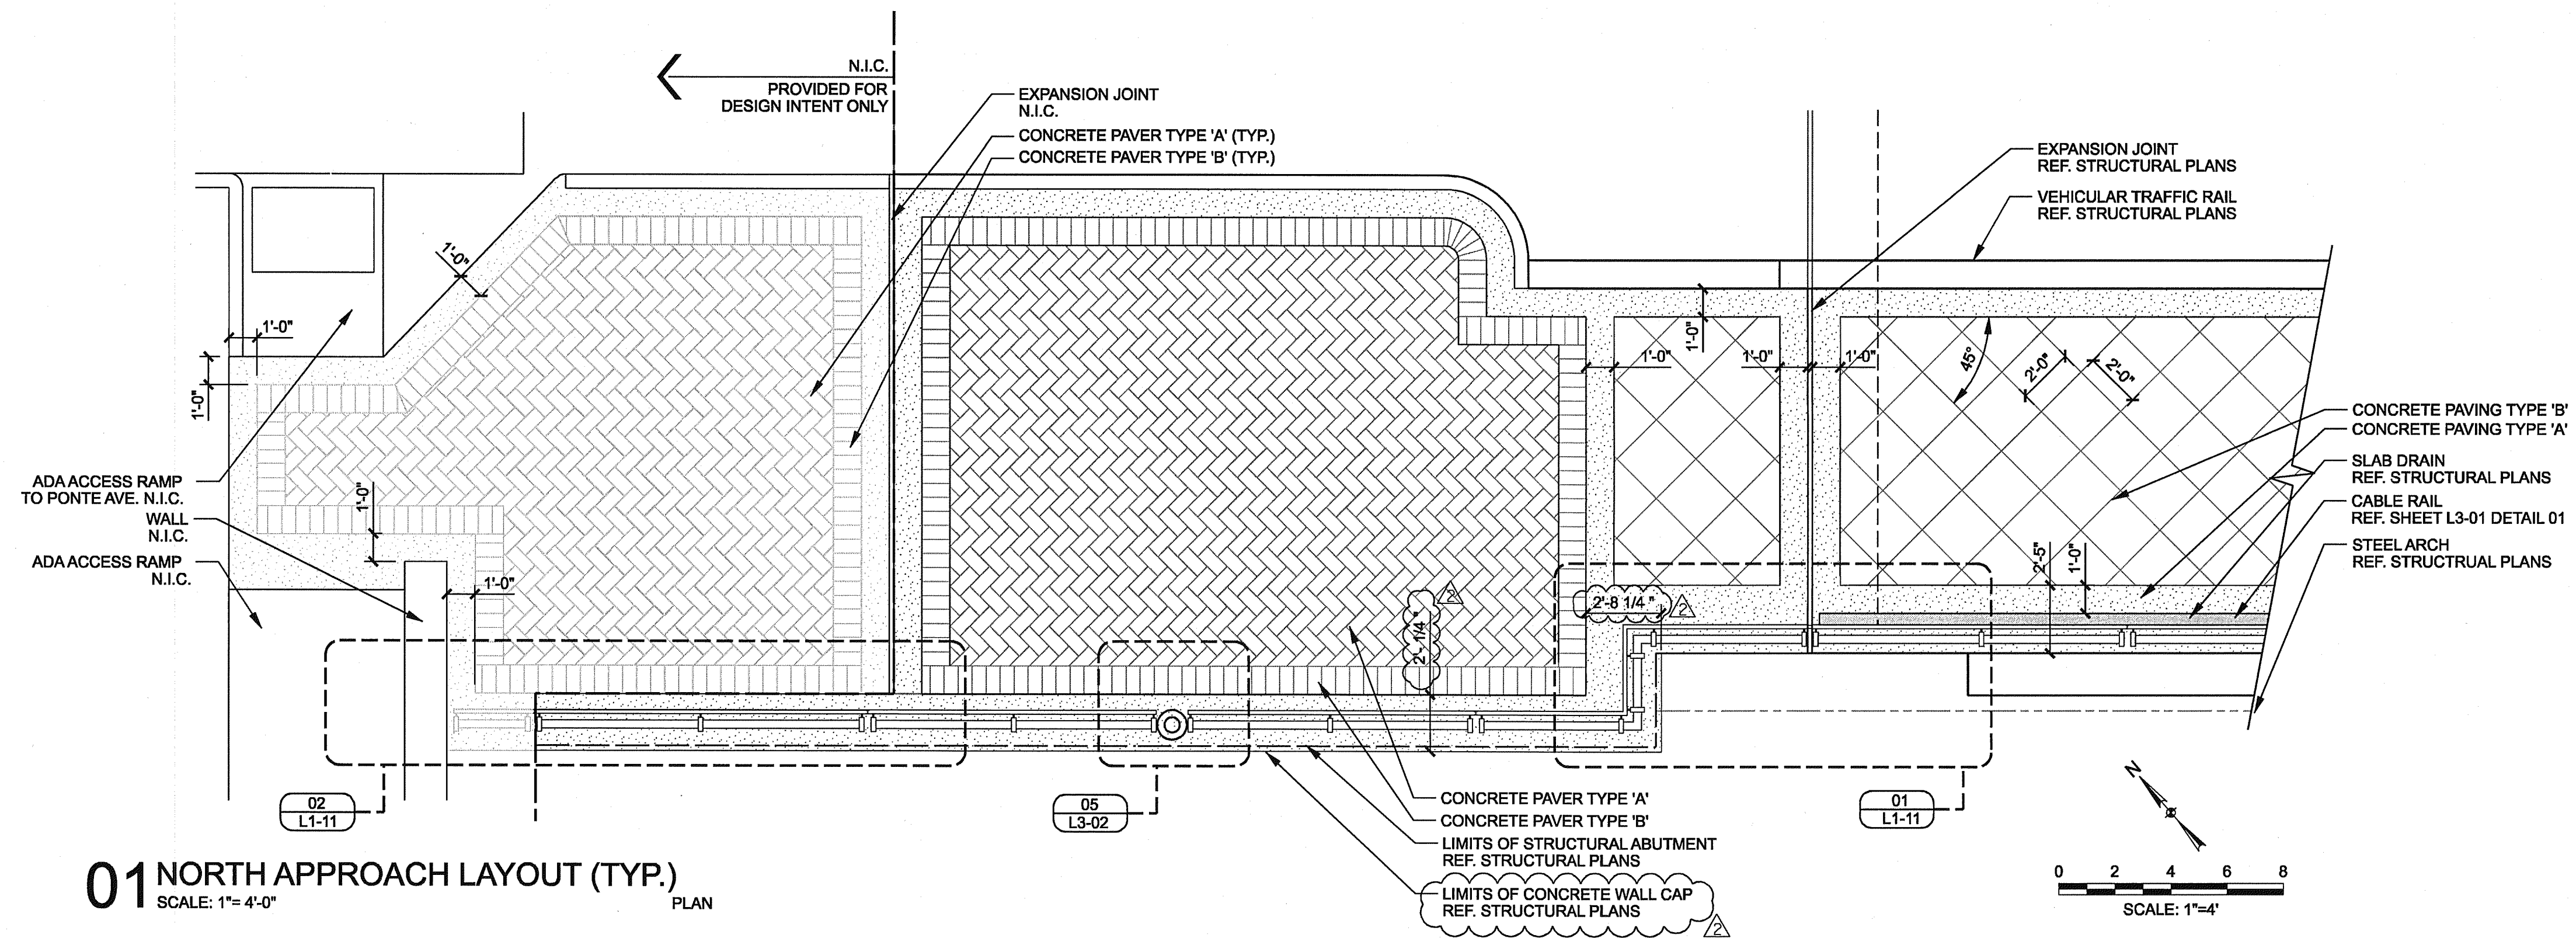

01 NORTH APPROACH LAYOUT (TYP.)
SCALE: 1"= 4'-0"
PLAN

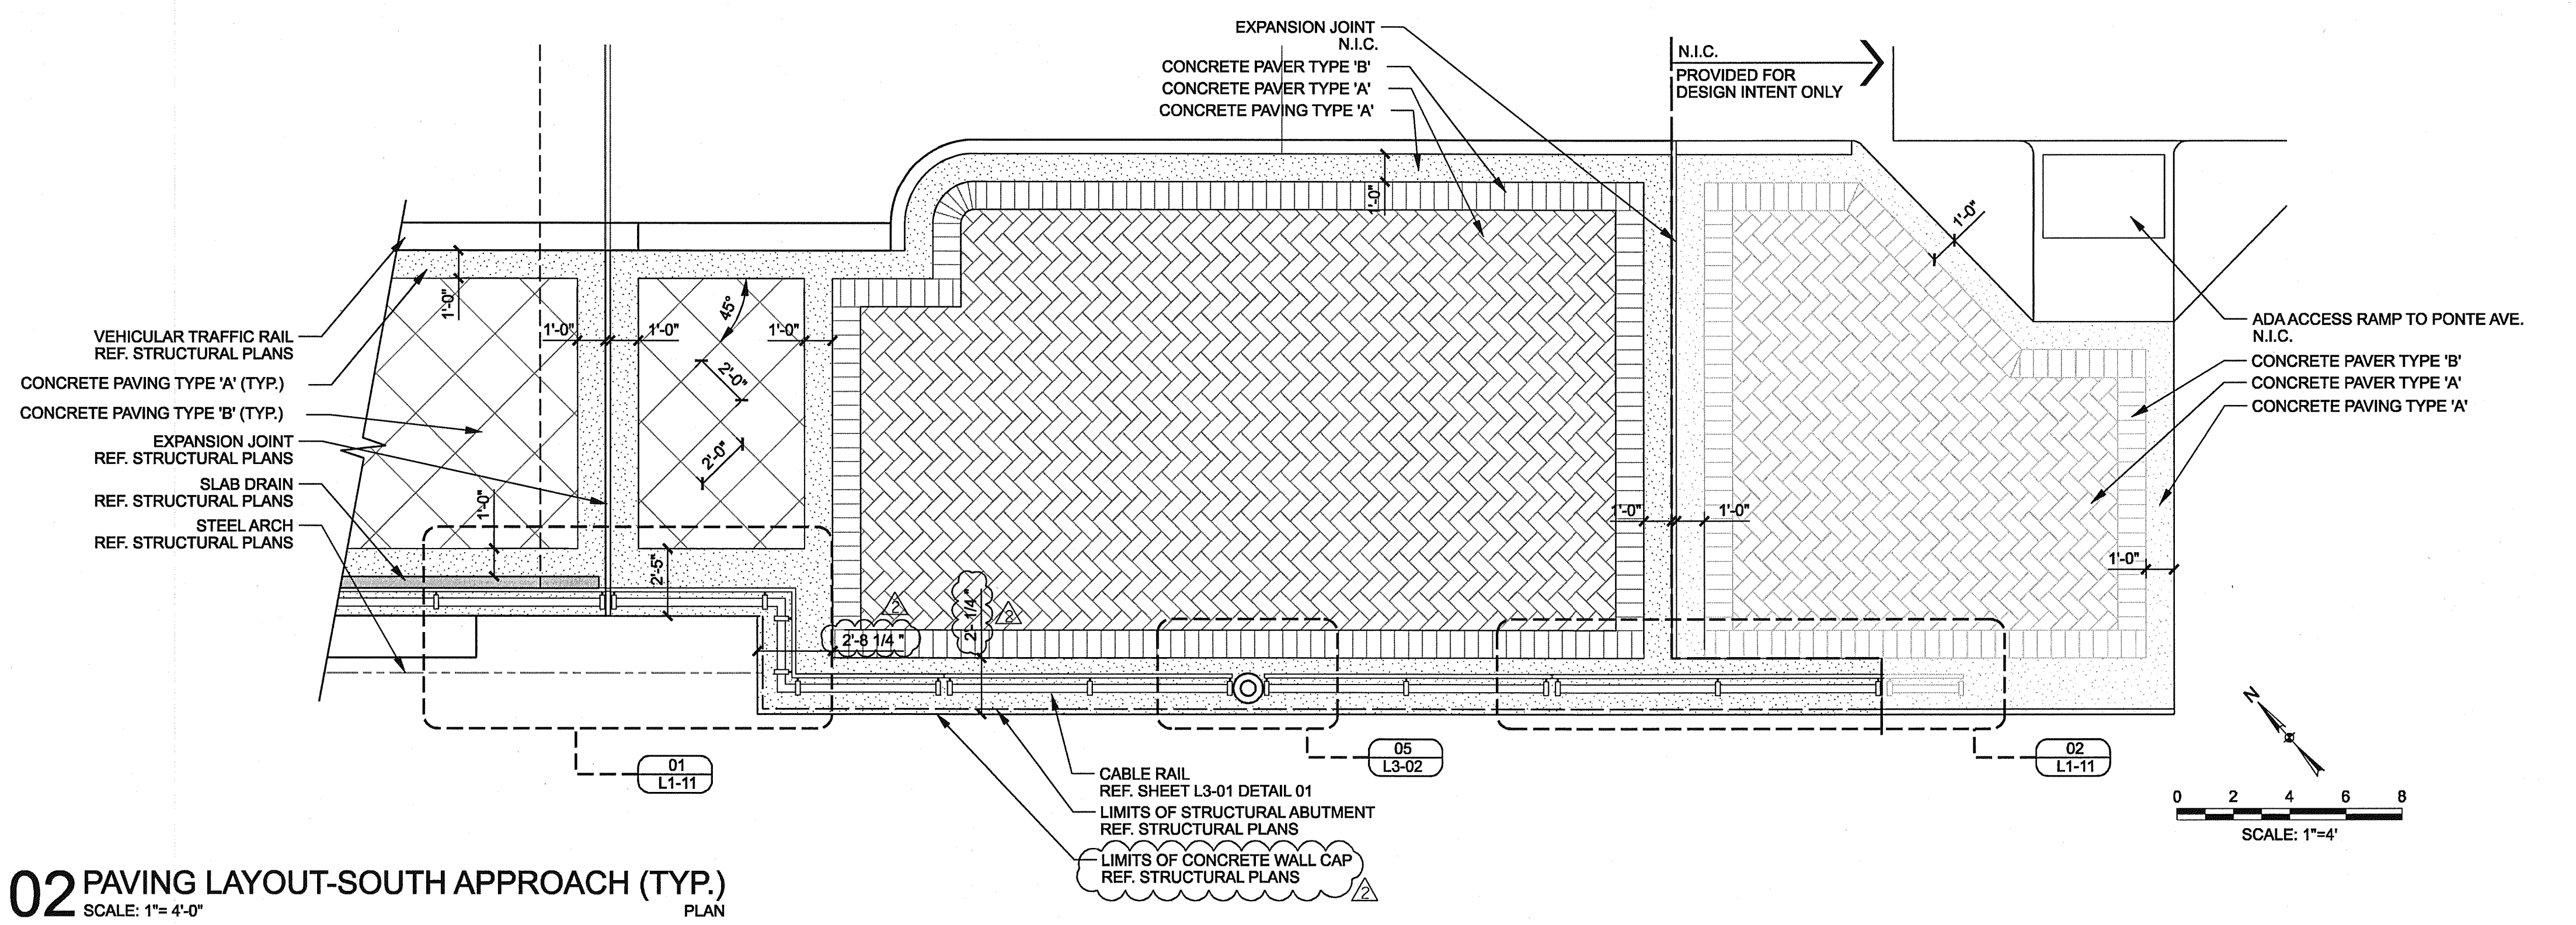

02 PAVING LAYOUT-SOUTH APPROACH (TYP.)
SCALE: 1"= 4'-0"
PLAN