




BARS E

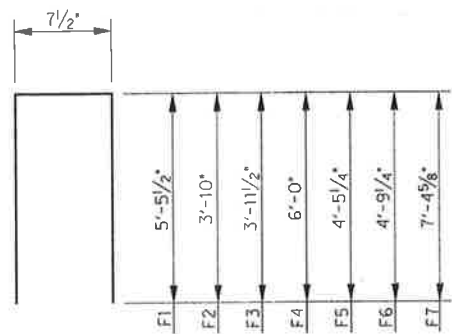


BARS F

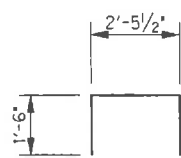


BARS eU

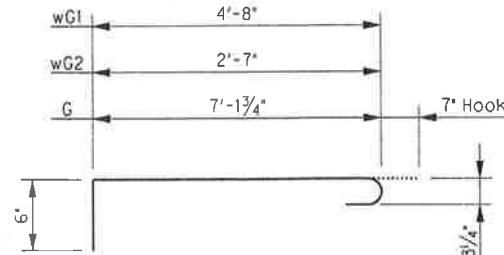


BARS G & wG

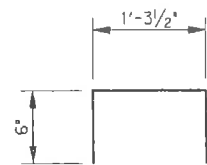


BARS wC

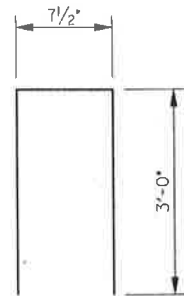


BARS V

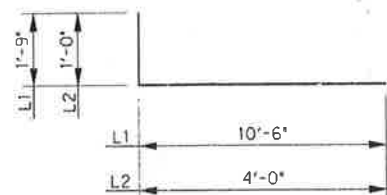



BARS L

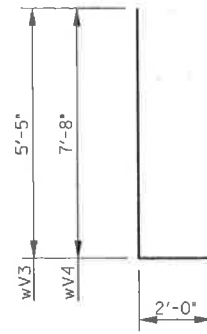

BARS wV3 & wV4

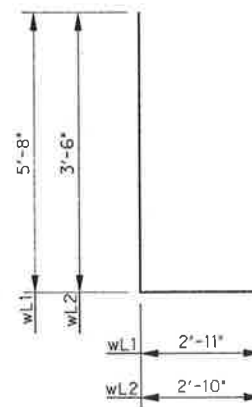


BARS wL

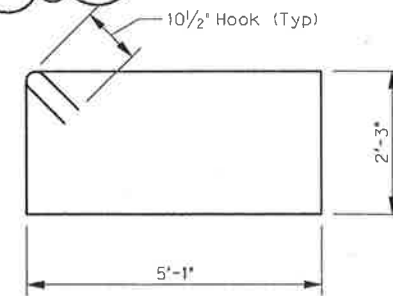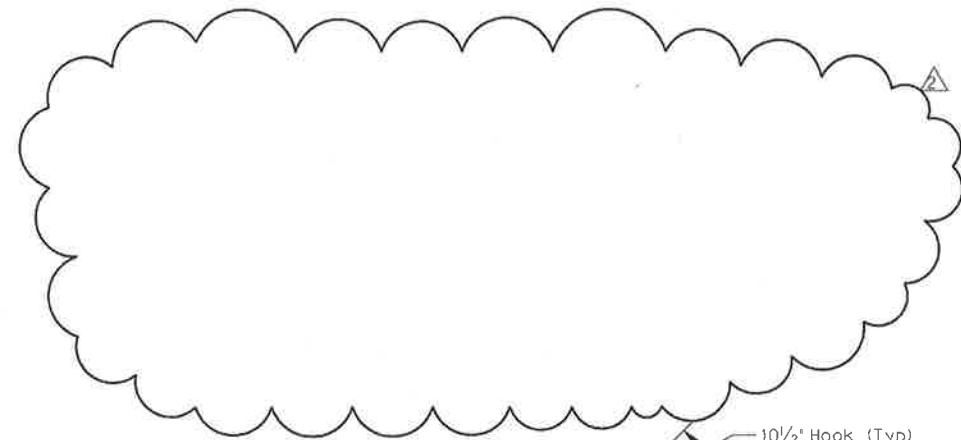


BARS wS1




THE SEAL APPEARING ON THIS DOCUMENT WAS AUTHORIZED BY ERIC S. CHRISTIANSEN, P.E. #85412 ON 05-19-2010. ALTERATION OF A SEALED DOCUMENT WITHOUT PROPER NOTIFICATION TO THE RESPONSIBLE ENGINEER IS AN OFFENSE UNDER THE TEXAS ENGINEERING PRACTICE ACT. THE RECORD COPY OF THIS DRAWING IS ON FILE AT THE OFFICES OF HALFF ASSOCIATES, 1201 NORTH BOWSER ROAD, RICHARDSON, TEXAS, 75081, PHONE 972-312-1100.

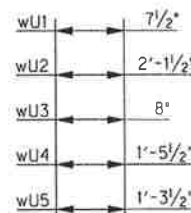


BARS wU

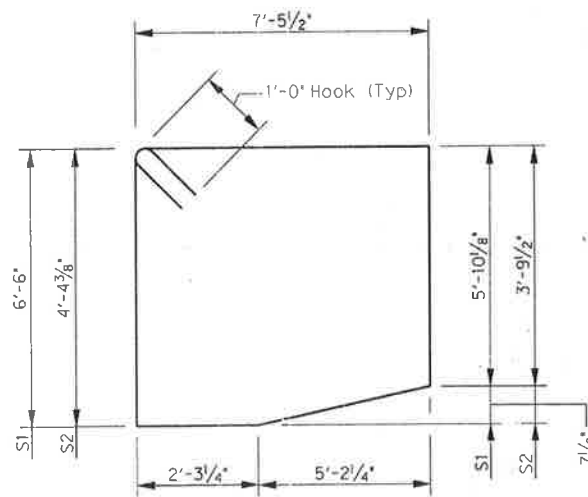


BARS S

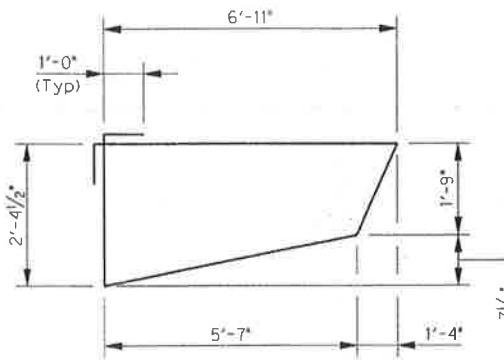


BARS M

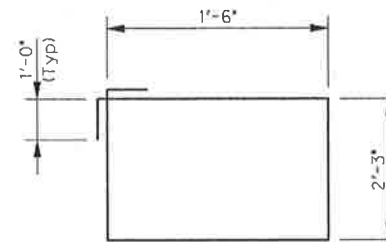


BARS wS2

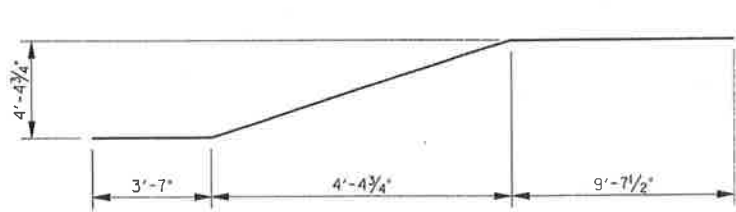


BARS wZ

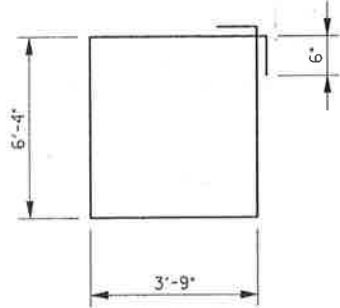

BARS eS

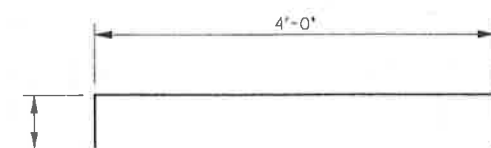

BARS eH1

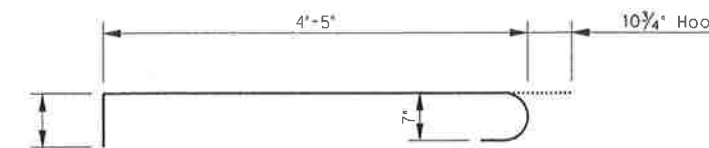

BARS eH2

Addendum #2		ESC	05/19/10
NO.	REVISION	BY	DATE
TOWN OF ADDISON DALLAS COUNTY, TEXAS			
VITRUVIAN PARK BRIDGES PONTE AVENUE			
ABUTMENT DETAILS - BAR BENDING DIAGRAMS			
HALFF		1201 NORTH BOWSER ROAD, RICHARDSON, TEXAS 75081-2276	
		TEL (214) 348-0200 FAX (214) 738-0098	
PROJECT	DESIGN	DRAWN	DATE
27379	ESC	AHH	APRIL 2010
FILE	SHEET		
-	S1-13		