

USER: dh2214
 PROJECT # 27379 OFFICE: RCH
 FILE: L221-DT-Bello-27379.dgn
 TIME: 3:53:43 PM
 DATE: 6/22/2010

GENERAL NOTES

1. REF. STRUCTURAL DRAWINGS FOR ALL BRIDGE DIMENSIONS AND COORDINATES.
2. ALL RAILING SHALL BE SPACED AT TYPICAL 10'-0" INCREMENTS AS SHOWN ON SHEET L3-01 UNLESS OTHERWISE NOTED.
3. ALL WALK DIMENSIONS ARE GIVEN FROM BACK OF CURB UNLESS OTHERWISE NOTED.
4. REF. ELECTRICAL DRAWINGS FOR ALL LIGHT FIXTURE TYPES.
5. ALL ITEMS AND APPURTANANCES N.I.C. TO BE COORDINATED BY THE CONTRACTOR PRIOR TO WORK COMMENCEMENT.
6. ALL DIMENSIONS AND ITEM LOCATIONS ARE TO BE MIRRORED ALONG THE BRIDGE CENTERLINE UNLESS OTHERWISE NOTED.
7. AT THE CONTRACTOR'S OPTION, THE STONE VENEER MAY BE INSTALLED AFTER THE ARCH IS FULLY ERECTED. REFER TO THE STRUCTURAL DRAWINGS FOR ADDITIONAL INFORMATION.

DESIGN SELECTION: STRUCTURE

STONE:

BLUE GREEN CHINESE STONE

VENEER THICKNESS: 3 cm
 VENEER HEIGHT: 4"
 VENEER LENGTH: 8", 13" AND 21"
 VENEER FINISH: THERMAL
 VENEER EDGES: ALL FOUR SIDES TO BE SAW CUT
 MORTAR: TO MATCH ON SITE MOCK-UP
 COURSING: TO MATCH ON SITE MOCK-UP

CONCRETE ELEMENTS:

MASK WALL




FINISH: HEAVY SANDBLAST ALL SIDES
 COLOR: NONE

WALL CAP

FINISH: HEAVY SANDBLAST
 COLOR: NONE

STRUCTURE GENERAL NOTES:

1. SEE ON-SITE MOCK-UP FOR ALL REFERENCED CONCRETE AND STONE, COLORS AND TEXTURES. FINAL APPROVAL BY OWNER OR OWNERS REPRESENTATIVE IS REQUIRED PRIOR TO WORK COMMENCEMENT.
2. CONTRACTOR TO PROVIDE A 4' x 4' MOCK-UP OF ALL REFERENCED CONCRETE AND STONE, COLORS AND TEXTURES FOR APPROVAL PRIOR TO WORK COMMENCEMENT.

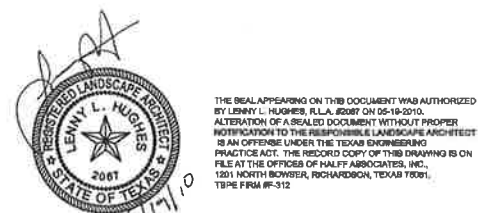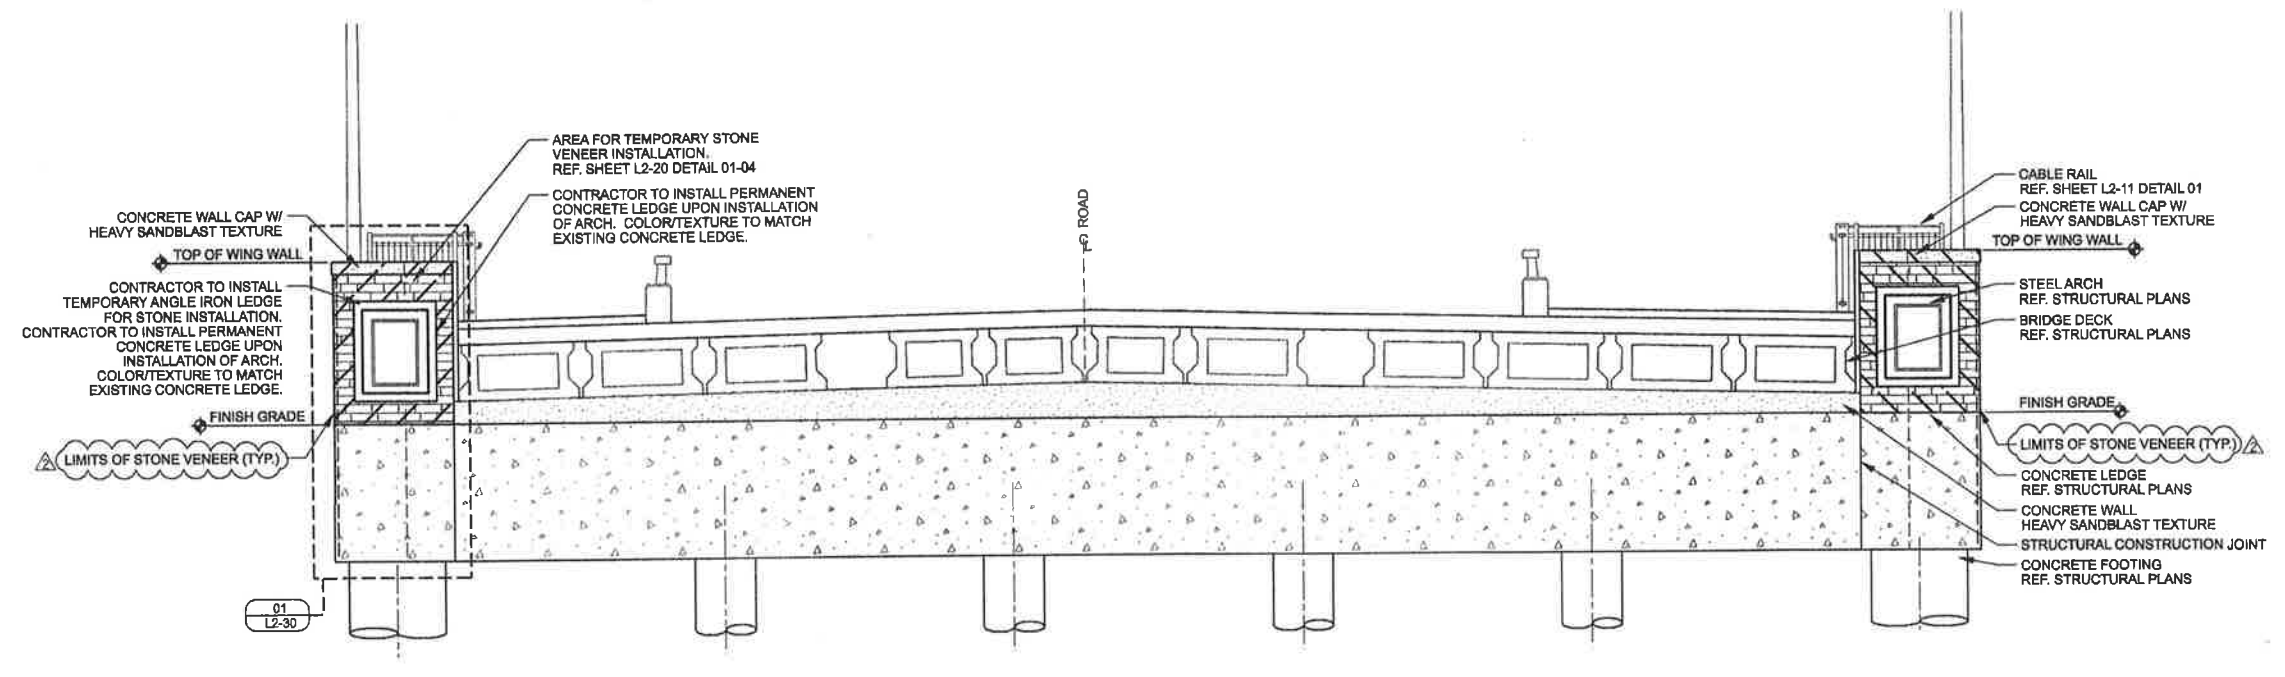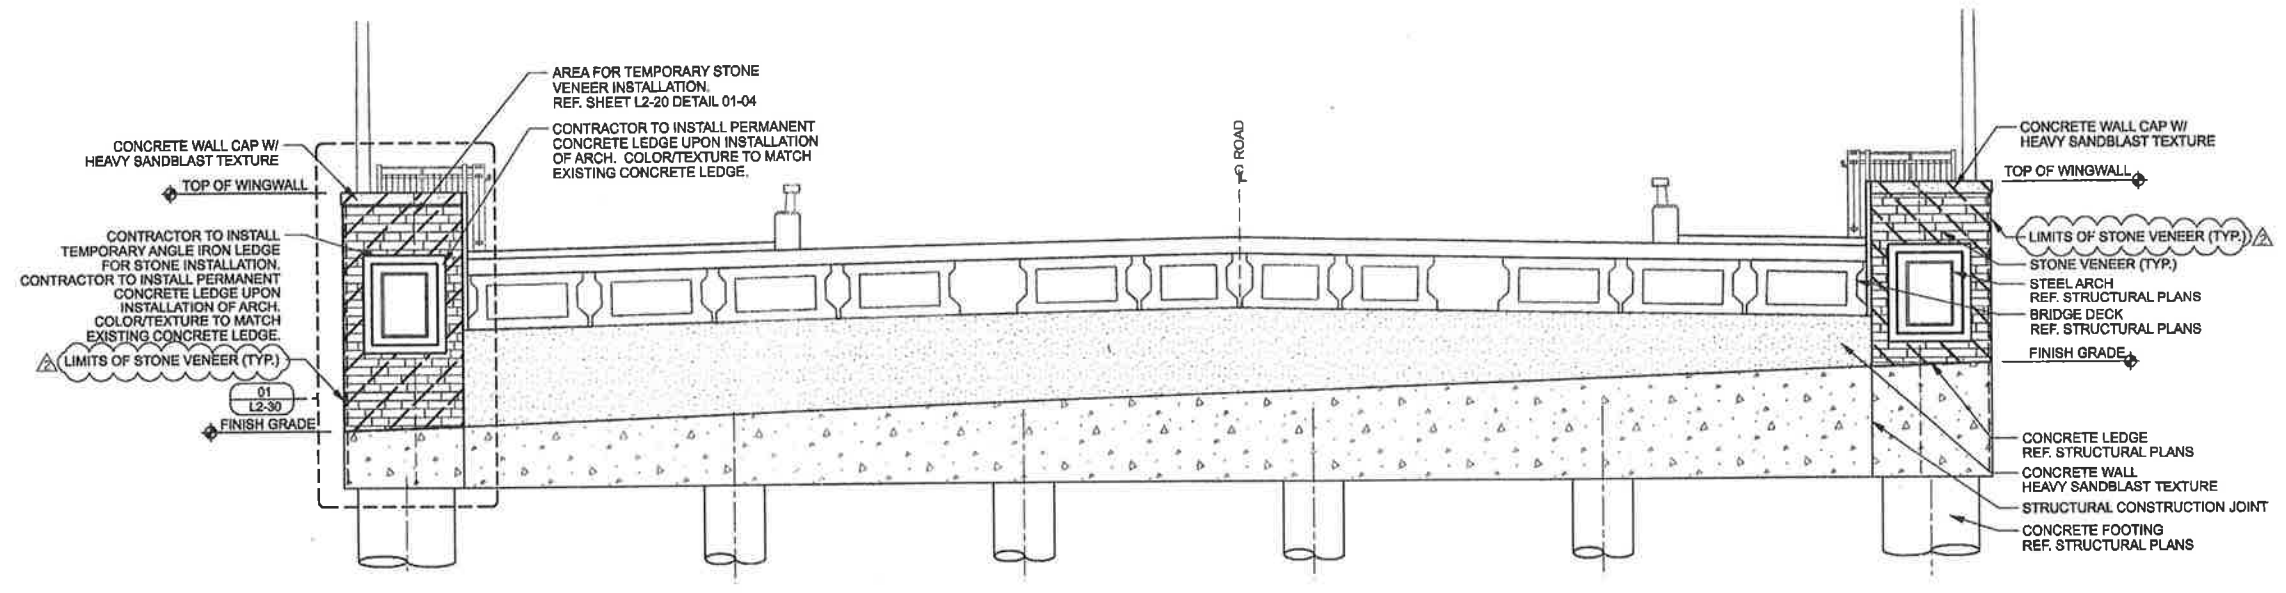

ADDENDUM #2	JDB	05/19/10
ADDENDUM #1	JDB	05/14/10
NO.	REVISION	BY DATE

Addendum TOWN OF ADDISON
 DALLAS COUNTY, TEXAS

VITRUVIAN PARK BRIDGES
 BELLA LANE

ABUTMENT ELEVATIONS

HALFF 1201 NORTH BOWSER ROAD, RICHARDSON, TEXAS 75081-2275
 TEL (214) 346-6200 FAX (214) 739-0065

PROJECT	DESIGN	DRAWN	DATE	FILE	SHEET
27379	JDB	AHH	APRIL 2010	-	L2-21