

PLANS FOR THE CONSTRUCTION OF
PAVING, DRAINAGE & UTILITY IMPROVEMENTS
VITRUVIAN WAY EXTENSION
 FOR
VITRUVIAN PARK PUBLIC INFRASTRUCTURE-PHASE 1E
TOWN OF ADDISON, TEXAS
PUBLIC WORKS # 2010-02



JOE CHOW
MAYOR

DON DASEKE
MAYOR PRO TEMPORE

BLAKE CLEMENS
DEPUTY MAYOR PRO TEMPORE

NEIL RESNIK
ROGER MELLOW
KIMBERLY LAY
BIANCA NOBLE
COUNCIL MEMBERS

RON WHITEHEAD
CITY MANAGER

LEA DUNN
DEPUTY CITY MANAGER

NANCY CLINE, P.E.
DIRECTOR OF PUBLIC WORKS

CLAY BARNETT, P.E.
TOWN ENGINEER

CIVIL ENGINEER:

ICON CONSULTING ENGINEERS, INC.
250 W. SOUTHLAKE BLVD., SUITE 117
SOUTHLAKE, TEXAS 76092
PH: (817) 552-6210
FAX: (817) 552-3126
CONTACT: BRUCE F. DUNNE, P.E.

ELECTRICAL ENGINEER


SCARBOROUGH ENGINEERING, INC.
2400 SCOTT AVENUE
FORT WORTH, TEXAS 76103
PH: (817) 451-6687
FAX: (817) 451-0476
CONTACT: JON D. SCARBOROUGH, P.E.

SURVEYOR:

KADLECK & ASSOCIATES
555 REPUBLIC DRIVE, SUITE 115
PLANO, TEXAS, 75074
PH: (972) 881-0771
FAX: (972) 509-1861
CONTACT: LYNN KADLECK, R.P.L.S.

LANDSCAPE ARCHITECT:

MESA DESIGN GROUP
1807 ROSS AVENUE, SUITE 333
PLANO, TEXAS, 75201
PH: (214) 871-4418
FAX: (214) 871-1507
CONTACT: BRAD GOODMAN, LEED, AP

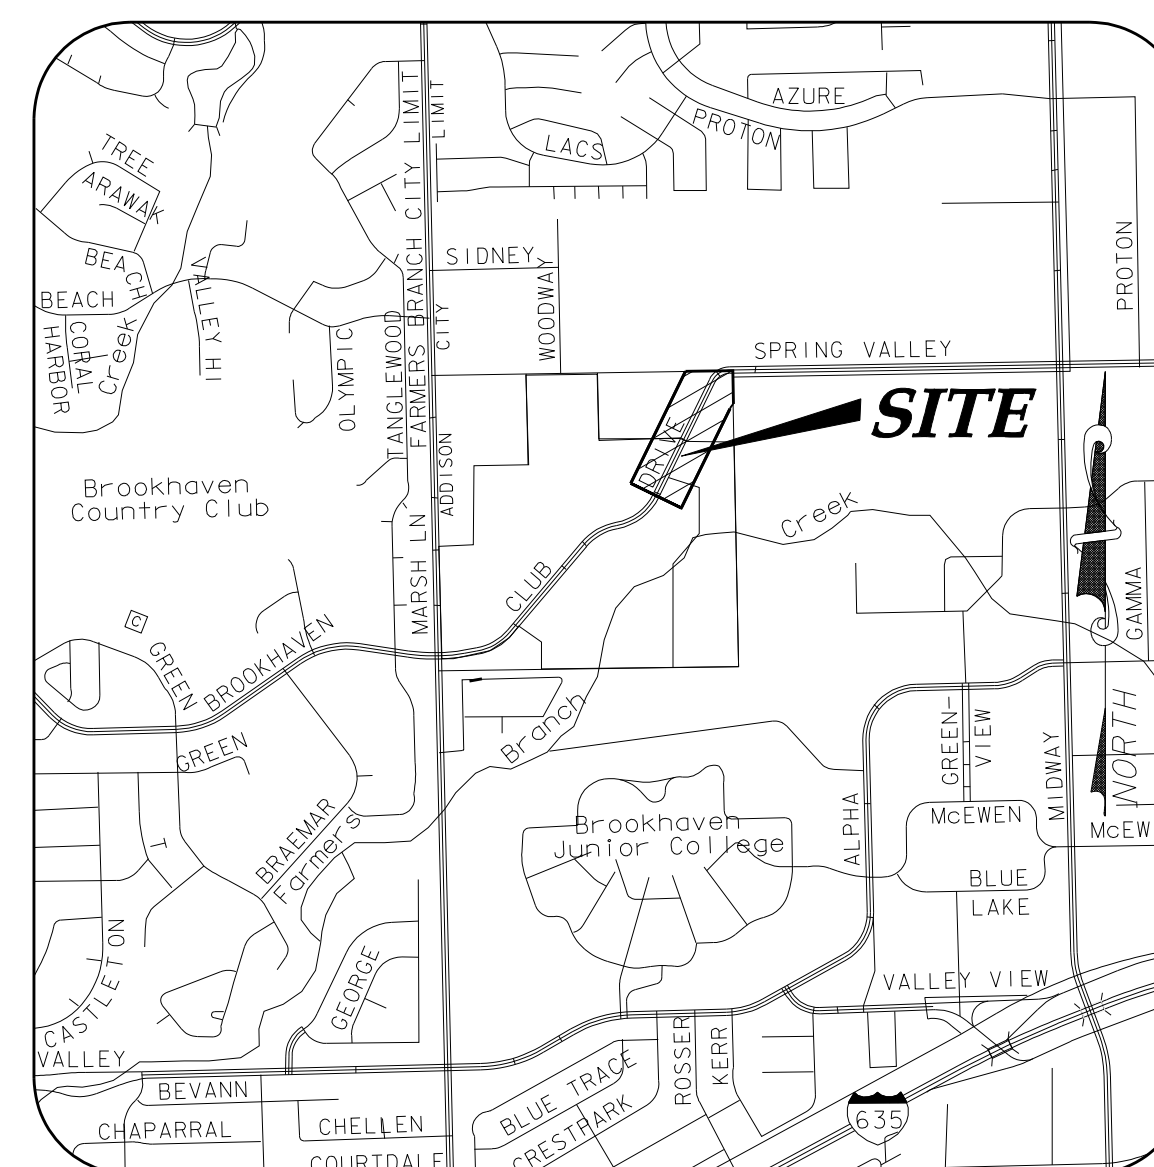

VICINITY MAP

NOT TO SCALE
(MAPSCO GRID 13 & 14)

INDEX OF SHEETS

CS	COVER SHEET
1	OVERALL PLAN & PROJECT CONTROL
2	GENERAL CONSTRUCTION NOTES, LEGEND & ABBREVIATIONS
3	DEMOLITION PLAN - VW
4	OVERALL PAVING LAYOUT & NOTES
5	PAVING PLAN & PROFILE - VW
6	PAVEMENT SECTIONS
7	PAVING DETAILS
8	PAVING DETAILS
9	DRAINAGE AREA MAP & CALCULATIONS
10	STORM DRAIN PLAN & PROFILE - VW
11	STORM DRAIN DETAILS
12	STORM DRAIN DETAILS & GENERAL NOTES
13	PAVEMENT MARKING & SIGNAGE PLAN - VW
14	PAVEMENT MARKING & SIGNAGE DETAILS
15	STREET LIGHT & CONDUIT PLAN - VW
16	STREET LIGHT DETAILS
17	ELECTRICAL DETAILS - CONDUIT ED(1)-03
18	ELECTRICAL DETAILS - CONDUCTORS ED(2)-03
19	ELECTRICAL DETAILS - GROUND BOXES ED(3)-03
20	OVERALL WATER & SEWER LAYOUT & GENERAL NOTES
21	WATER LINE PLAN & PROFILE - VW
22	WATER LINE CROSSING PROFILES
23	WATER DETAILS
24	WATER DETAILS
25	SANITARY SEWER PLAN & PROFILE - VW
26	SANITARY SEWER DETAILS
27	OVERALL DUCT BANK LAYOUT & NOTES
28	DUCT BANK PLAN & PROFILE - VW
29	DUCT BANK CROSSING PROFILES
30	ELECTRICAL DUCT BANK DETAILS
31	EROSION & SEDIMENT CONTROL PLAN
32	EROSION & SEDIMENT CONTROL DETAILS
5.01	PLANTING LAYOUT PLAN
5.02	PLANTING DETAILS AND NOTES
6.01	IRRIGATION LAYOUT PLAN
6.02	IRRIGATION TREE LAYOUT PLAN
6.03	IRRIGATION DETAILS AND NOTES

icon Consulting Engineers, Inc.
Civil Engineers- Designers- Planners
ENGINEERING FIRM REGISTRATION NUMBER F-9007

OCTOBER 01, 2010



ICON PROJECT #5029-01

RECORD DRAWINGS 06/13/12