


RCP STORM SEWER PIPE BEDDING

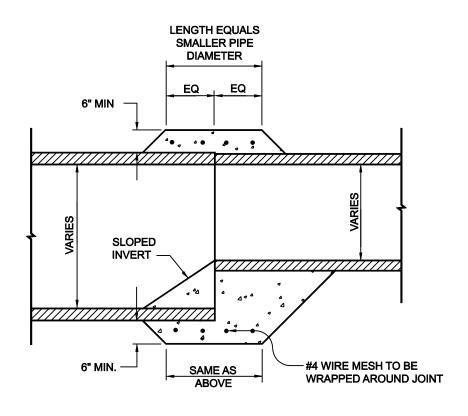

PIPE COLLAR DETAIL

NOTES

- 1. THIS PROCEDURE/DETAIL WILL ONLY BE USED WHEN 1 PREFAB REDUCTION IS NOT POSSIBLE.
- 2. CONCRETE FOR COLLAR WILL NOT BE PAID FOR DIRECTLY, BUT
- WILL BE CONSIDERED SUBSIDIARY TO THE VARIOUS OTHER BIDS. 3. CONCRETE SHALL BE 5 SACK 3000 PSI.

GENERAL NOTES

- 1. ALL CONCRETE DRAINAGE STRUCTURES SHALL HAVE A MINIMUM COMPRESSED STRENGTH OF 3600 P.S.I.
- 2. ALL CRUSHED STONE SHALL BE 3/4", PASSING #4 SIEVE.
- 3. ALL FIELD JOINTS WILL BE APPROVED BY THE CITY ENGINEER IF NECESSARY. FIELD JOINTS SHALL BE WIPED ON THE INSIDE AND OUTSIDE TO PROVIDE FOR SMOOTH FLOW OF WATER.
- 4. RAMNECK COMPOUND OR APPROVED EQUAL SHALL BE USED FOR JOINT SEALS.
- 5. ALL STORM SEWER PIPE SHALL BE CAMERA INSPECTED AFTER THE INSTALLATION OF ALL PAVING, UTILITIES, AND PRIOR TO FINAL ACCEPTANCE OF THE PROJECT.



NO. REVISION					BY	DATE
Hison! TOWN OF ADDISON DALLAS COUNTY, TEXAS						
PAVING, DRAINAGE & UTILITY IMPROVEMENTS VITRUVIAN WAY EXTENSION						
STORM DRAIN DETAILS						
Consulting Engineers, Inc.250 W. Southlake Blvd., Suite 117Civil Engineers - Designers - PlannersSouthlake, Tx 76092 (817) 552-6210						
PROJECT	DESIGN	DRAWN	DATE	FILE	SI	НЕЕТ
5029-01	ICE	ICE	OCT 01 2010	PW# 2010-02		11

RECORD DRAWINGS 06/13/12