




P.C.

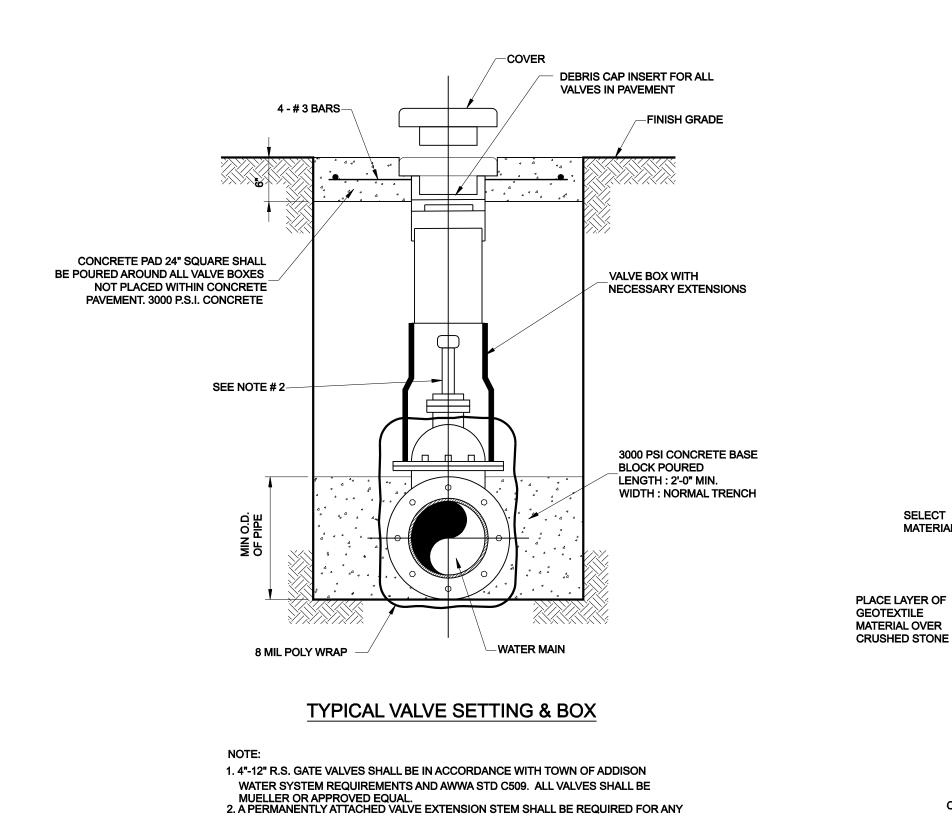

- VALVE THATS OPERATING NUT IS LOCATED IN EXCESS OF 5 FEET BELOW THE TOP OF VALVE BOX. THIS EXTENSION SHALL BE OF SUFFICIENT LENGTH TO INSURE THAT ITS TOP IS WITHIN 5 FEET OF VALVE BOX LID.
- 3. BLUE DOT (3") ON NEAREST CURB FACE TO VALVE.
- 4. ALL IRON MATERIALS SHALL BE DOMESTIC.

CRUSHED STONE SHALL BE 3/4", PASSING # 4 SIEVE

CLASS "B+" EMBEDMENT TYPICAL BACKFILL WATER MAIN P.V.C. WATER PIPE

TRENCH WIDTH – 16" + O.D. MIN. –

24" + O.D. MAX.

O. D.

CRUSHED STONE


(GRADE 4)

SELECT


MATERIAL

-

3" MIN. 6" MIN.

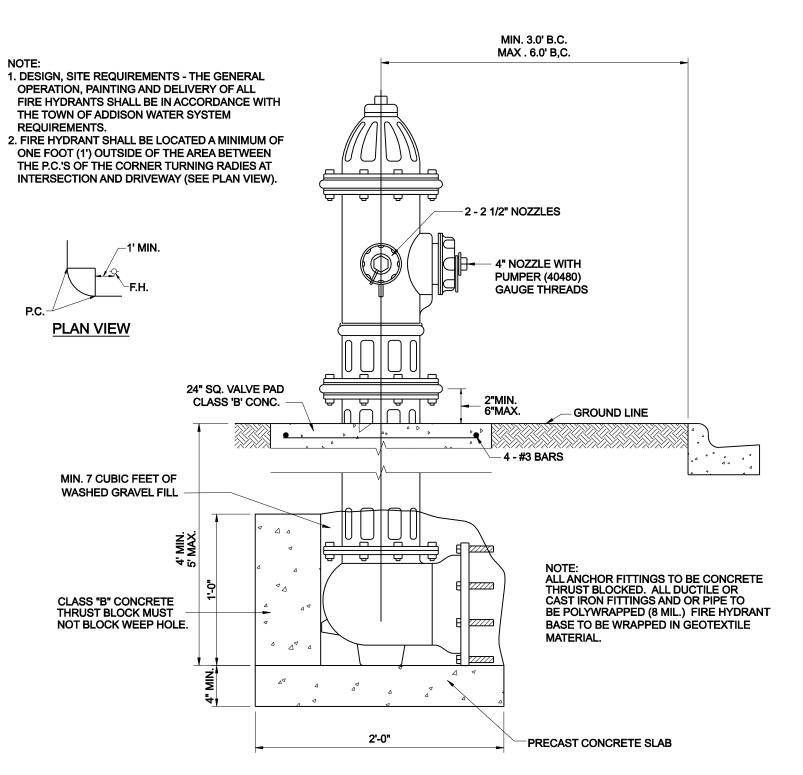

**TYPICAL FIRE HYDRANT INSTALLATION** 

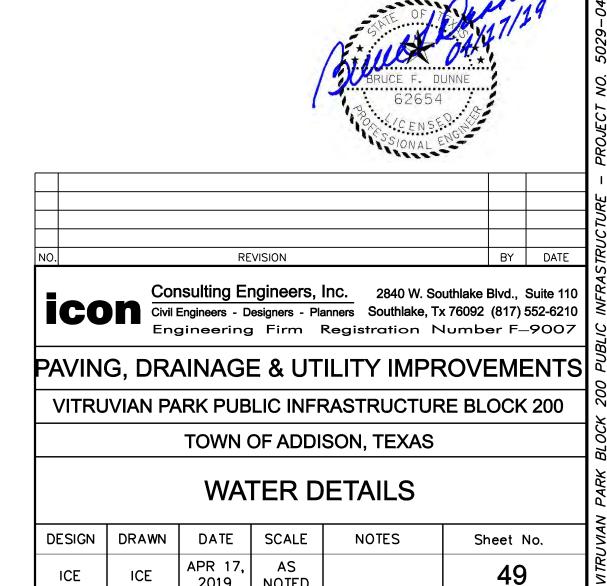

AS-BUILT / RECORD DRAWINGS

2019

NOTED

**TOWN PROJECT # 2016-09**