




1 FOUNTAIN SECTION
3/8" = 1'-0"

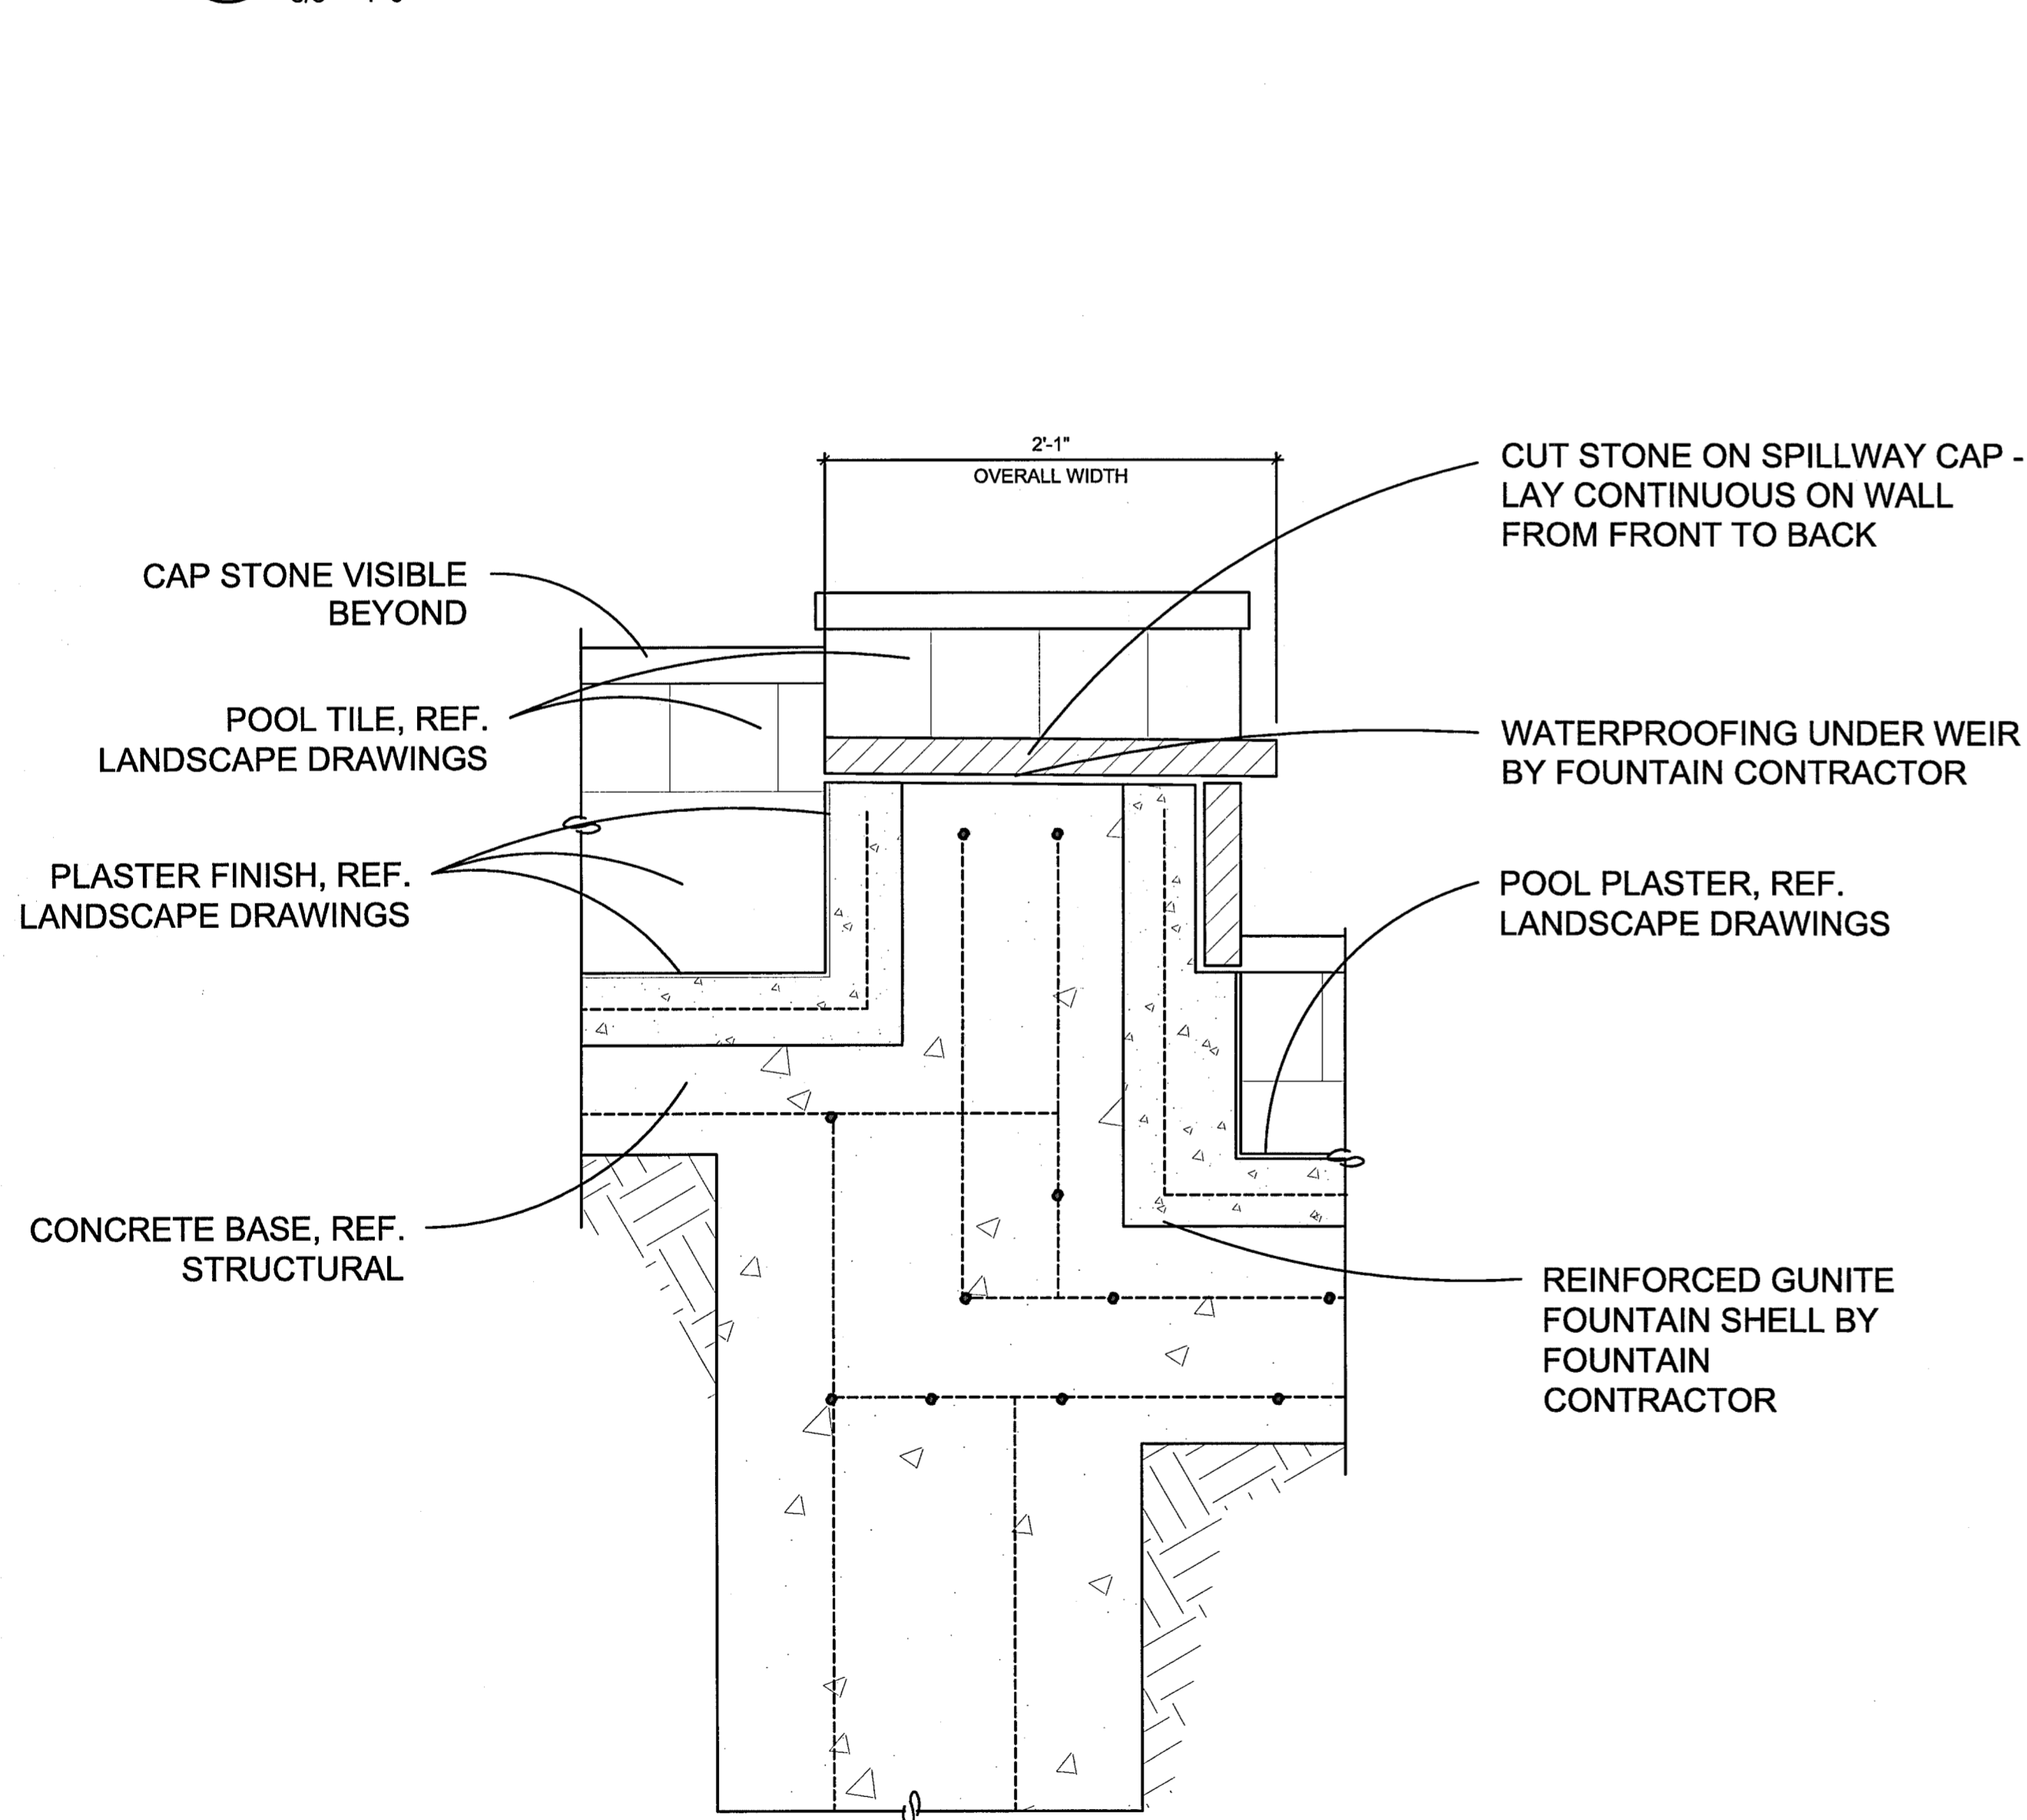

2 SECTION DETAIL - FOUNTAIN WALL
1-1/2" = 1'-0"

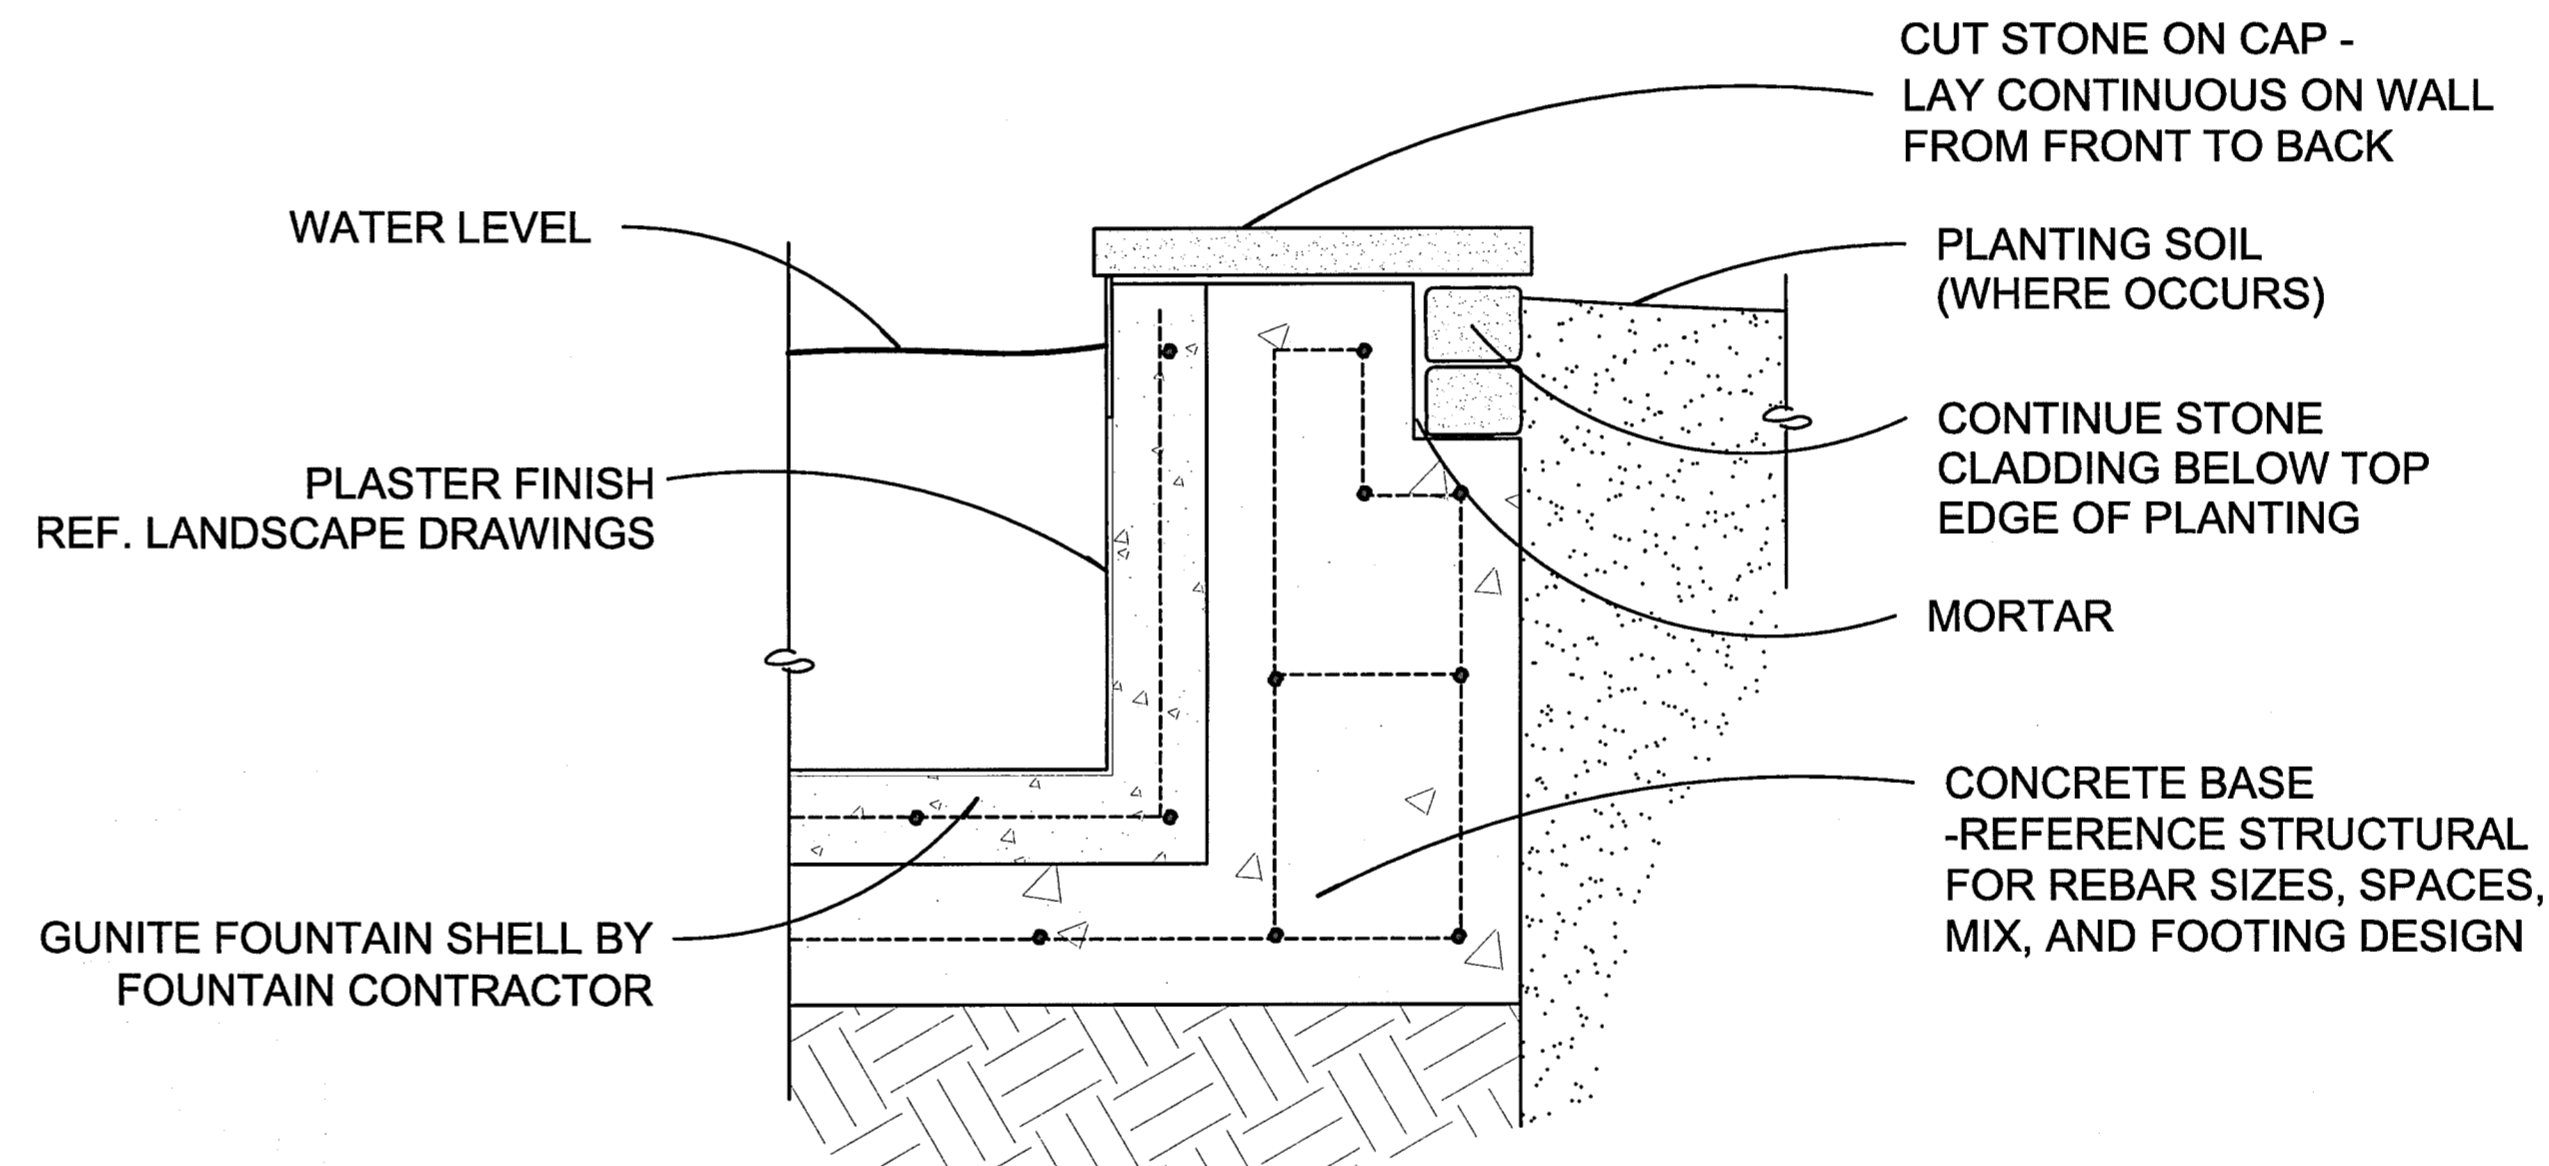

3 SECTION DETAIL - FOUNTAIN WALL
1-1/2" = 1'-0"

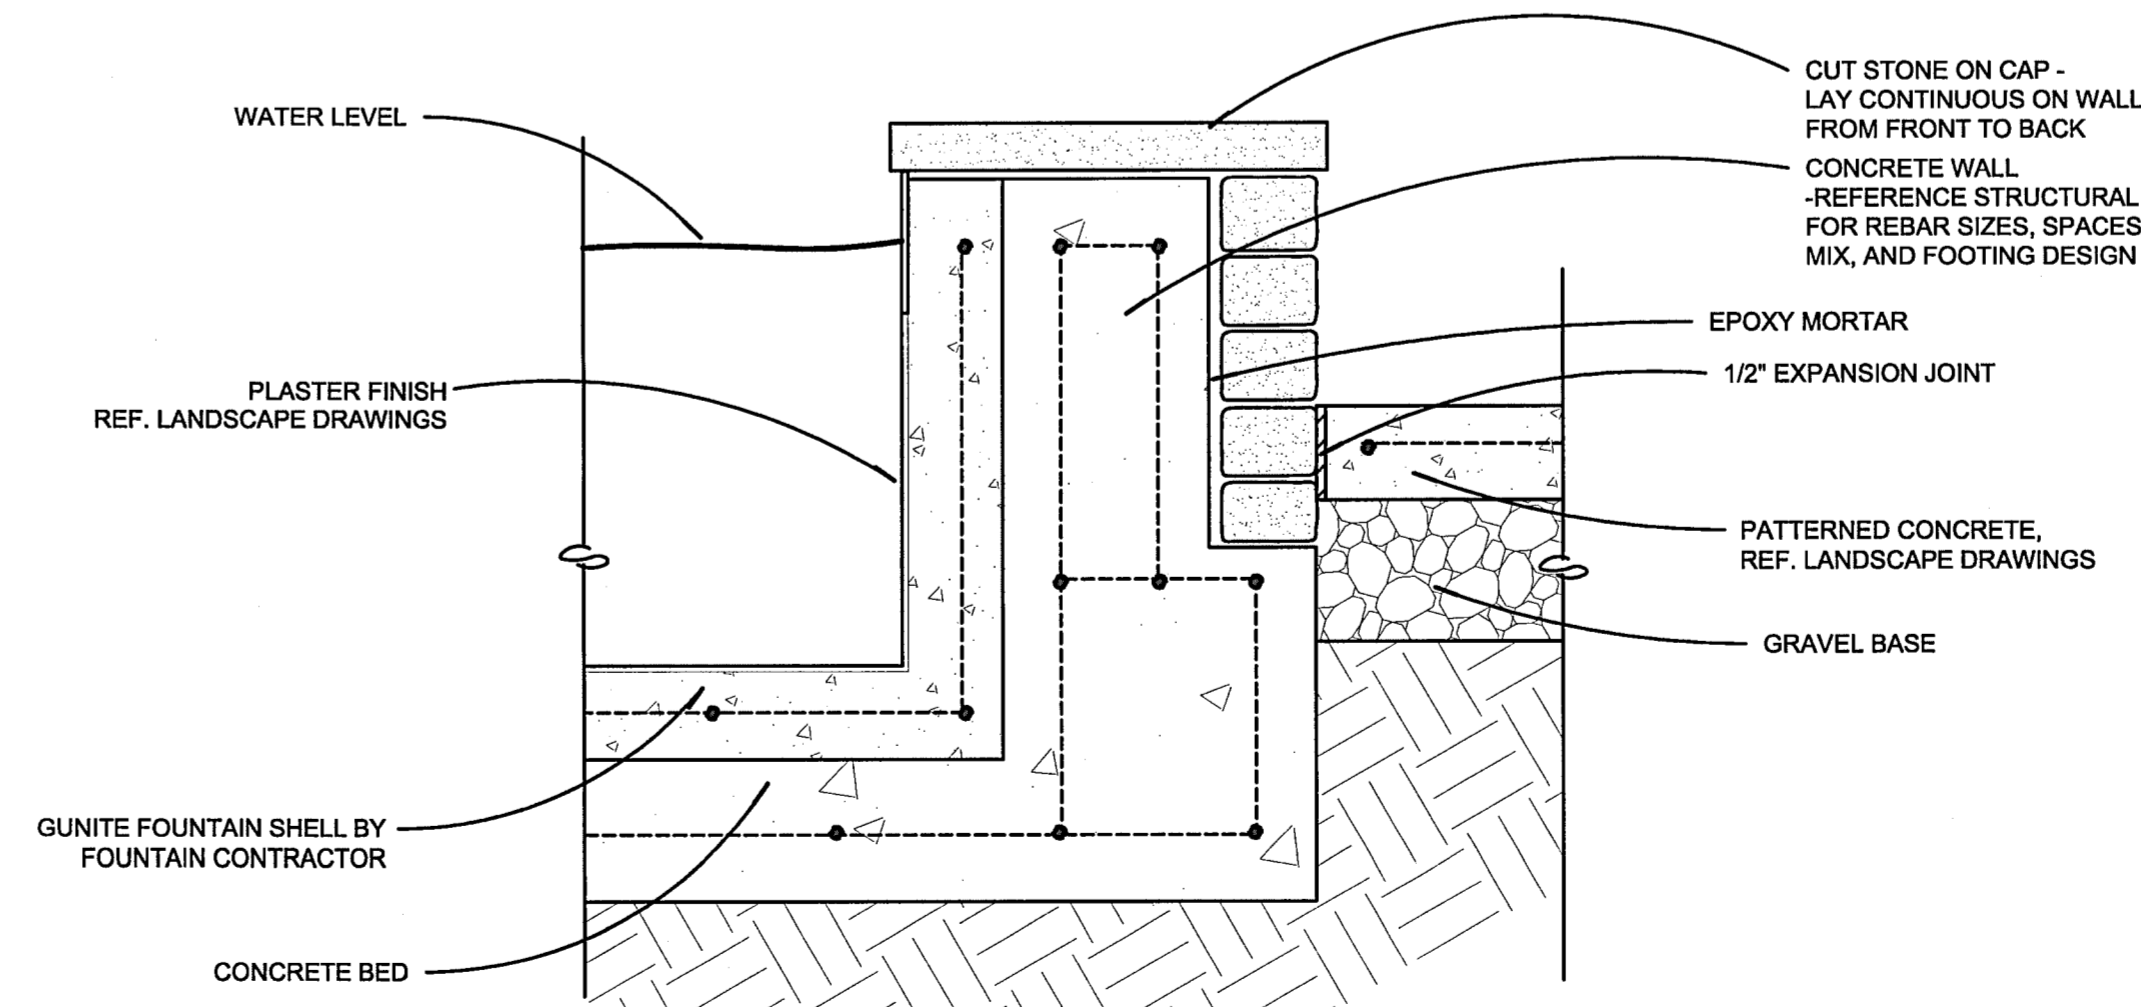

4 SECTION DETAIL - FOUNTAIN WALL
1-1/2" = 1'-0"

- MODIFICATION MADE TO DRAWINGS PROVIDED BY LRK ON 6/18/10.**
1. MODIFIED WALL HEIGHTS TO MATCH CURRENT LANDSCAPE DRAWINGS.
 2. MODIFIED WALL CLADDING THICKNESS.
 3. MODIFIED PATTERNED CONCRETE CALL OUT TO REFERENCE LANDSCAPE DRAWINGS.
 4. ADDED LIGHT ENCLOSURE TO GUNITE STRUCTURE ABOVE WEIR TO READ POOL TILE.
 5. MODIFIED NOTE REGARDING SMOOTH STUCCO FINISH ABOVE WEIR TO READ POOL TILE.
 6. MODIFIED NOTE REGARDING WATERPROOFING UNDER WEIR STONE TO READ BY FOUNTAIN CONTRACTOR
 7. REPLACED 4" CONCRETE HEAD BANDL WITH STONE LEDGE