




SANITARY SEWER SERVICE CONNECTION

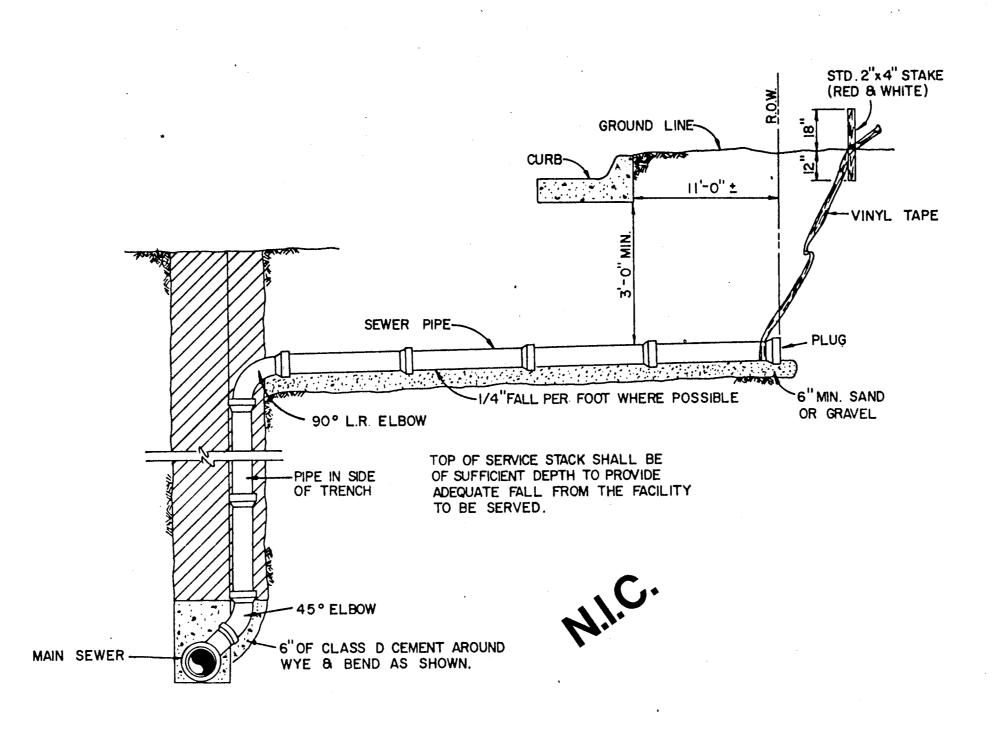

SANITARY SEWER DEEP SERVICE CONNECTION

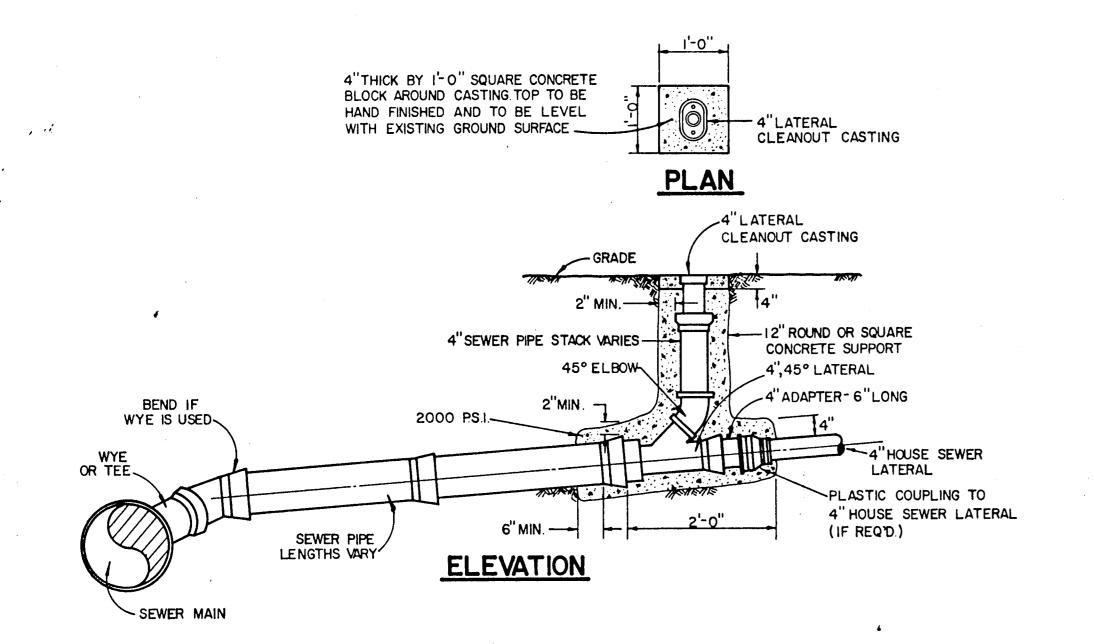


ALL PVC SANITARY SEWER PIPE TO BE SDR 35 WITH INTEGRAL BELL.
IT SHALL BE THE RESPONSIBILITY OF THE CONTRACTOR TO FIELD LOCATE
HORIZONTALLY EACH 4" SERVICE IN RELATION TO THE SANITARY SEWER STATIONING.
FIELD TIES ARE TO BE INCLUDED AND RECORDED ON ALUMINIZED SANITARY SEWER
TAPE. THIS TAPE, GREEN OR RED IN COLOR IS TO BE ATTCHED TO THE 4" SERVICE
AT THE ROW LINE AND BROUGHT TO THE SURFACE TO BE USED AS A PERMANENT MARKER.

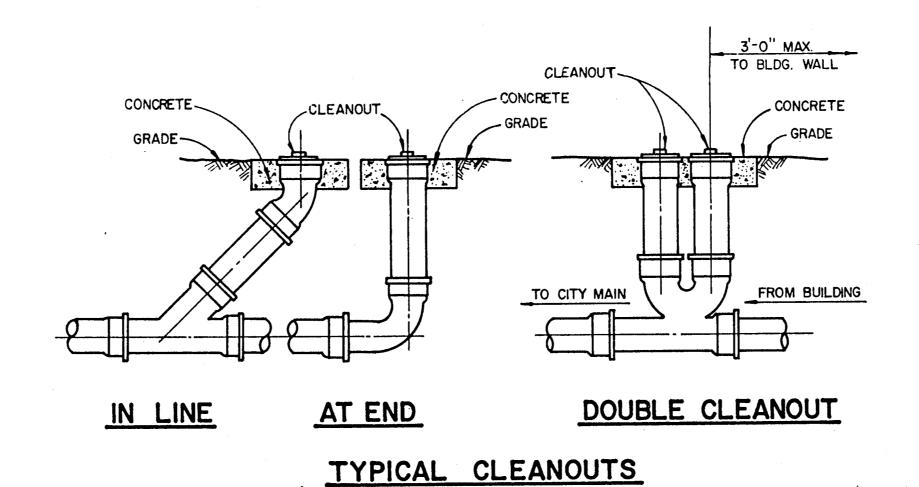

AS BUILTS

I CERTIFY THIS PROJECT WAS CONSTRUCTED IN GENERAL CONFORMANCE WITH THESE CONSTRUCTION PLANS AND WILL FUNCTION AS DESIGNED.

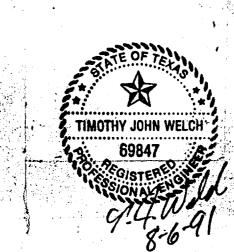

TOWN OF ADDISON, TEXAS

DEPARTMENT OF ENGINEERING

Casting To Be Furnished & Installed By Contractor.

SANITARY SEWER LATERAL REPLACEMENT

Cleanout To Be Installed On Property Line Except

As Required To Avoid Conflict With Existing Or Proposed Facilities in Which Case The Location

Compacted As Specified

Sanitary Sewer Laterals And C.O.'s Are To Be Constructed To Clear Existing And Proposed Facilities, Such As Storm

Sewer Mains, Paving, Retaining Walls, Other Utilities, Etc. The Sanitary Sewer Lateral Will Have A Min. Cover Of 4 Below The Proposed Curb Grade At The Property Line.

STANDARD CONSTRUCTION DETAILS
SANITARY SEWER

LATERALS AND CLEANOUTS

gned -	Drawn -	Date - AUGUST, 1991	Job No 90025-5	
roved -	Checked -	Scale -	Sheet D-7 Of	•