


- CONSTRUCTION NOTES
1. REMOVE EXIST. SIDEWALK TO EXPANSION JOINT @ STA. 2+93.1
 2. CONST. NEW SIDEWALK ON 1.00% GRADE FROM 0+05 (EDGE OF EXIST. EAST/WEST WALK) TO 2+50. MATCH EXIST. @ 2+93.1.
 3. FULL 6" CURB FROM END OF FENCE @ 0+07 TO 2+50. TRANSITION FROM FULL 6" CURB TO NO CURB IN 5'.
 4. INSTALL 1'-0" TO 1'-6" HIGH EARTH BERM FROM 0+07 TO 3+25
 5. ADJUST 2 IRRIGATION VALVE BOXES AS REQUIRED.
 6. SOO BERM AND ANY DISTURBED AREAS.
 7. ADJUST ALL SPRINKLER HEADS & CONTROL BOXES. TEST EXISTING SPRINKLER SYSTEM & MARK WITH PIN FLAGS PRIOR TO CONSTRUCTION.

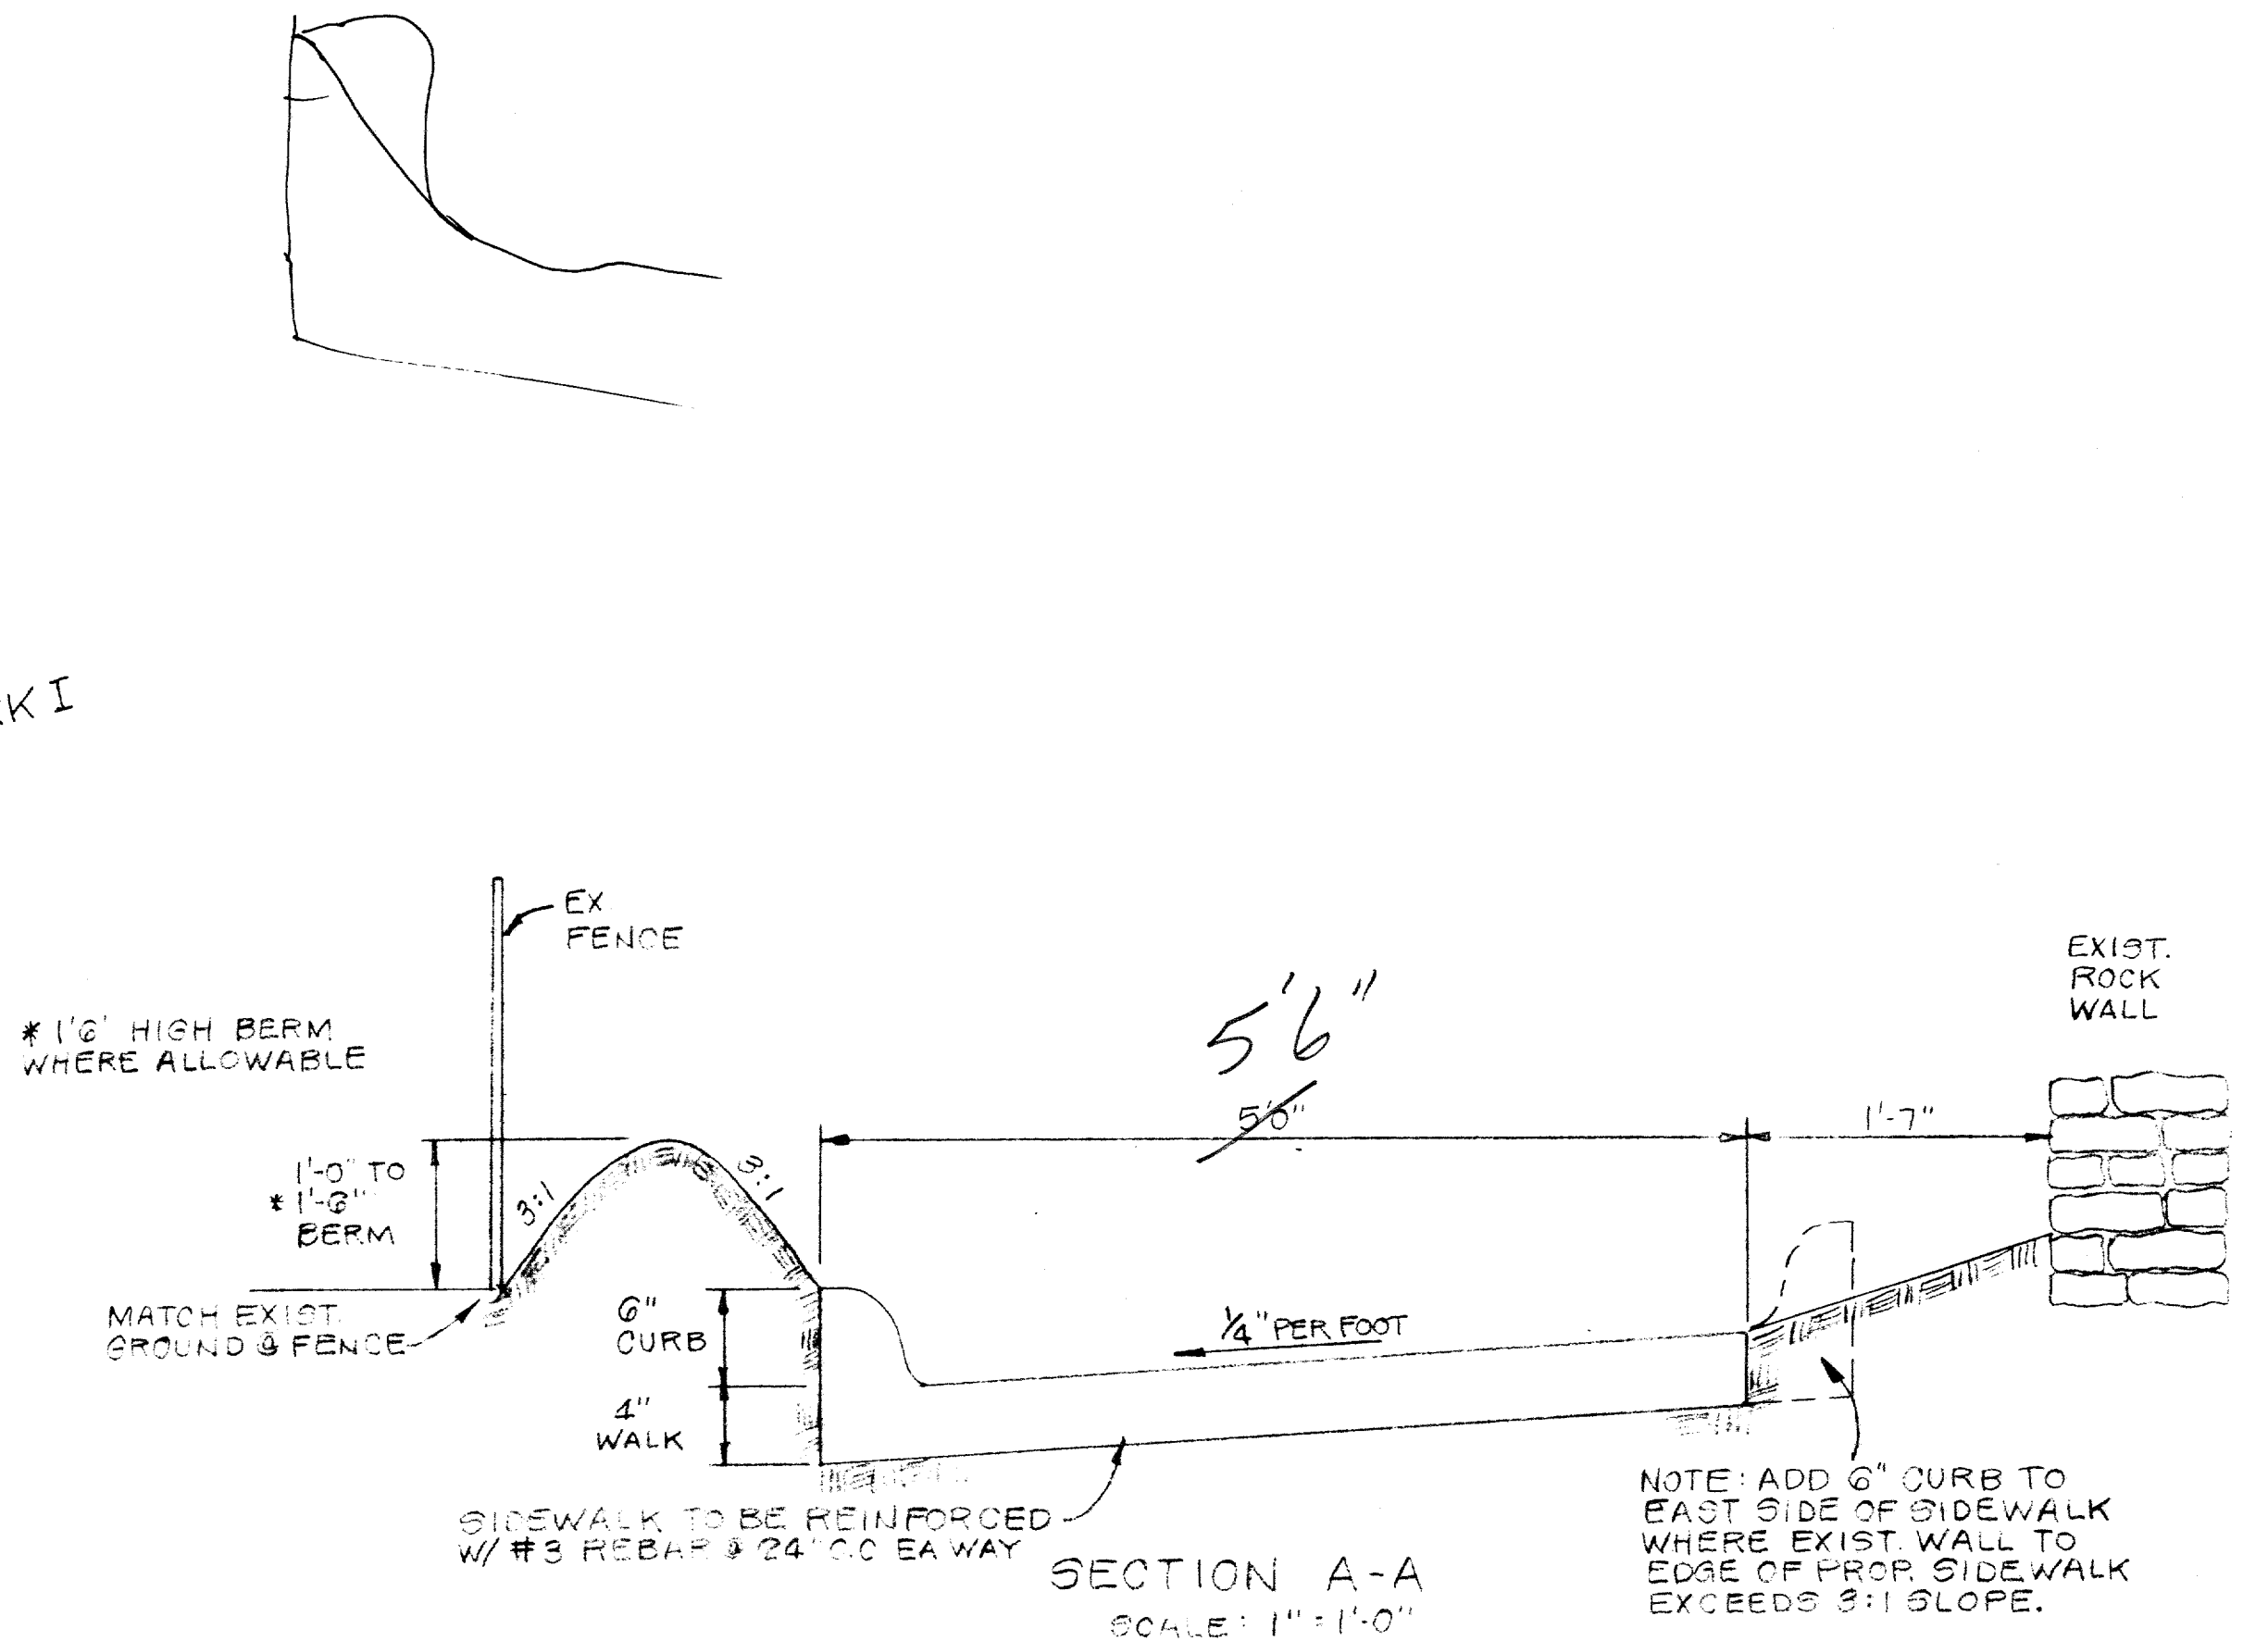

1"=20'
(H.I.=100.00)

DRAINAGE IMPROVEMENT PLAN						
WATERFORD PARK II						
TOWN OF ADDISON						
DALLAS COUNTY, TEXAS						
DOWDEY, ANDERSON & ASSOCIATES, INC.						
16250 DALLAS PKWY (214) 931-0694 DALLAS, TEXAS						
DESIGN	DRAWN	CHECKED	DATE	SCALE	JOB	SHEET
W.A.A.	L.D.B.	W.A.A.	5-2-94	NOTED	93-066	1

NO.	DATE	BY	REVISION