


LINE 'C'

DRAINAGE PROFILE

**WATERFORD PARK II
TOWN OF ADDISON, TEXAS**

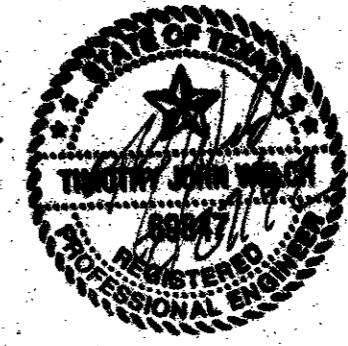

NC THE NELSON CORPORATION
LAND PLANNING • ENGINEERING • SURVEYING
5999 SUMMERSIDE DRIVE • SUITE 202 • DALLAS, TEXAS 75252 • (214) 380-2605

DESIGN	DRAWN	DATE	SCALE	NOTES	FILE	NO.
TNC	TNC	NOV. 1991	1" = 40'H 1" = 6' V	TNC	90025-6	DR-1