
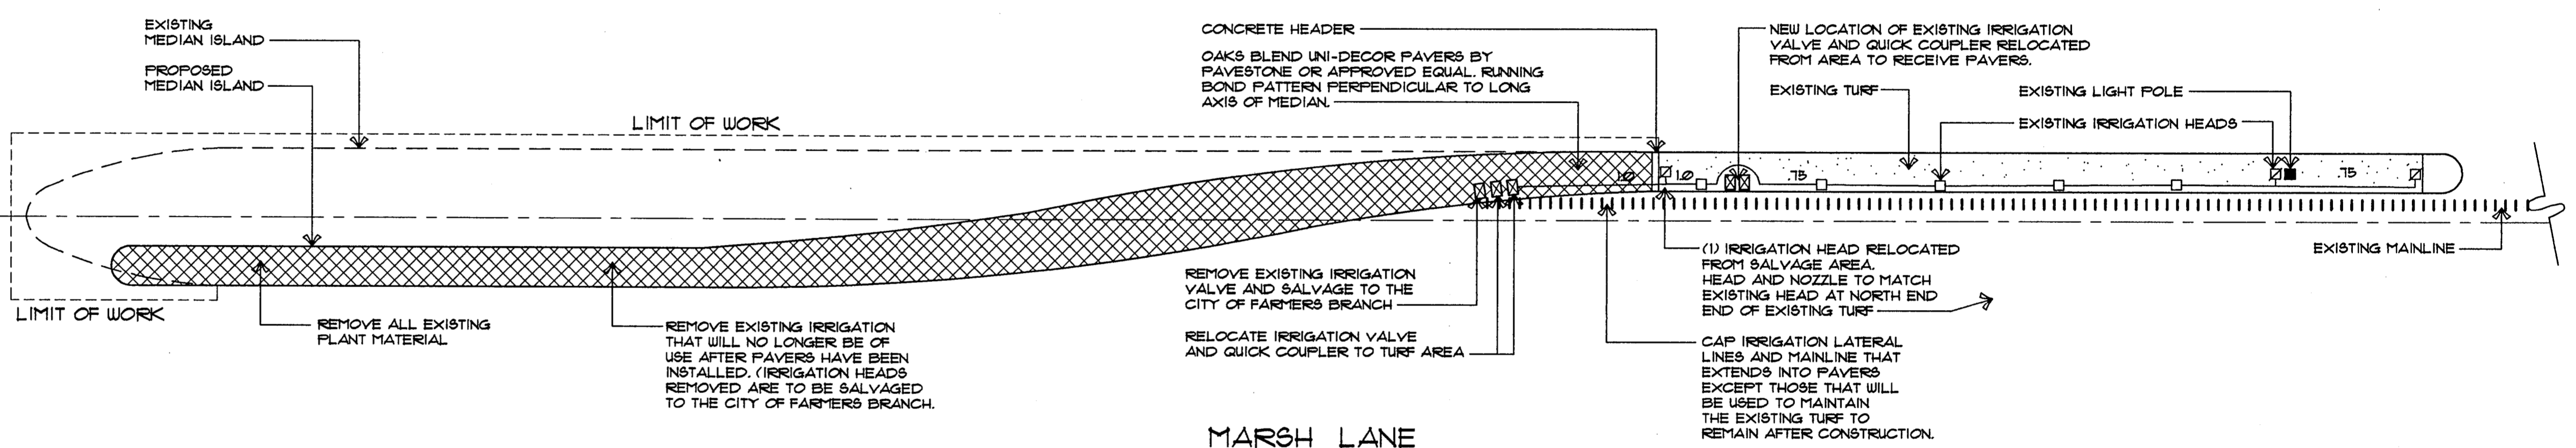


REVISION	DATE	DESCRIPTION	DRAWN BY	CHECKED BY

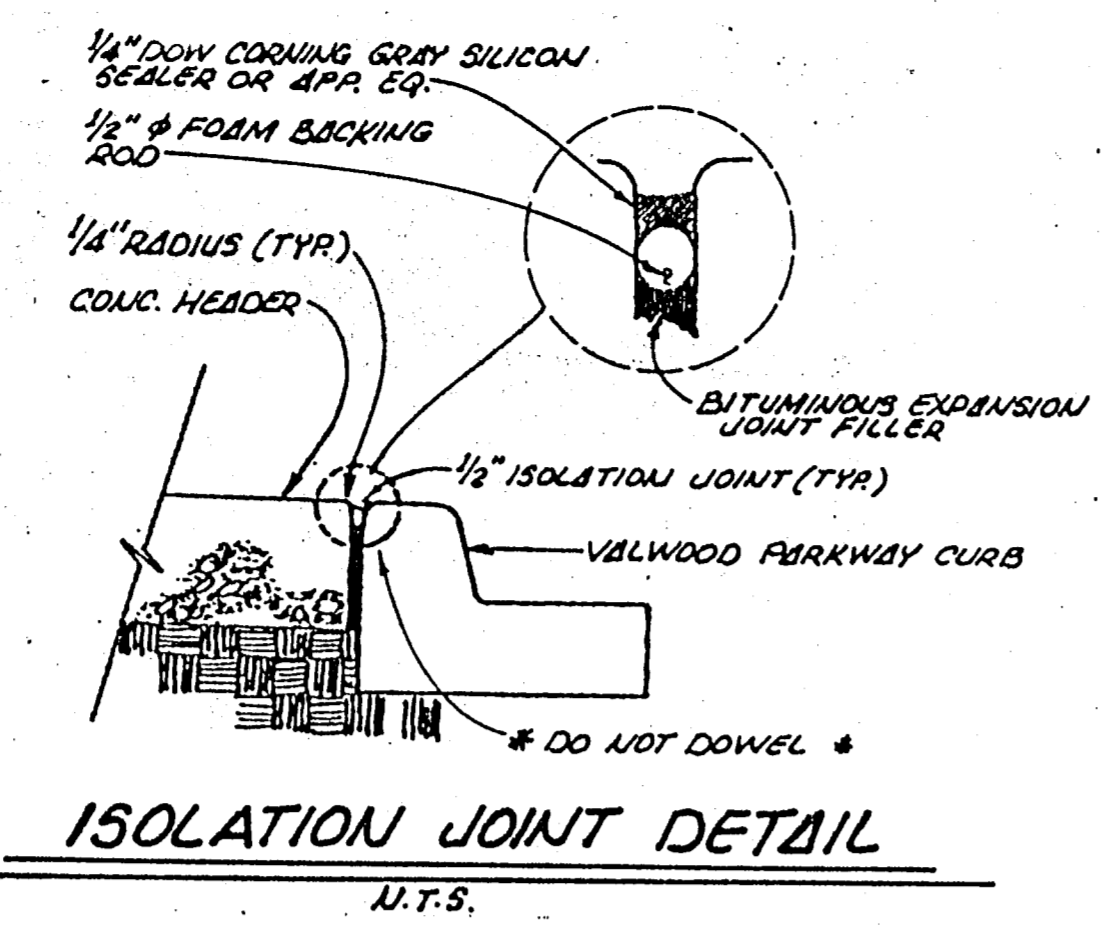

AS BUILTS


Based on visual inspection of the completed improvements, it appears this project was constructed in general conformance with these construction plans and will function as designed.

Clyde L. Sifford, P.E.
THE NELSON CORPORATION
5999 Summerside Drive, Suite 202
Dallas, Texas 75252


gcl PLS 3-15-95

Donc Binkley 3/15/94

ENTRY TO WATERFORD COURT APARTMENTS

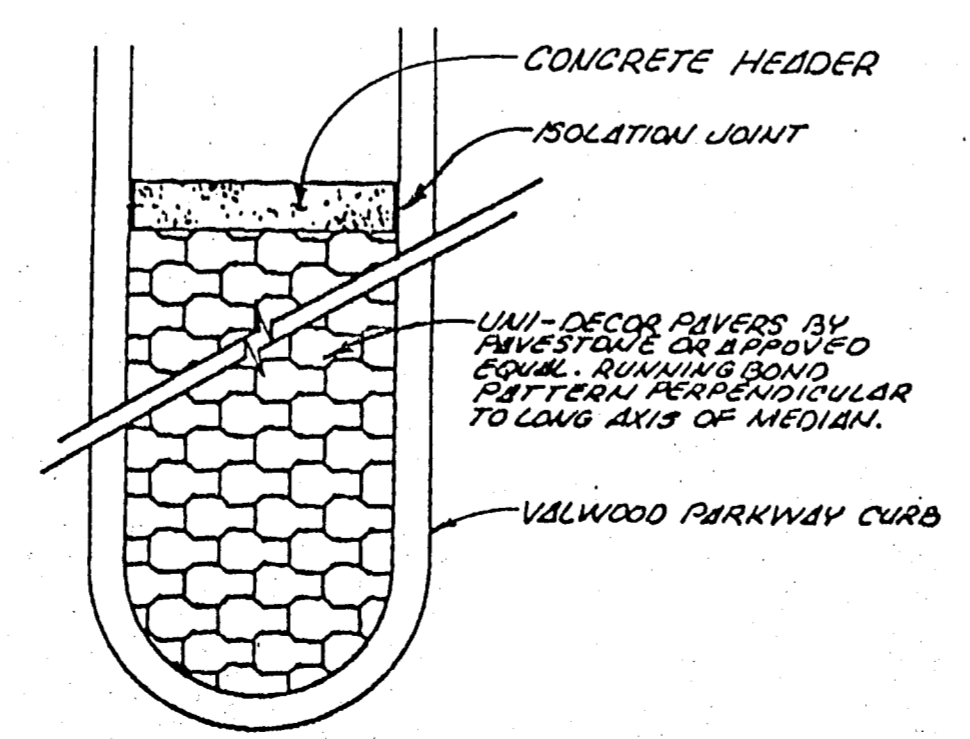

NOTE: CONCRETE HEADER SHALL HAVE AN "X" CHISELED WHERE EACH CONDUIT SLEEVE IS LOCATED.

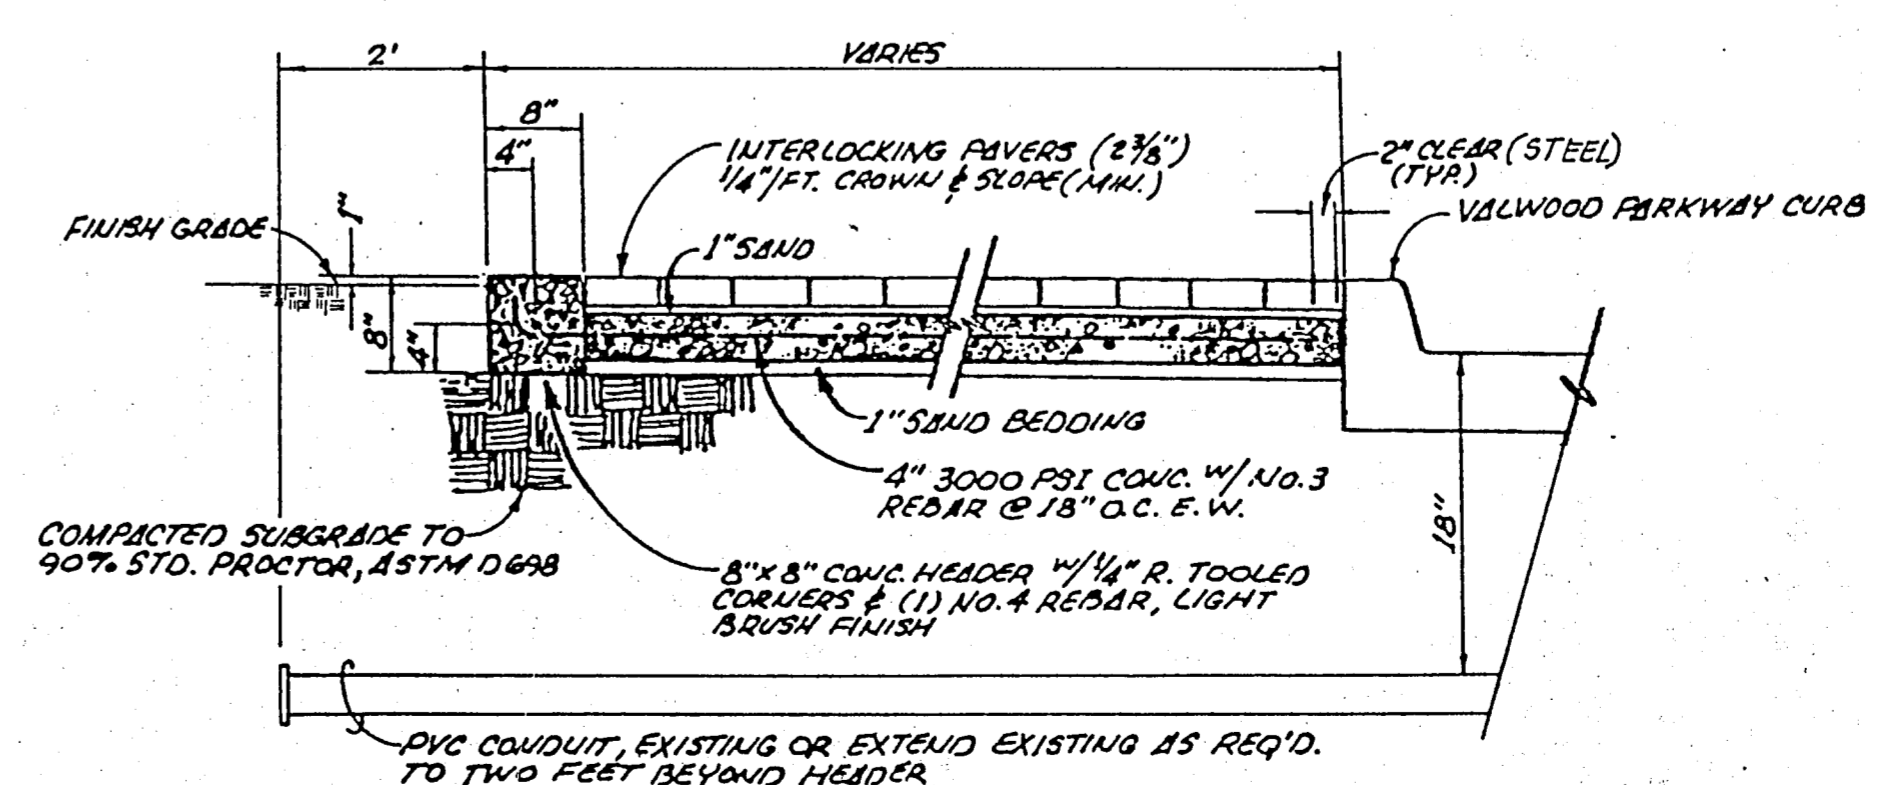

MEDIAN IMPROVEMENT PLAN					
WATERFORD COURT APARTMENTS					
CITY OF FARMERS BRANCH					
THE NELSON CORPORATION					
<small>PLANNING ENGINEERING SURVEYING LANDSCAPE ARCHITECTURE CONSTRUCTION MANAGEMENT</small>					
<small>5999 SUMMERSIDE DRIVE SUITE 202 DALLAS, TEXAS 75252 (214) 390-2605</small>					
DESIGN	DRAWN	DATE	SCALE	FILE	SHEET NO.
TNC	TNC	DEC. 8, 1993	1"=10'-0"	68126.10	11