


THE NELSON CORPORATION • DALLAS, TEXAS

BROOKHAVEN HILLS ADDITION  
CITY OF FARMER BRANCH  
VOL. 51, PG. 51

REVISION	DATE	DESCRIPTION	DRAWN BY	CHECKED BY

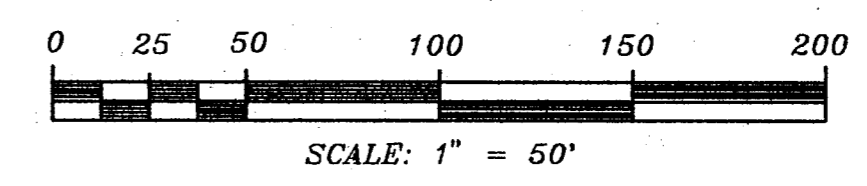

**AS BUILTS**

Based on visual inspection of the completed improvements, it appears this project was constructed in general conformance with these construction plans and will function as designed.

Clyde L. Sifford, P.E.  
THE NELSON CORPORATION  
5999 Summerside Drive, Suite 202  
Dallas, Texas 75252



*Clyde Sifford*  
8-25-94


PARKING REQUIREMENTS - 196 UNITS X 1.9 = 373 SPACES  
PARKING SPACES PROVIDED:

GARAGES	204
TANDEM SPACES	28
8 1/2' x 17' SPACES	129
HANDICAP	7
HANDICAP VAN	1
<b>TOTAL</b>	<b>369</b>

**SITE PLAN**

**WATERFORD COURT APARTMENTS**  
**TOWN OF ADDISON, TEXAS**

Date: MAR. 17, 1994	Scale: 1" = 50'	Sheet: 2
Drawn By: TNC	Approved By: TNC	Project No.: 86126.10

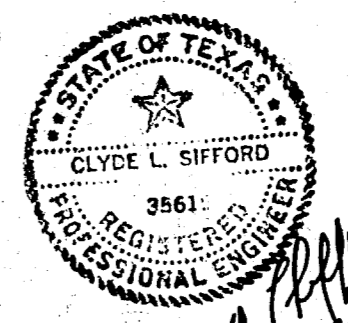

*Clyde Sifford*  
3-17-94

**THE NELSON CORPORATION**  
PLANNING • ENGINEERING • SURVEYING  
LANDSCAPE ARCHITECTURE • CONSTRUCTION MANAGEMENT

5999 SUMMERSIDE DRIVE SUITE 202 • DALLAS, TEXAS 75252 • (214) 380-2605