


PROP. 5' SIDEWALK
PARKWAY GRADED
ON 1/4" / FT. TYP.

CONSTRUCT BARRIER
FREE RAMP (TYP.)

PROP. WATER METER VAULT
REFERENCE LANDSCAPING
PLANS FOR DETAILED
GRADING
TOP OF VAULT 592.00

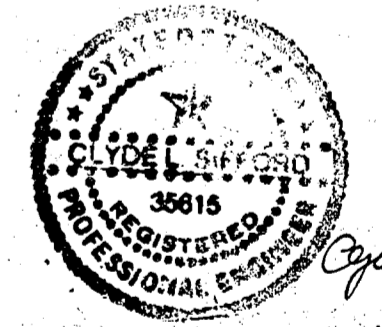

AS BUILTS
Based on visual inspection of the completed improvements, it appears this project was constructed in general conformance with these construction plans and will function as designed.


Clyde L. Sifford, P.E.
THE NELSON CORPORATION
6999 Summerside Drive, Suite 202
Dallas, Texas 75252

SWPPP

BENCHMARKS:
SQUARE CUT ON CENTERLINE OF 14' INLET AT THE N.E. CORNER OF THE INTERSECTION OF BELTWAY DRIVE AND MARSH LANE. ELEV. 595.20
SQUARE CUT IN CENTER OF THIRD INLET WEST OF THE EAST ADDITION LINE OF WATERFORD PARK II AND ON THE NORTH SIDE LES LACS AVENUE. ELEV. 597.61

LEGEND

EXISTING CONTOURS	
PROPOSED CONTOURS	
FLOW ARROW	
PROPOSED SPOT ELEVATION OR TOP OF PAVEMENT	
EROSION CONTROL DEVICE BY GRADING CONTRACTOR	
EROSION CONTROL DEVICE BY UTILITY CONTRACTOR	
PROBABLE WALL	

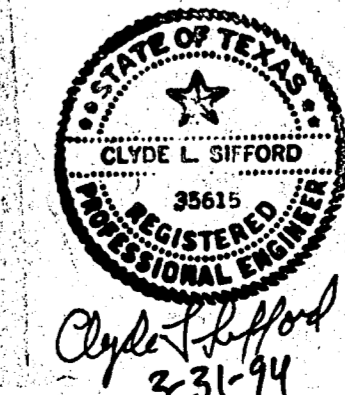

GRADING & EROSION CONTROL PLAN
WATERFORD COURT APARTMENTS
TOWN OF ADDISON, TEXAS

Date: 3/31/94 Scale: 1" = 30' Sheet: 6
Drawn By: TNC Approved By: TNC Project No.: 86126.10

THE NELSON CORPORATION
PLANNING • ENGINEERING • SURVEYING
LANDSCAPE ARCHITECTURE • CONSTRUCTION MANAGEMENT
6999 SUMMERSIDE DRIVE SUITE 202 • DALLAS, TEXAS 75252 • (214) 380-2805