


**AS BUILTS**  
 Based on visual inspection of the completed improvements, it appears this project was constructed in general conformance with these construction plans and will function as designed.

Clyde L. Sifford, P.E.  
 THE NELSON CORPORATION  
 5899 Summerside Drive, Suite 202  
 Dallas, Texas 75222

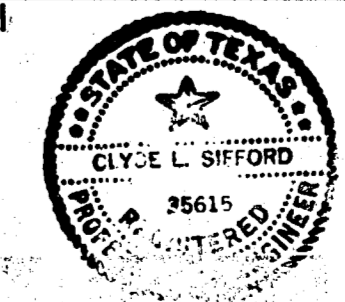

SANITARY SEWER PROFILES					
WATERFORD COURT APARTMENTS					
TOWN OF ADDISON, TEXAS					
THE NELSON CORPORATION PLANNING ENGINEERING SURVEYING					
5899 SUMMERSIDE DRIVE SUITE 202 DALLAS, TEXAS 75252 (214) 980-2805					
DESIGN	DRAWN	DATE	SCALE	FILE	SHEET NO.
TNC	TNC	MARCH 7, 1994	1" = 40' H 1" = 6' V	86126.10	9

**BENCHMARKS:**  
 SQUARE CUT ON CENTERLINE OF 14" INLET AT THE N.E. CORNER OF THE INTERSECTION OF BELTWAY DRIVE AND MARSH LANE. ELEV. 585.20  
 SQUARE CUT IN CENTER OF THIRD INLET WEST OF THE EAST ADDITION LINE OF WATERFORD PARK II AND ON THE NORTH SIDE LES LACS AVENUE. ELEV. 587.81