


**DEVELOPMENT PLANS
FOR
WATERVIEW ESTATES
TOWN OF ADDISON, TEXAS**

GENERAL NOTES

1. Prior to final acceptance by the Town of Addison:
 - a. A Texas Registered Professional Engineer shall certify that the project was constructed in accordance with the plans and specifications approved by the Town of Addison. The owner shall provide 1 reproducible set of as-builts (sealed and certified by a Texas Registered Engineer) and 2 blueprint sets.
 - b. A five foot sidewalk shall be installed along Proton Drive. See attached detail.
 - c. A one year maintenance bond is required for the internal subdivision infrastructure.
 - d. Owner shall demonstrate that the water and sanitary sewer systems meet the proper pressure, bacteria, and mandrel tests. In addition, the owner shall provide a VHS format video tape of the sanitary sewer.
2. Prior to starting construction, the contractor shall contract with the utility companies to locate existing facilities. These include but may not be limited to the following:
 - a. Town of Addison
 - b. Lone Star Gas
 - c. Southwestern Bell
 - d. Storer Cable
 - e. Planned Cable Systems
 - f. TU Electric
3. Prior to beginning construction, the owner or his authorized representative shall convene a Pre-Construction Conference between the Town of Addison, Consulting Engineer, Contractor(s), utility companies and any other affected parties. Notify Bruce Ellis 450-2847 at least 48-hours prior to the time of the conference and 48-hours prior to beginning of construction.
4. Any existing pavement, curbs, and/or sidewalks damaged or removed will be repaired by the contractor at their expense.
5. Lot pins shall be in place during construction and prior to final acceptance. Concrete monuments shall be placed on all boundary corners, block corners, curve points and angle points in public right-of-way. Concrete monuments shall be six (6) inches in diameter and twenty-four (24) inches long. Copper pin one-fourth inch in diameter embedded at least three (3) inches in the monument at the exact intersection point of the monument. The monument shall be set at such an elevation that after construction the top of the monument will be not less than twelve (12) inches below the ground surface.
6. The contractor shall stamp a 2-inch "S" in the curb at the location of the sewer service line.
7. At intersections that have valley drainage, the crown of the intersecting streets will culminate in a distance of 40 feet from the intersecting curb line unless otherwise noted.
8. Temporary or permanent street barricades shall remain at all points of ingress and egress to prevent public use until such street received final acceptance.
9. Contractor shall obtain a right-of-way permit by the Town of Addison for working within the public right-of-way.
10. During construction, the owner shall provide a qualified geotechnical lab to perform materials testing during the construction, at the request of the Town of Addison.
11. The contractor shall submit material sheets to the Town of Addison for approval prior to incorporating materials into the job.

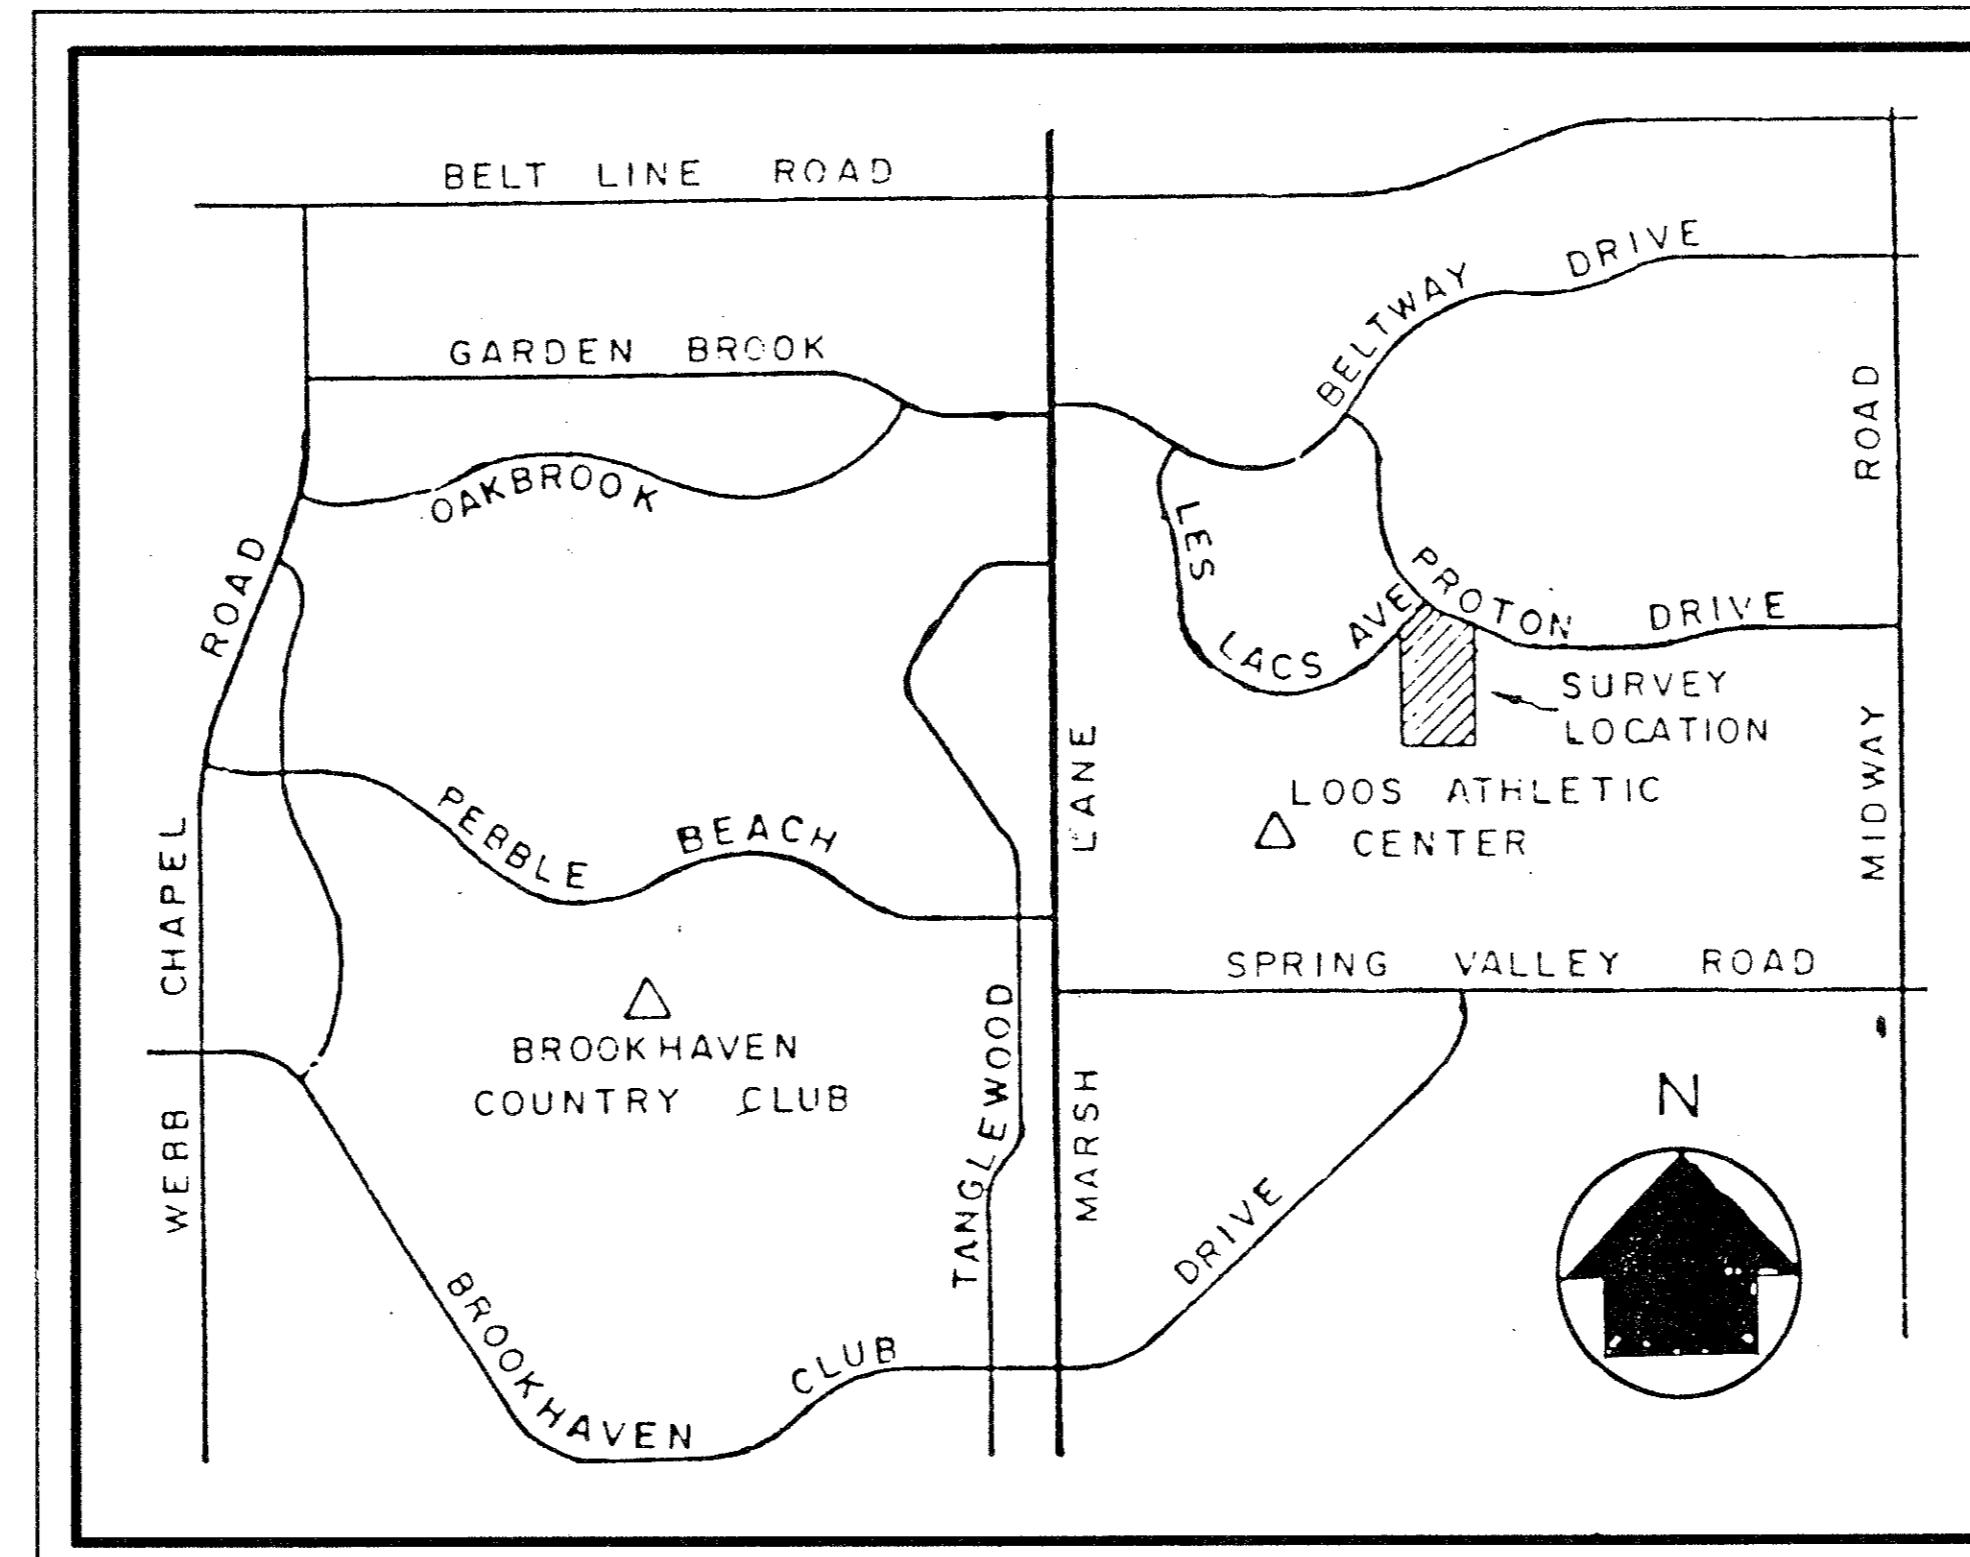

INDEX

Sheet No.	Description
1	Plat
2	Drainage Plan
3-4	Paving Plans
5	Storm Sewer
6	Water & Sewer Plan
7	Sanitary Sewer Profiles
8	Erosion Control Plan
9	Grading Plan
D1-D10	Detail Sheets

As Built Plans
1-31-92

I certify that the construction staking of the paving, drainage, water and sewer was performed in accordance to the approved plans, constructed in compliance and in general conformance to the Town of Addison's specifications and will function in accordance with the intent of the design.

**PREPARED FOR
~ OWNER ~**


GRAND HOMES INC.

8800 N. CENTRAL EXPWY. ~ DALLAS, TEXAS 75231 ~ PH NO. (214)750-6528




DON A. TIPTON, INC. CONSULTING ENGINEERS
6330 BELT LINE ROAD ~ SUITE C ~ GARLAND, TEXAS 75043



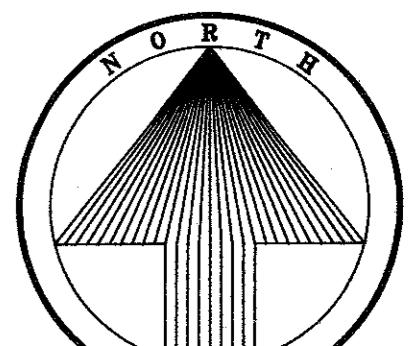

60 30 0 60 120
SCALE FEET

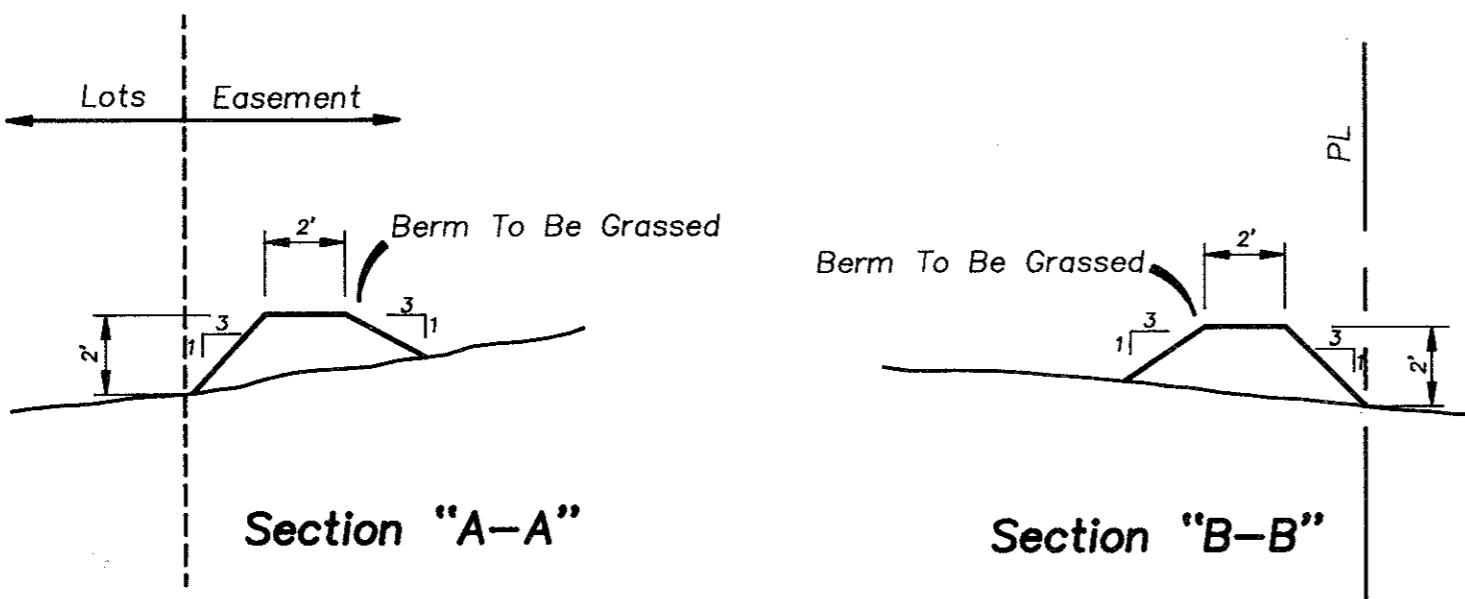


Drainage Data

Area	Acre	"C"	I ₁₀₀	Q ₁₀₀
A	1.80	0.5	7.52	6.77
B	1.00	0.5	7.52	3.76
C	1.50	0.5	7.52	5.64
D	1.00	0.5	7.52	3.76
E	1.60	0.5	7.52	6.02
F	2.00	0.5	7.52	7.52
G	1.50	0.3	7.52	3.38
H	1.20	0.5	7.52	4.51
J	0.80	0.5	7.52	3.00

TC = 15.0 Min.

NOTE:
Area "G" To Be Restored To
Original Condition Or Better
If Disturbed By Construction.

Proposed "Q₁₀₀" Surface Flow Offsite = 4.51 cfs (Area "H")
Existing "Q₁₀₀" Surface Flow Offsite = 26.2 cfs (Undev. Conditions)

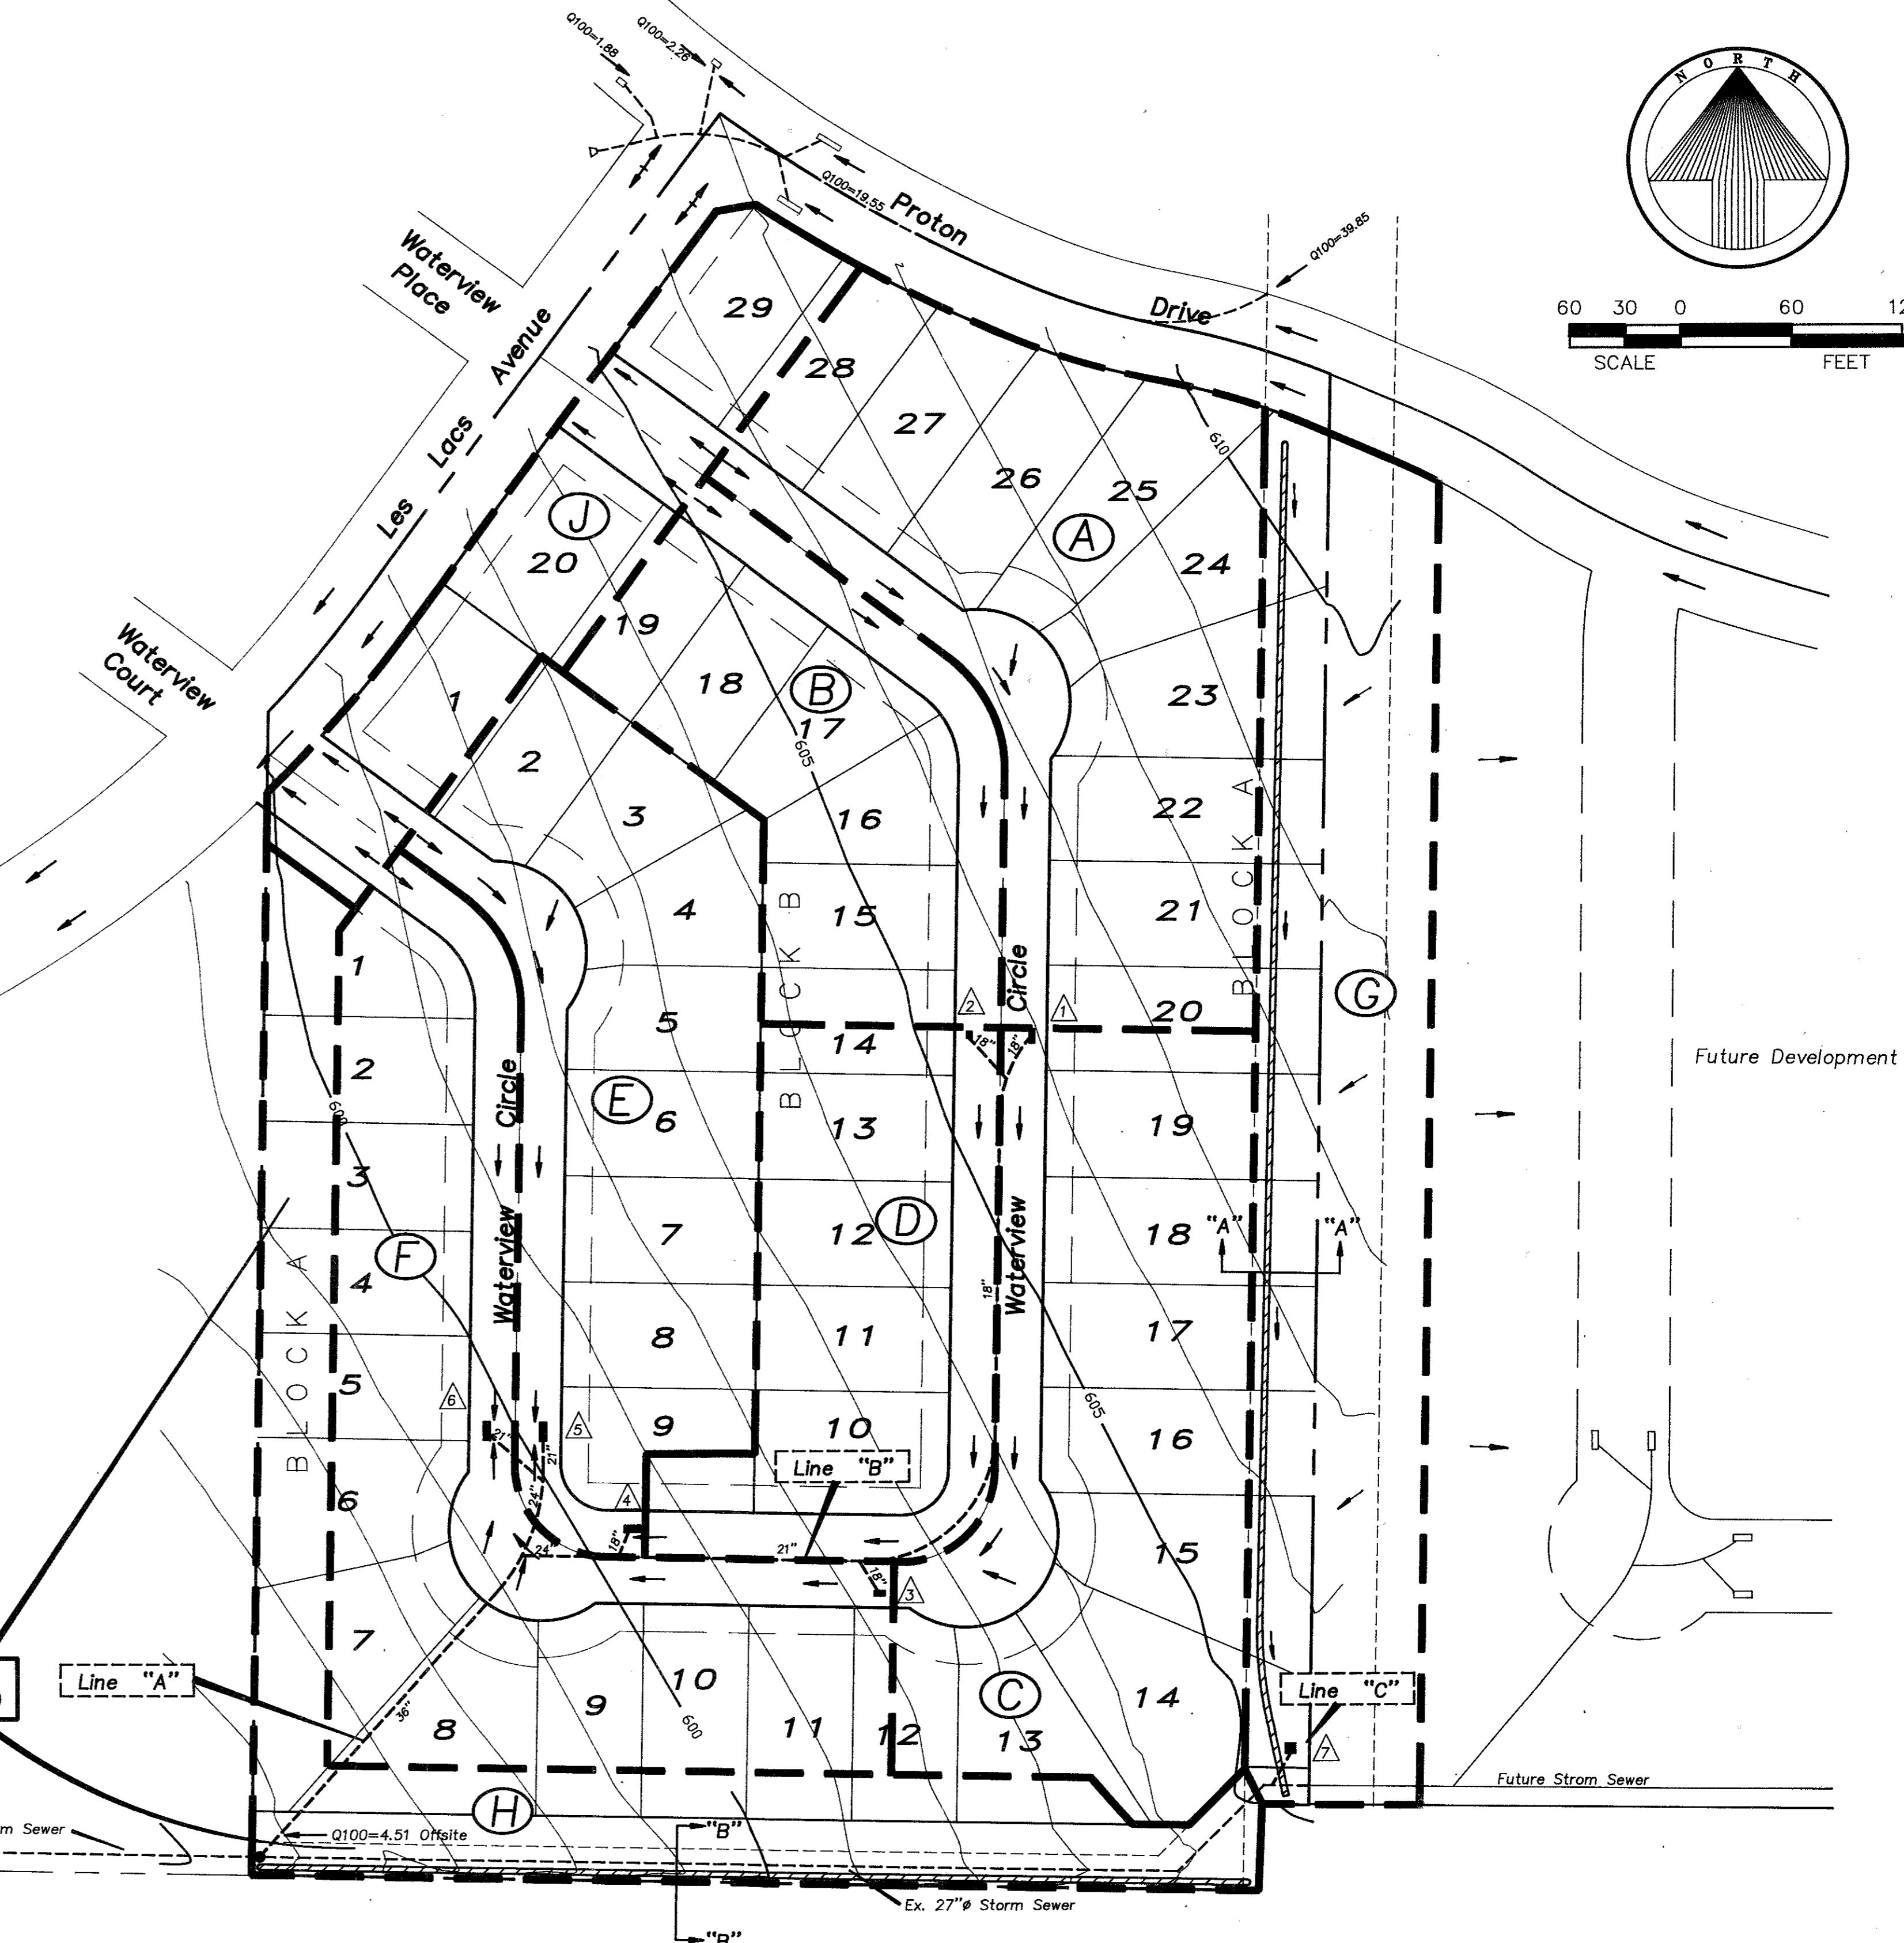

INLET CALCULATION CHART

INLET	DRainage	INLET	DESIGN	TIME	INTENSITY	DEV.	UNDEV.	DRainage	DEV.	UNDEV.	BY-PASS	TOTAL	GUTTER	GUTTER	CROWN	LENGTH	TYPE	*Y*	CAPACITY	BY-PASS	BY-PASS	
1	A	10+00	1	100	15.00	7.52	0.50	0.30	1.80	6.77	4.06	0.00	6.77	1.5	7.0	1.6'PAR	8	I	0.50	8.00	0.00	N/A
2	B	10+00	1	100	15.00	7.52	0.50	0.30	1.00	3.76	2.26	0.00	3.76	1.5	7.0	1.6'PAR	4	I	0.50	4.00	0.00	N/A
3	C	6+75	1	100	15.00	7.52	0.50	0.30	1.50	5.64	3.38	0.00	5.64	1.0	5.7	1.6'PAR	6	I	0.50	6.00	0.00	N/A
4	D	5+40	1	100	15.00	7.52	0.50	0.30	1.00	3.76	2.26	0.00	3.76	1.0	5.7	1.6'PAR	4	I	0.50	4.00	0.00	N/A
5	E	4+30	1	100	15.00	7.52	0.50	0.30	1.60	6.02	3.61	0.00	6.02	1.0	5.7	1.6'PAR	10	IA	0.50	15.00	0.00	N/A
6	F	4+30	1	100	15.00	7.52	0.50	0.30	2.00	7.52	4.51	0.00	7.52	1.0	5.7	1.6'PAR	10	IA	0.50	15.00	0.00	N/A
7	G	TPAL EGM T	1	100	15.00	7.52	N/A	0.30	1.50	0.00	3.38	0.00	0.00	1.0	6.0	DITCH	2'x 2'	V	0.50	8.00	0.00	N/A


Bench Mark 1
"□" Top of concrete footing of Southwest corner
of tower #12-3W-T291. Elev. 619.46

Bench Mark 2
"□" Top of curb South side of Proton Drive, 400'
East of Les Lacs Ave. Elev. 611.31(Set)

Bench Mark 3
"□" Top of concrete footing of Northwest corner
of tower #12-3W-T290. Elev. 613.08

"As-Built Plans"

1-31-92

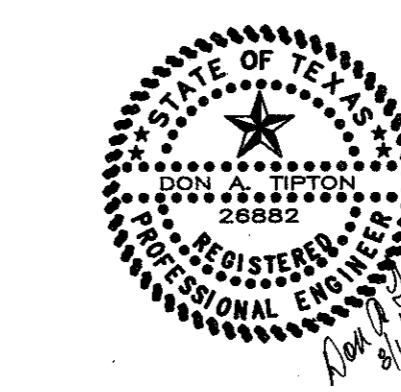

DRAINAGE MAP

WATERVIEW ESTATES




Town Of Addison, Texas



dt DON A. TIPTON, INC. CONSULTING ENGINEERS

6330 Belt Line Rd. ~ Suite C ~ Garland, Texas 75043

DESIGN DRAWN DATE SCALE NOTES FILE NO.

d.a.t. inc. d.a.t. inc. 8/91 1"=60' d.b. Waterview Estates 3626

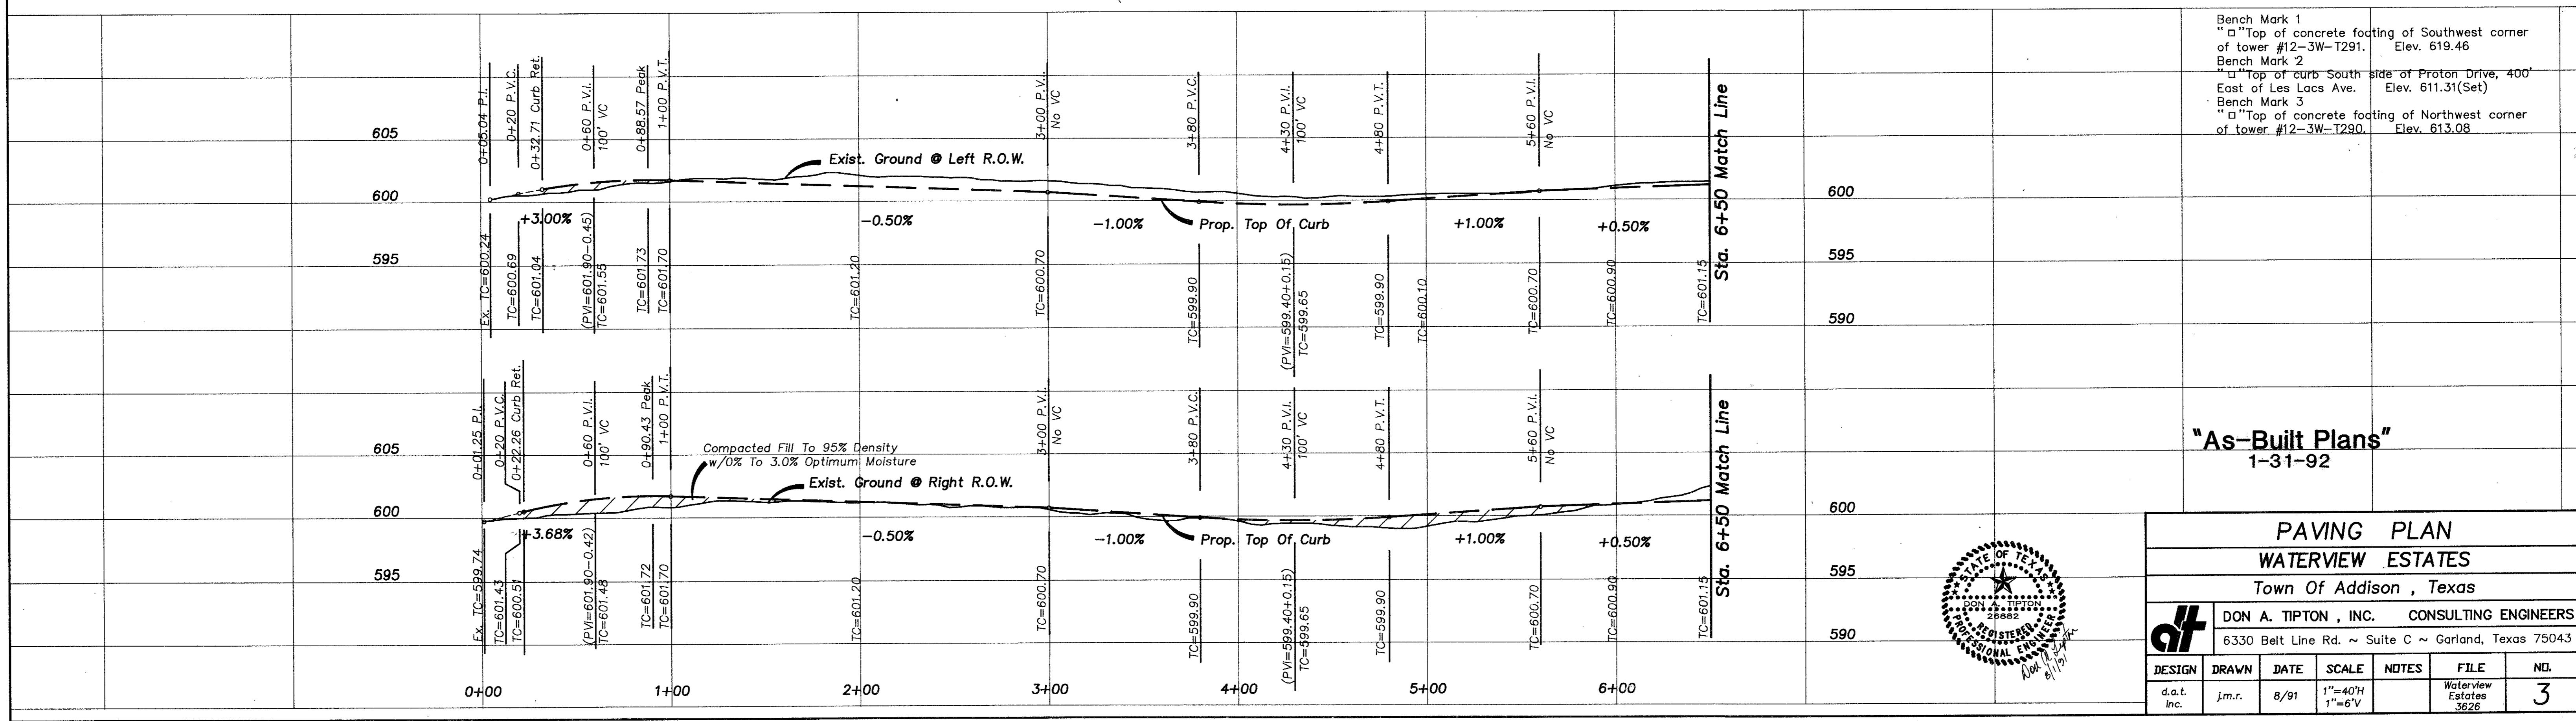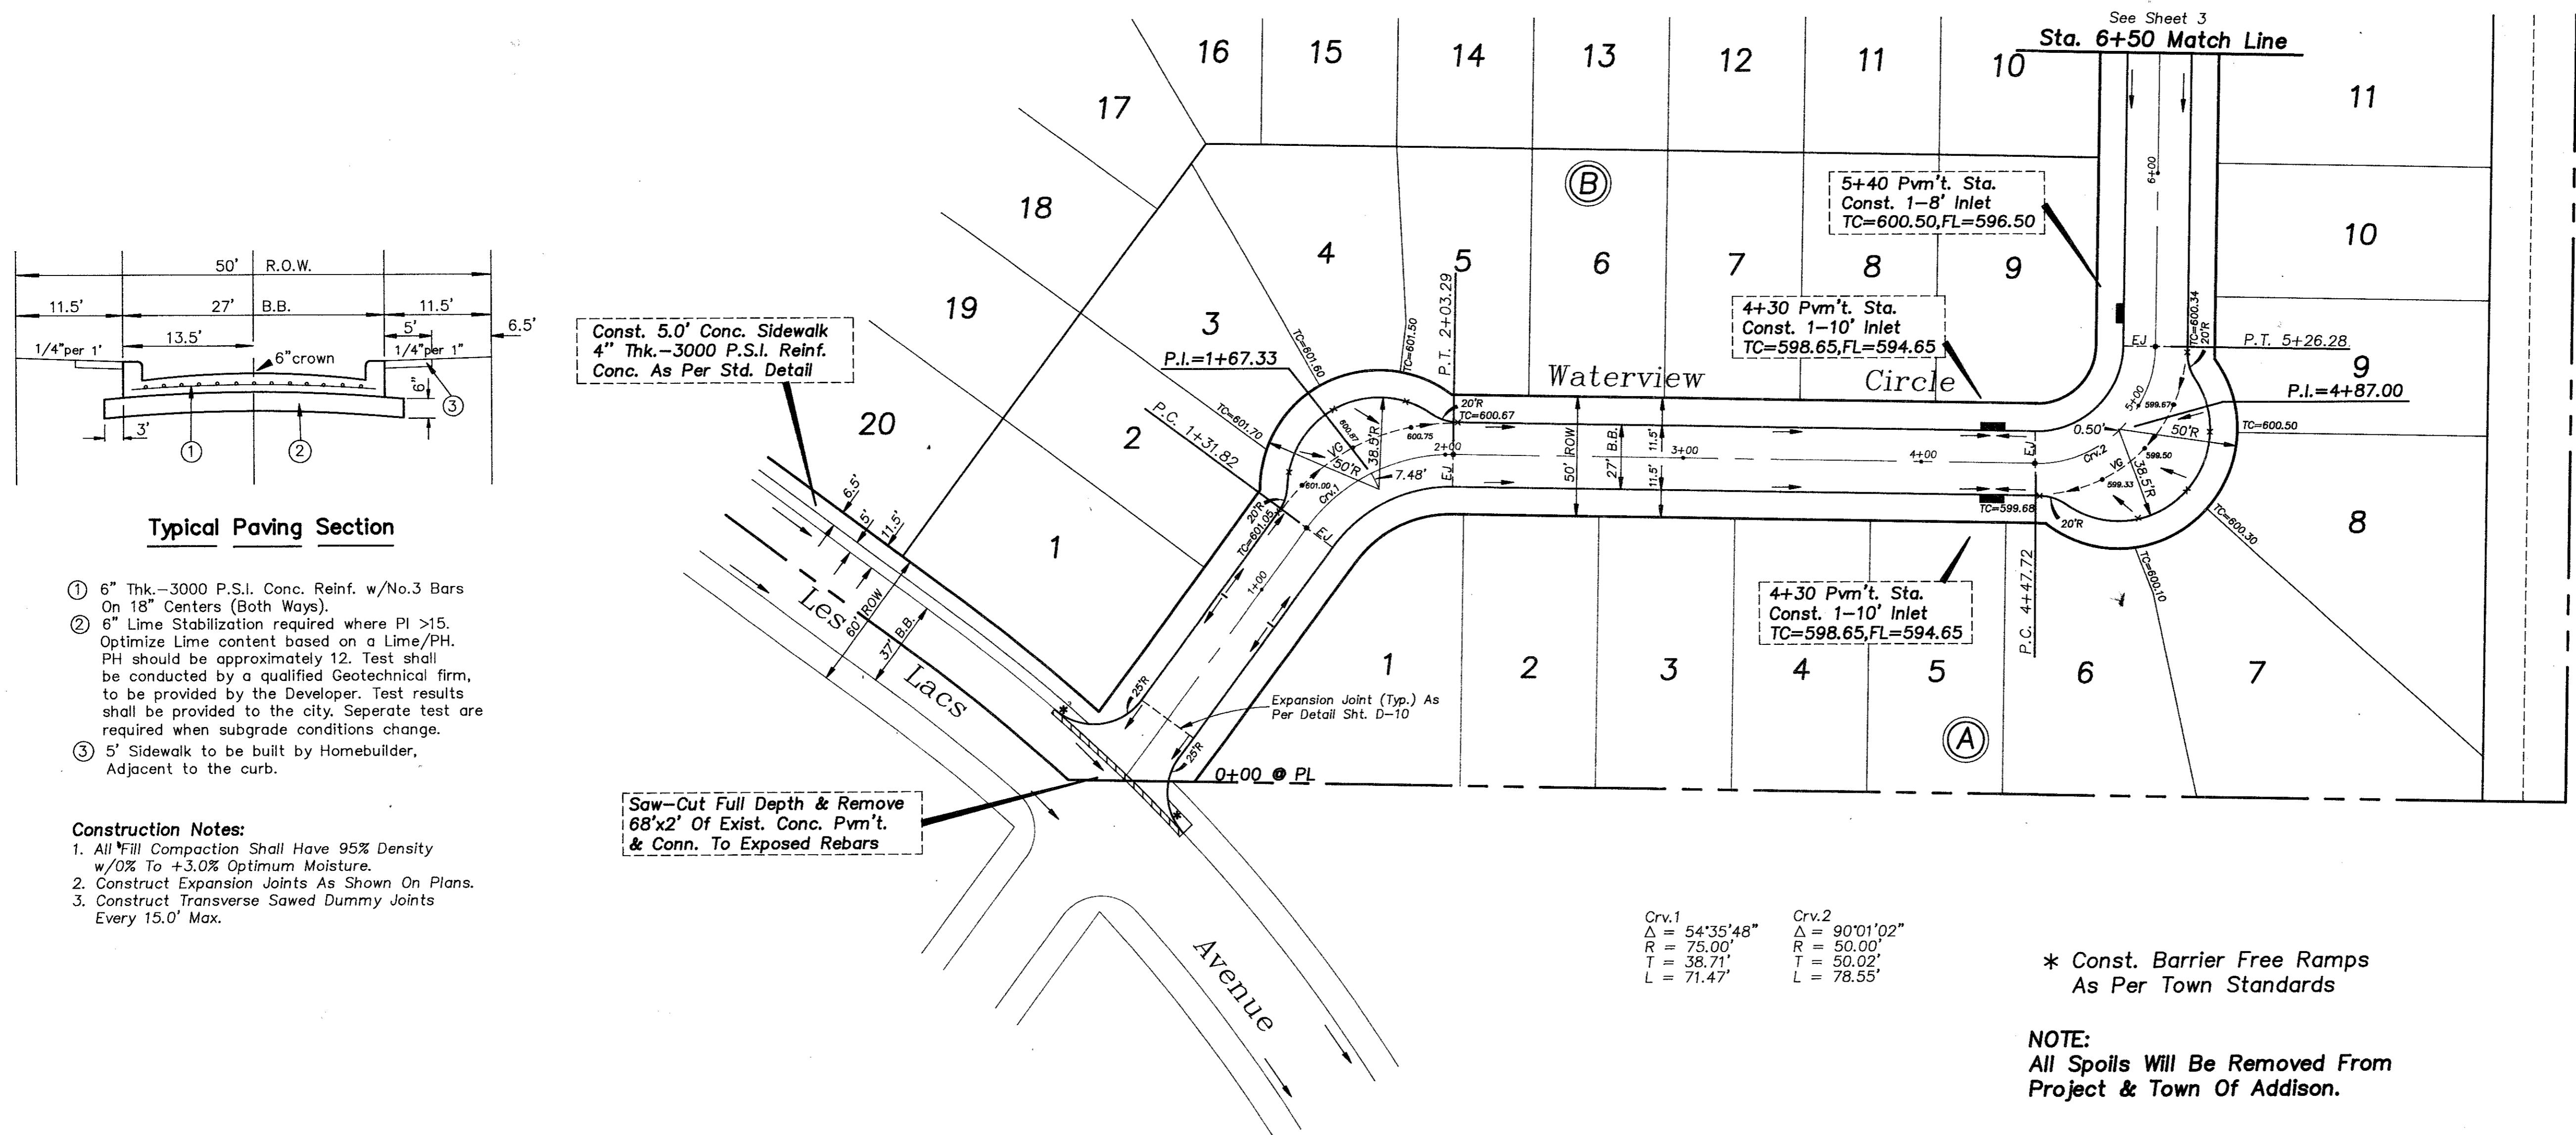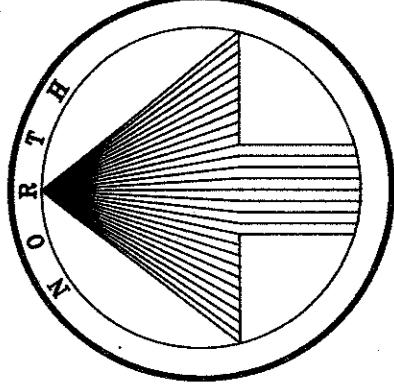


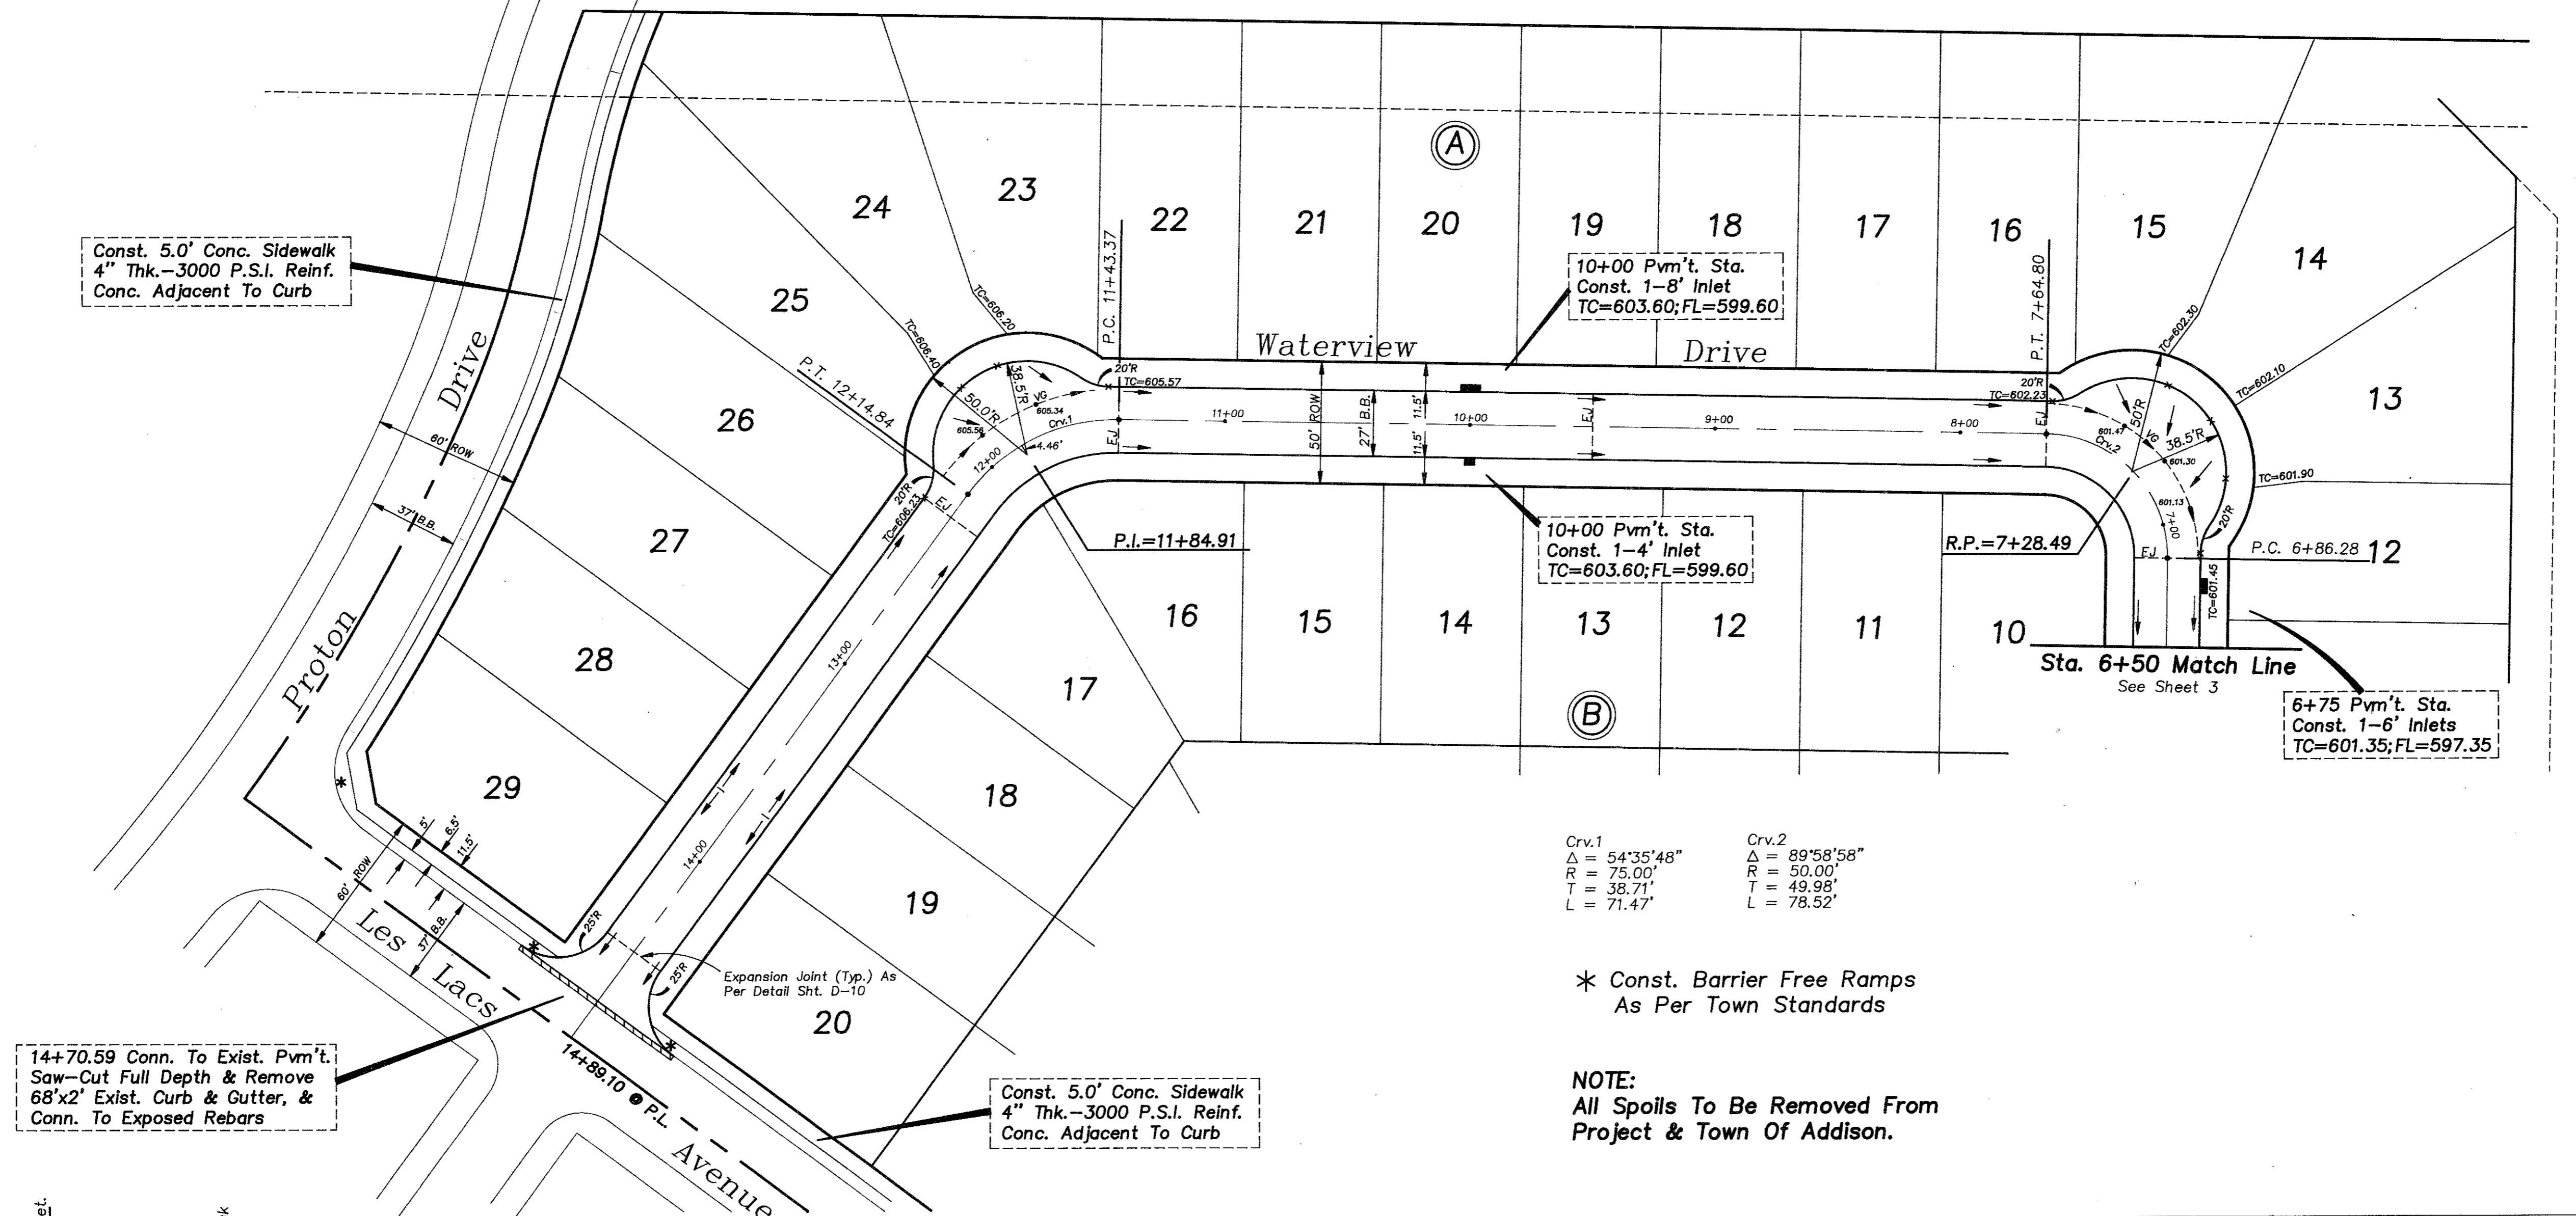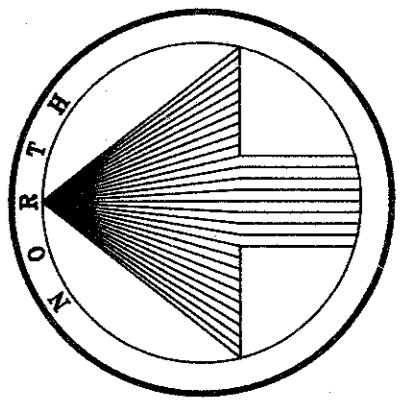

CAUTION !!!
EXISTING UTILITIES

S AND UNDERGROUND FACILITIES INDICATED
S HAVE BEEN LOCATED FROM REFERENCE
SHALL BE THE RESPONSIBILITY OF THE
VERIFY BOTH HORIZONTALLY AND VERTICALLY
F ALL EXISTING UTILITIES AND UNDERGROUND
TO CONSTRUCTION, TO TAKE NECESSARY
ORDER TO PROTECT ALL FACILITIES
THE CONTRACTOR SHALL PRESERVE AND
EXISTING UTILITIES FROM DAMAGE DURING




WE ARE AWARE OF THESE FACILITIES LOCATED IN THE
PROXIMITY TO THIS PROJECT.
TU ELECTRIC COMPANY 323-8928
LONE STAR GAS COMPANY 487-3885
SOUTHWESTERN BELL TELEPHONE 464-4095
STORER CABLE 840-2388

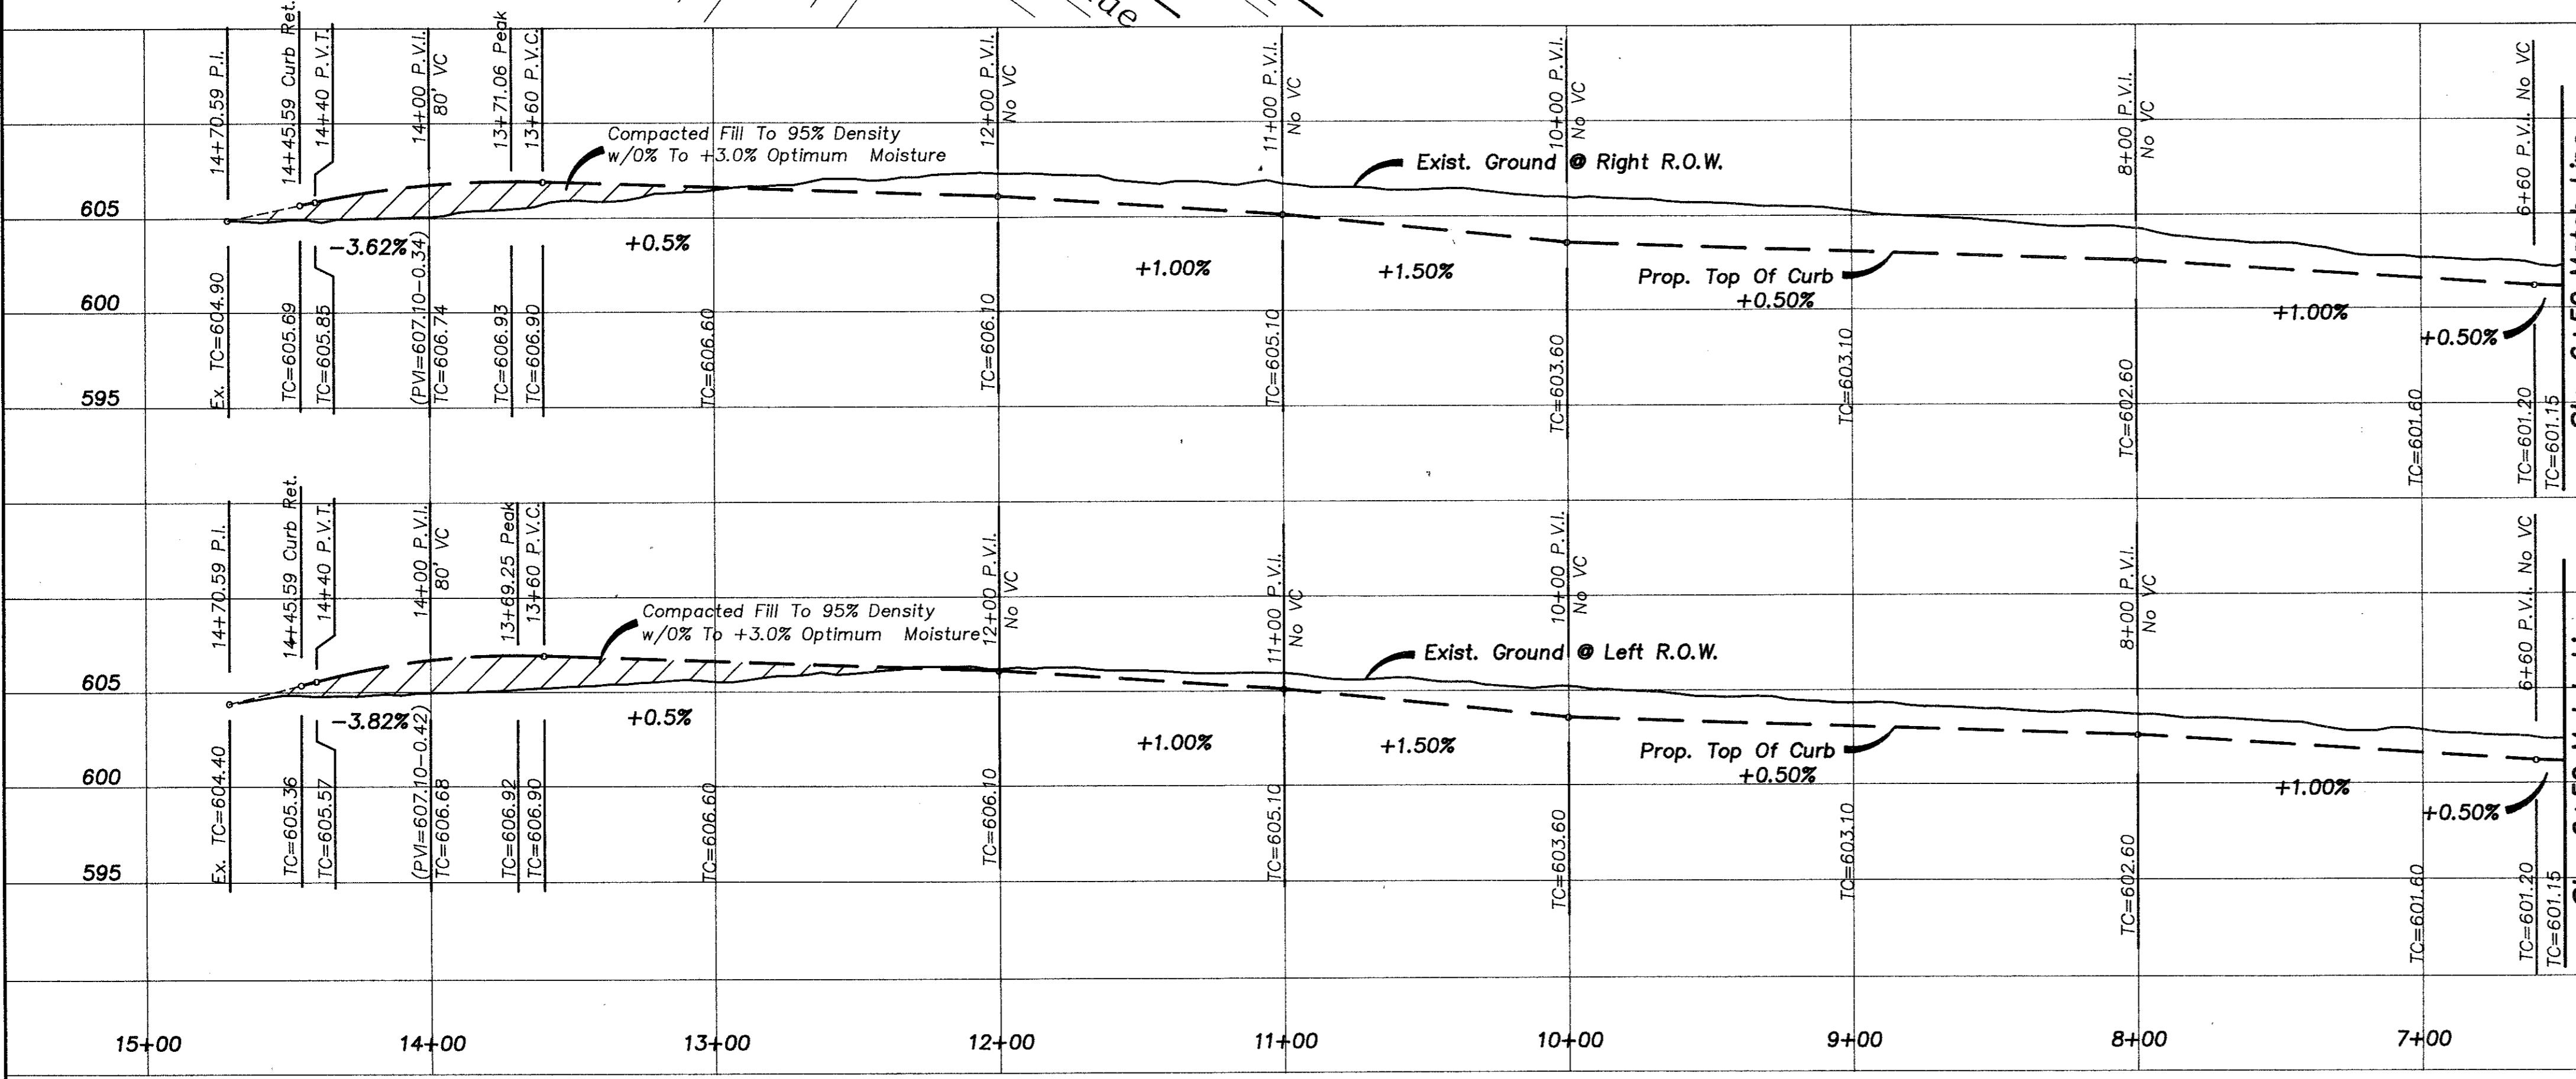

"As-Built Plans"

1-31-92

PAVING PLAN
WATERVIEW ESTATES
Town Of Addison , Texas

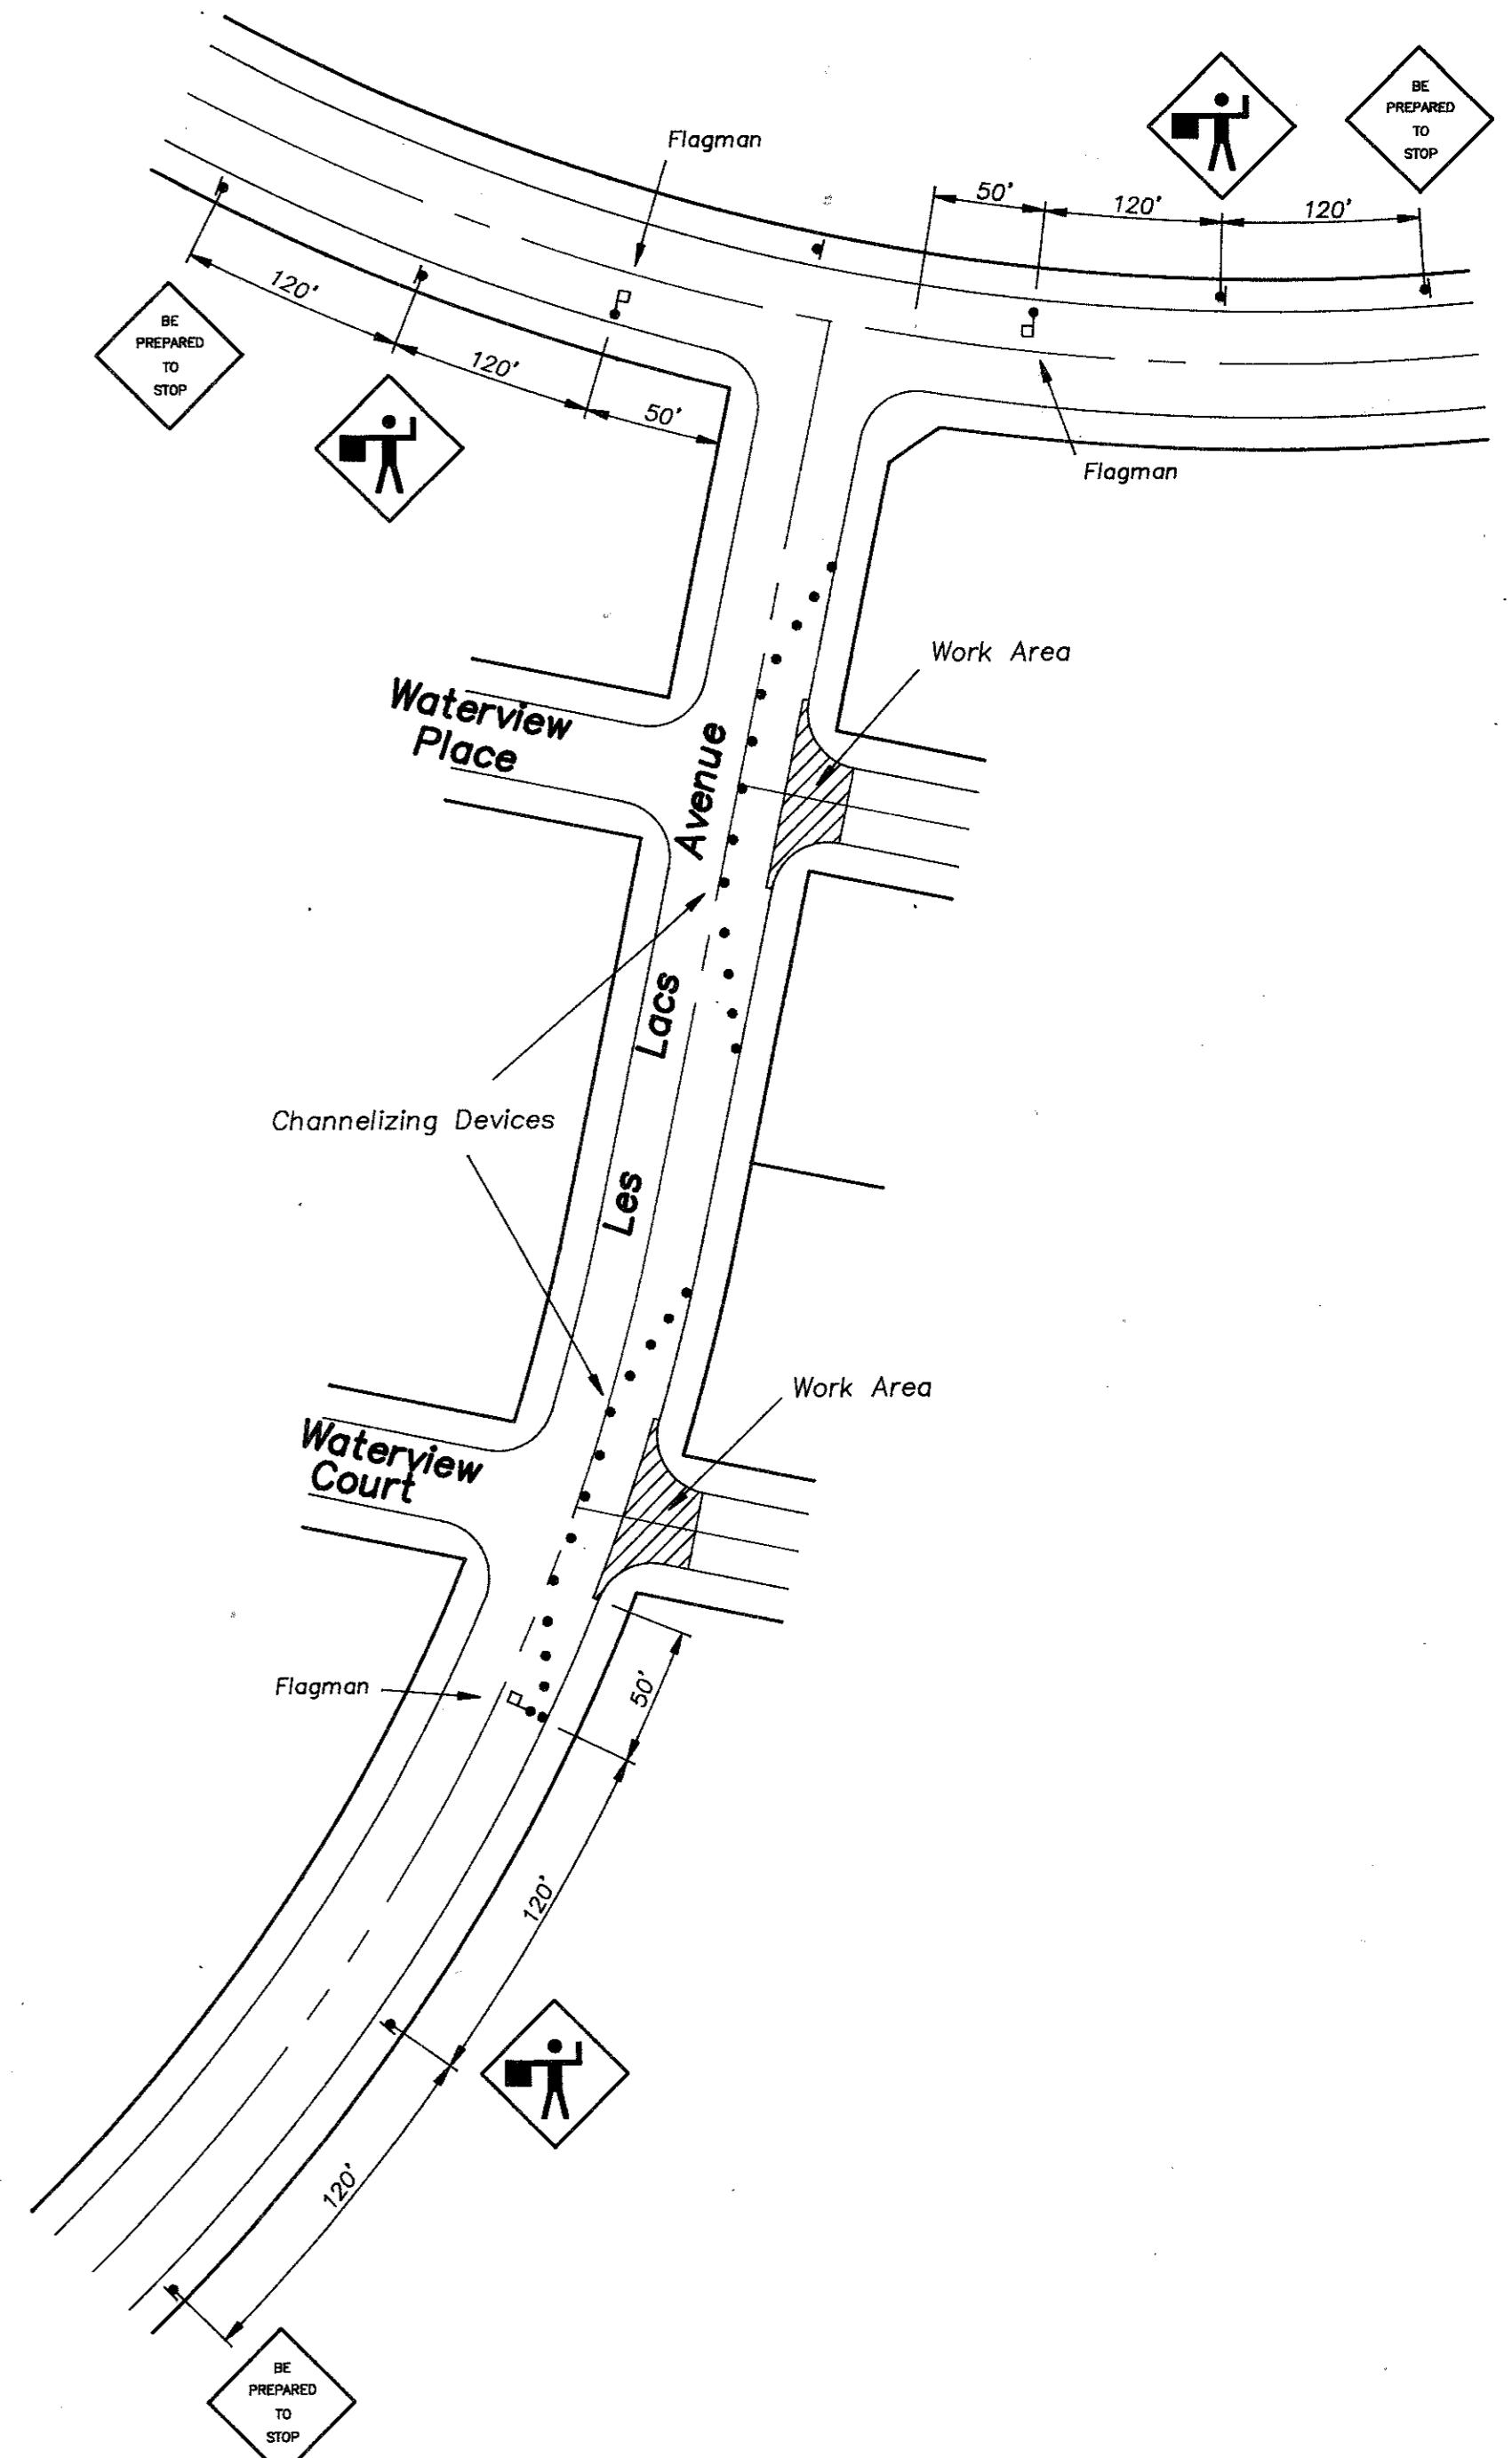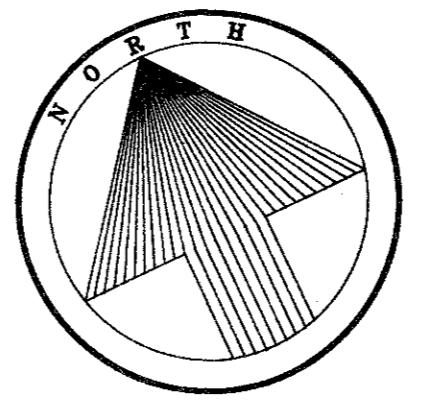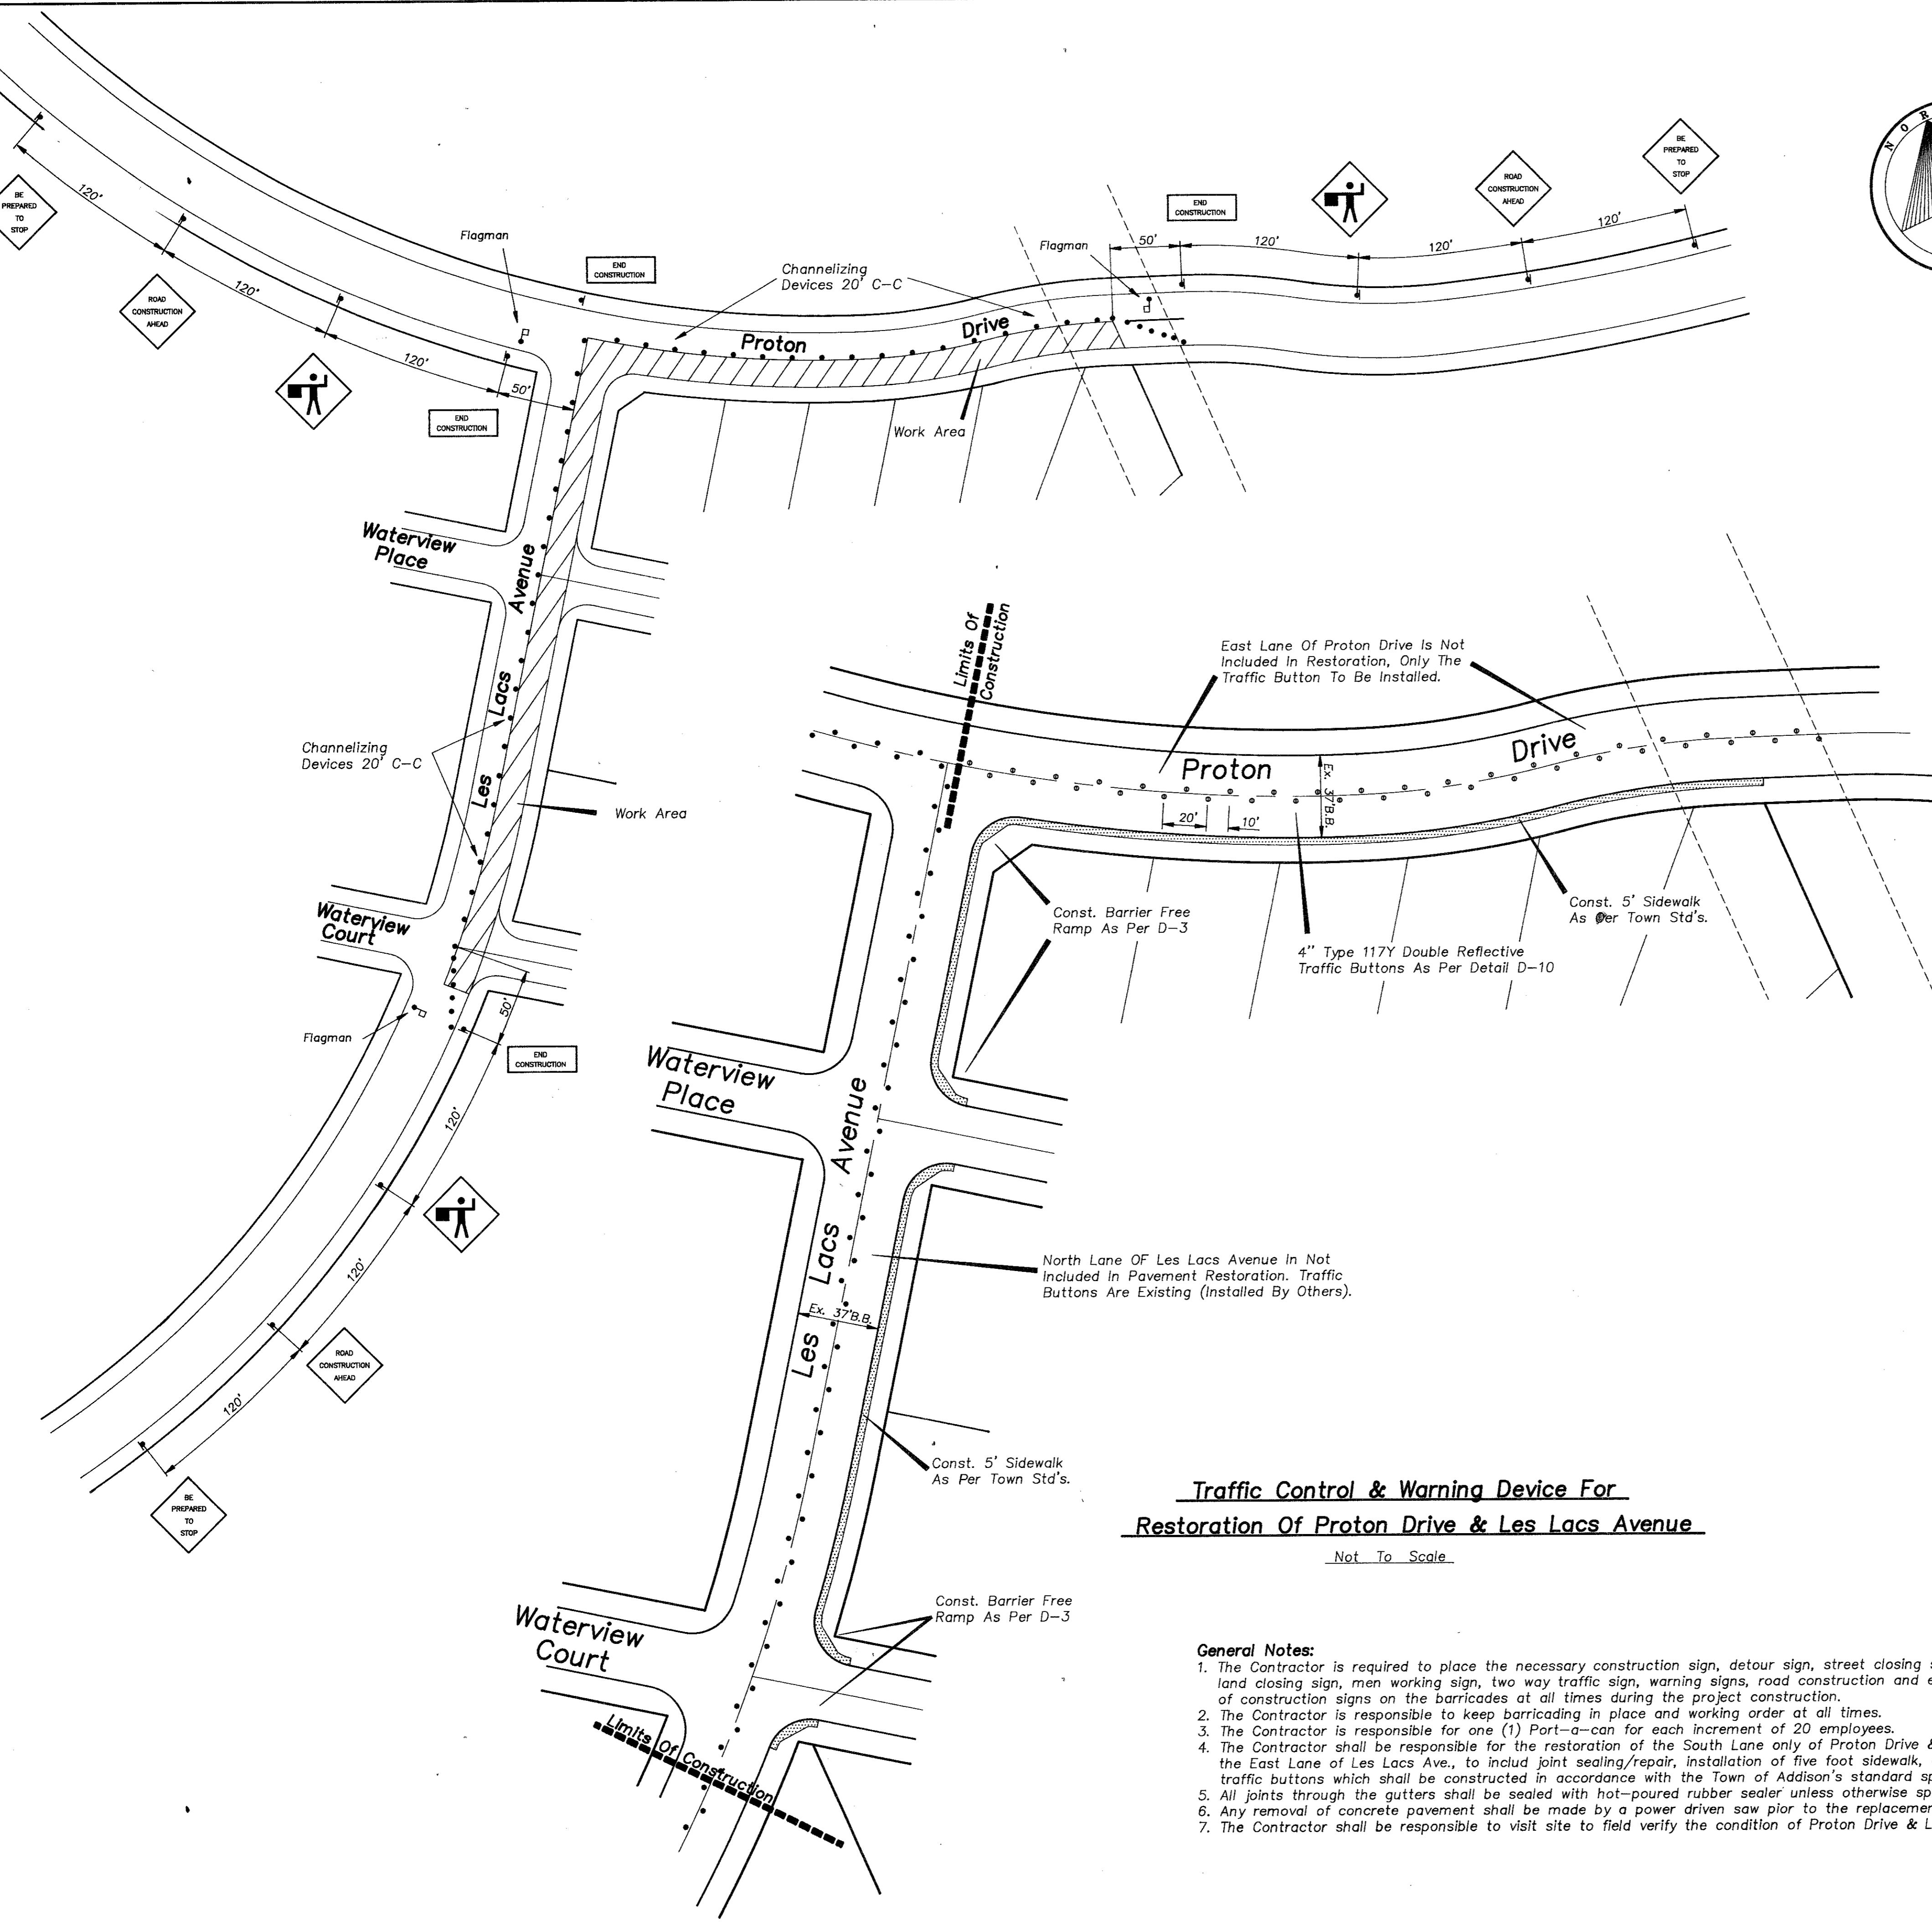

Traffic Control For Street Installations

Not To Scale

Traffic Control & Warning Device For Restoration Of Proton Drive & Les Lacs Avenue



Not To Scale


General Notes:

1. The Contractor is required to place the necessary construction sign, detour sign, street closing sign, land closing sign, men working sign, two way traffic sign, warning signs, road construction and end of construction signs on the barricades at all times during the project construction.
2. The Contractor is responsible to keep barricading in place and working order at all times.
3. The Contractor is responsible for one (1) Port-a-can for each increment of 20 employees.
4. The Contractor shall be responsible for the restoration of the South Lane only of Proton Drive & the East Lane of Les Lacs Ave., to include joint sealing/repair, installation of five foot sidewalk, and traffic buttons which shall be constructed in accordance with the Town of Addison's standard specifications.
5. All joints through the gutters shall be sealed with hot-poured rubber sealer unless otherwise specified.
6. Any removal of concrete pavement shall be made by a power driven saw prior to the replacement of the paving.
7. The Contractor shall be responsible to visit site to field verify the condition of Proton Drive & Les Lacs Ave.


"As-Built Plans"
1-31-92


STREET RESTORATION PLAN					
WATERVIEW ESTATES					
Town Of Addison , Texas					
 DON A. TIPTON, INC. CONSULTING ENGINEERS					
DESIGN	DRAWN	DATE	SCALE	NOTES	FILE NO.
D.A.T.	J.M.R.	7/91	1"=60'		Waterview Estates 3626 4A

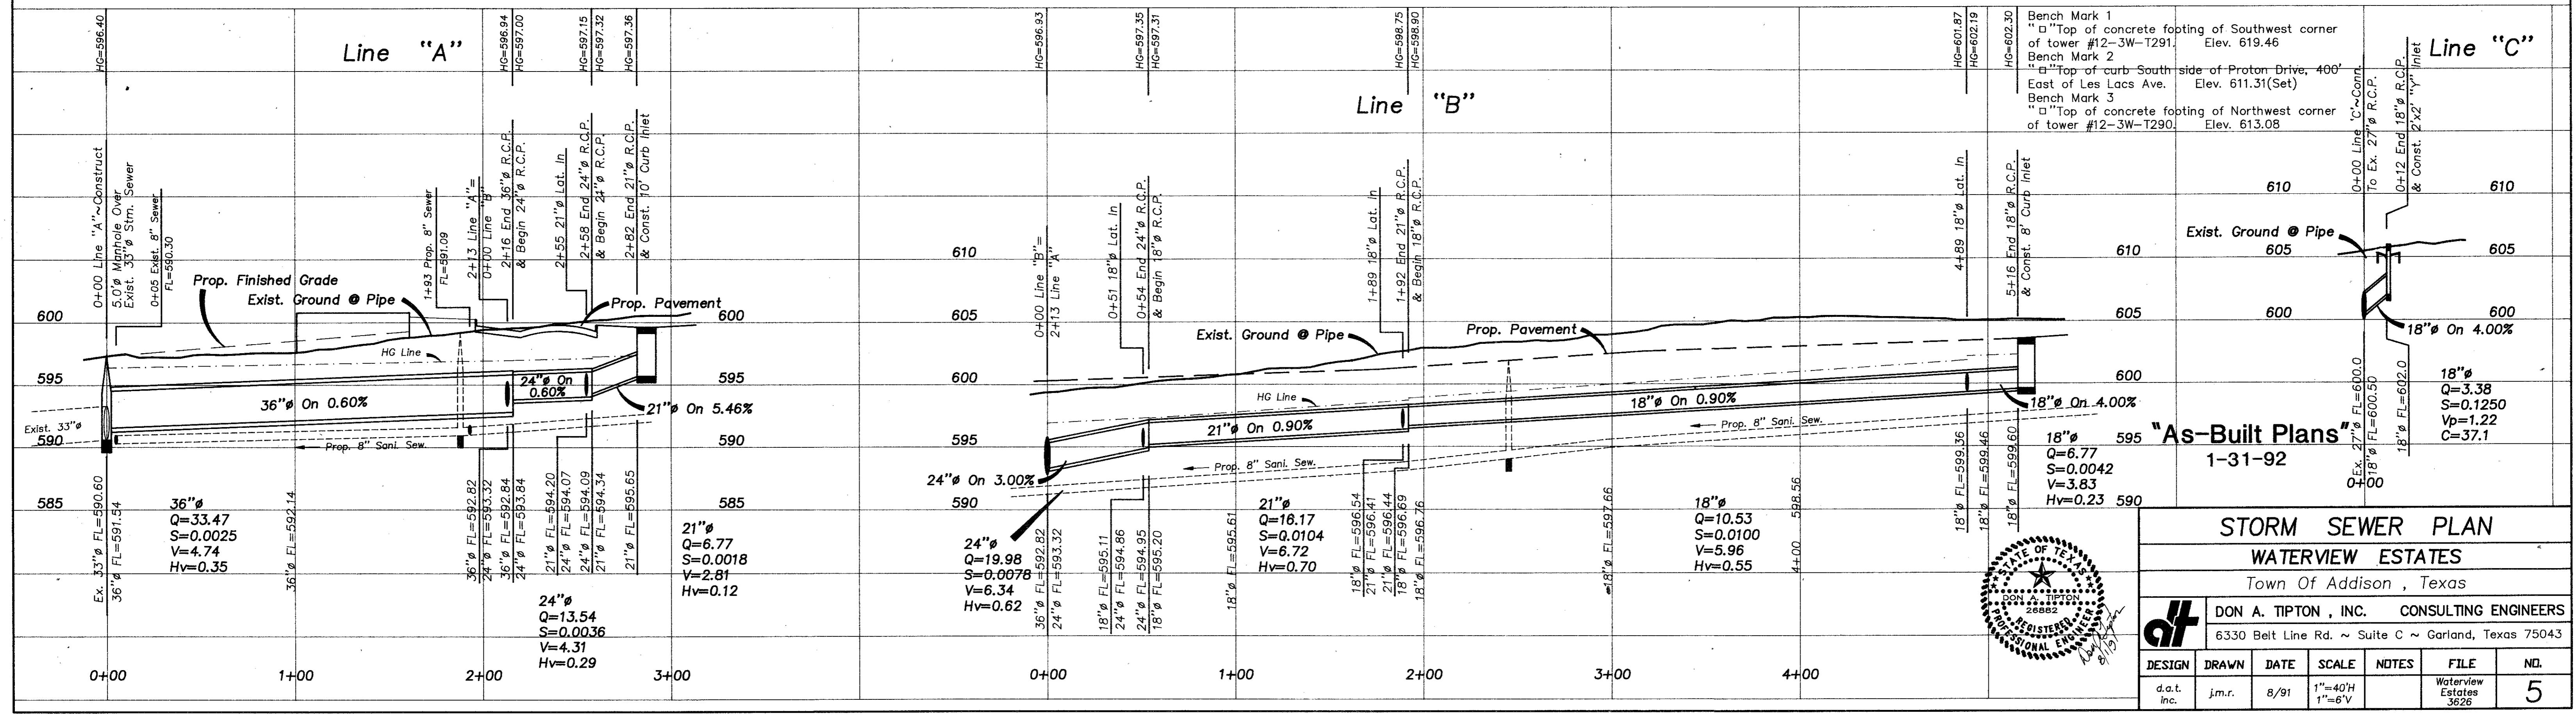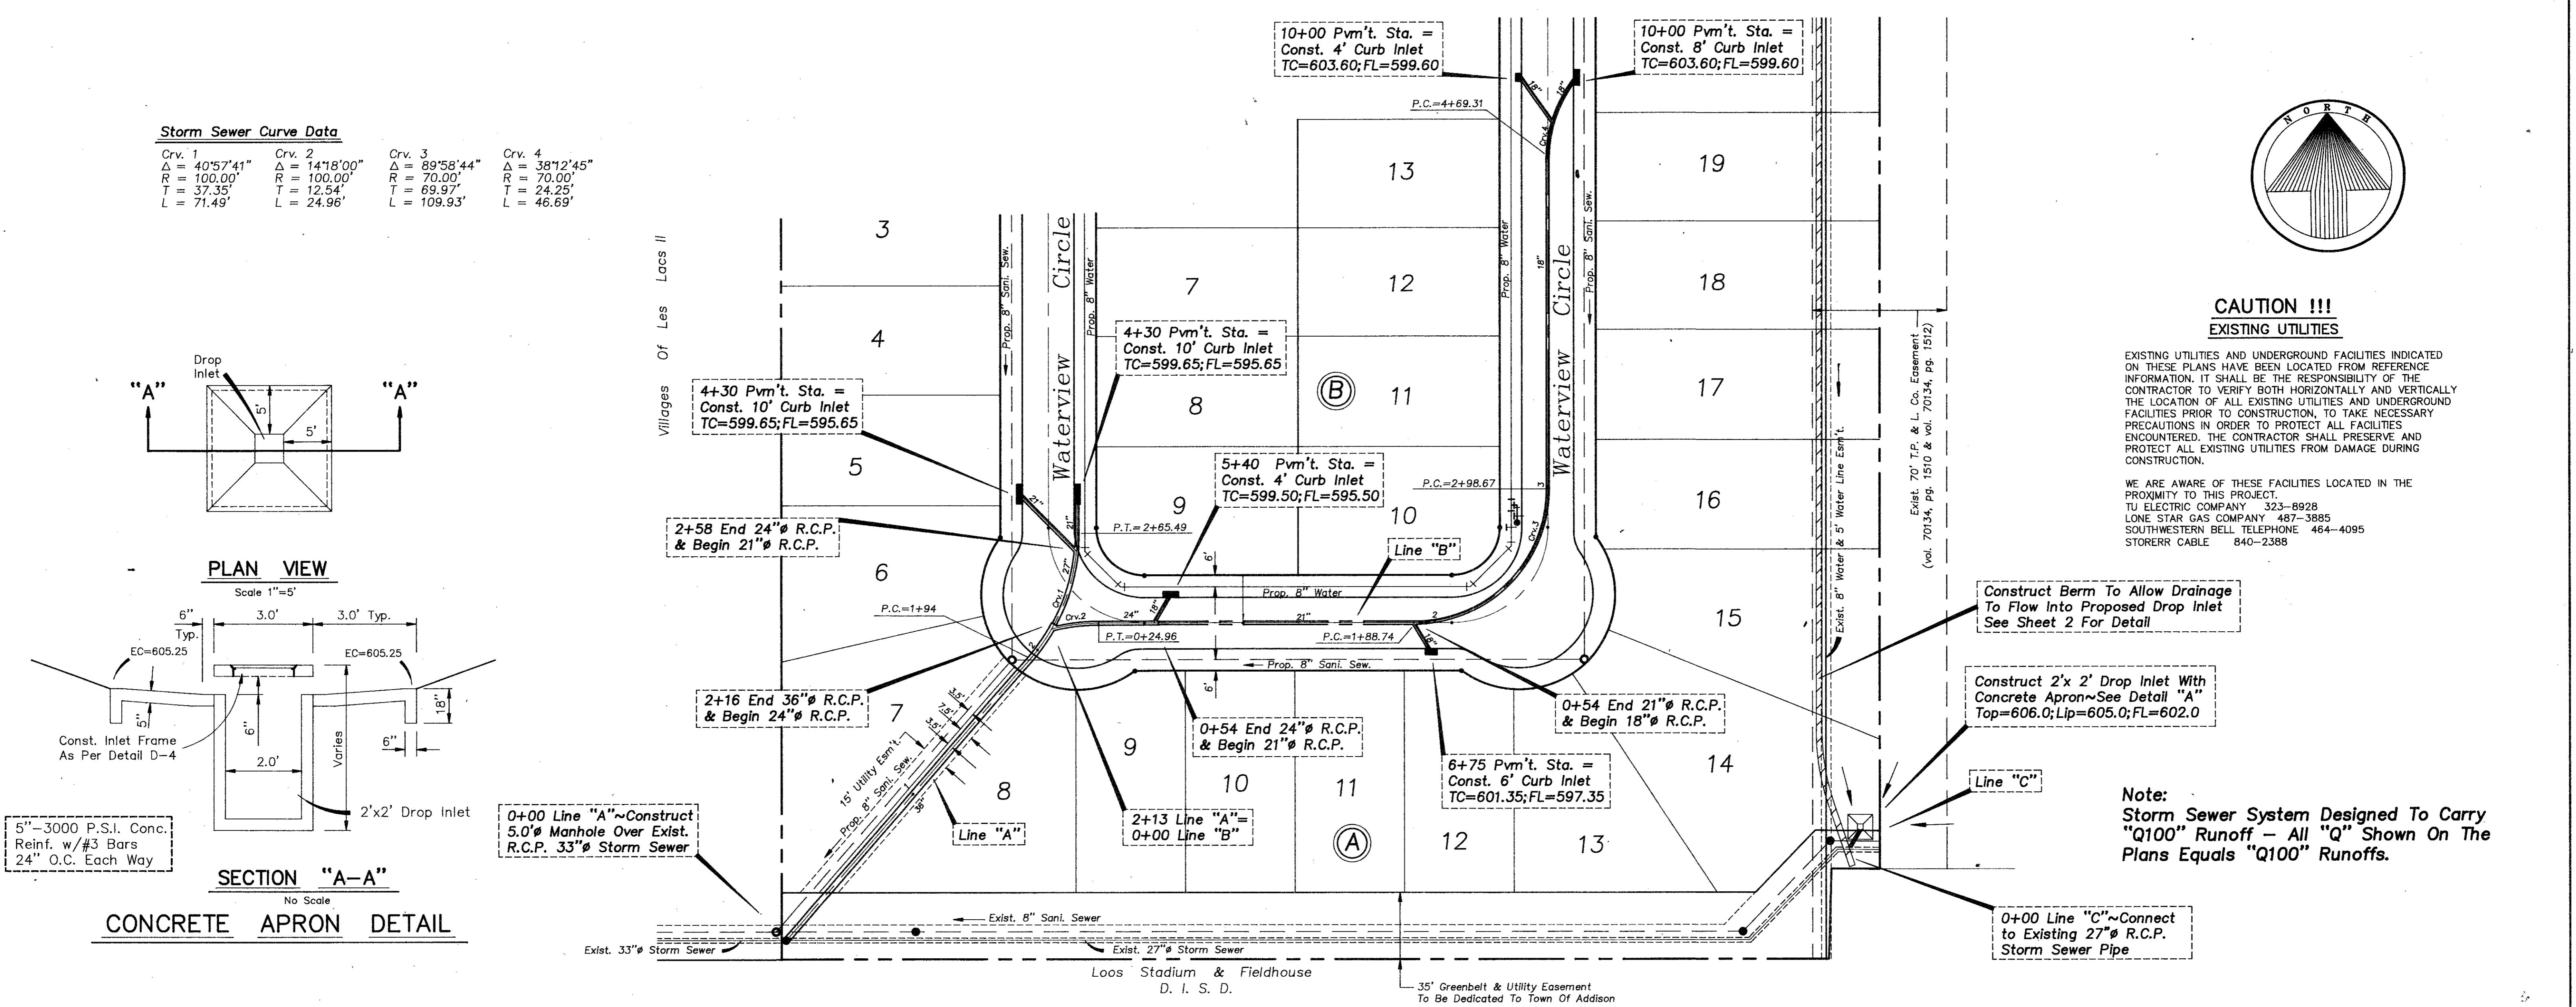

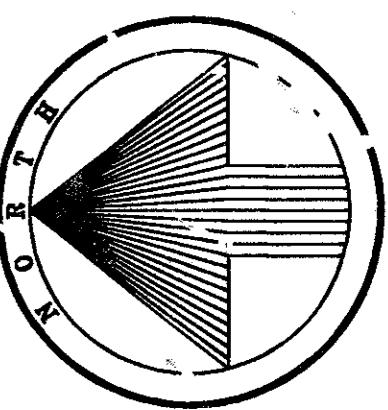

Les Lacs 1

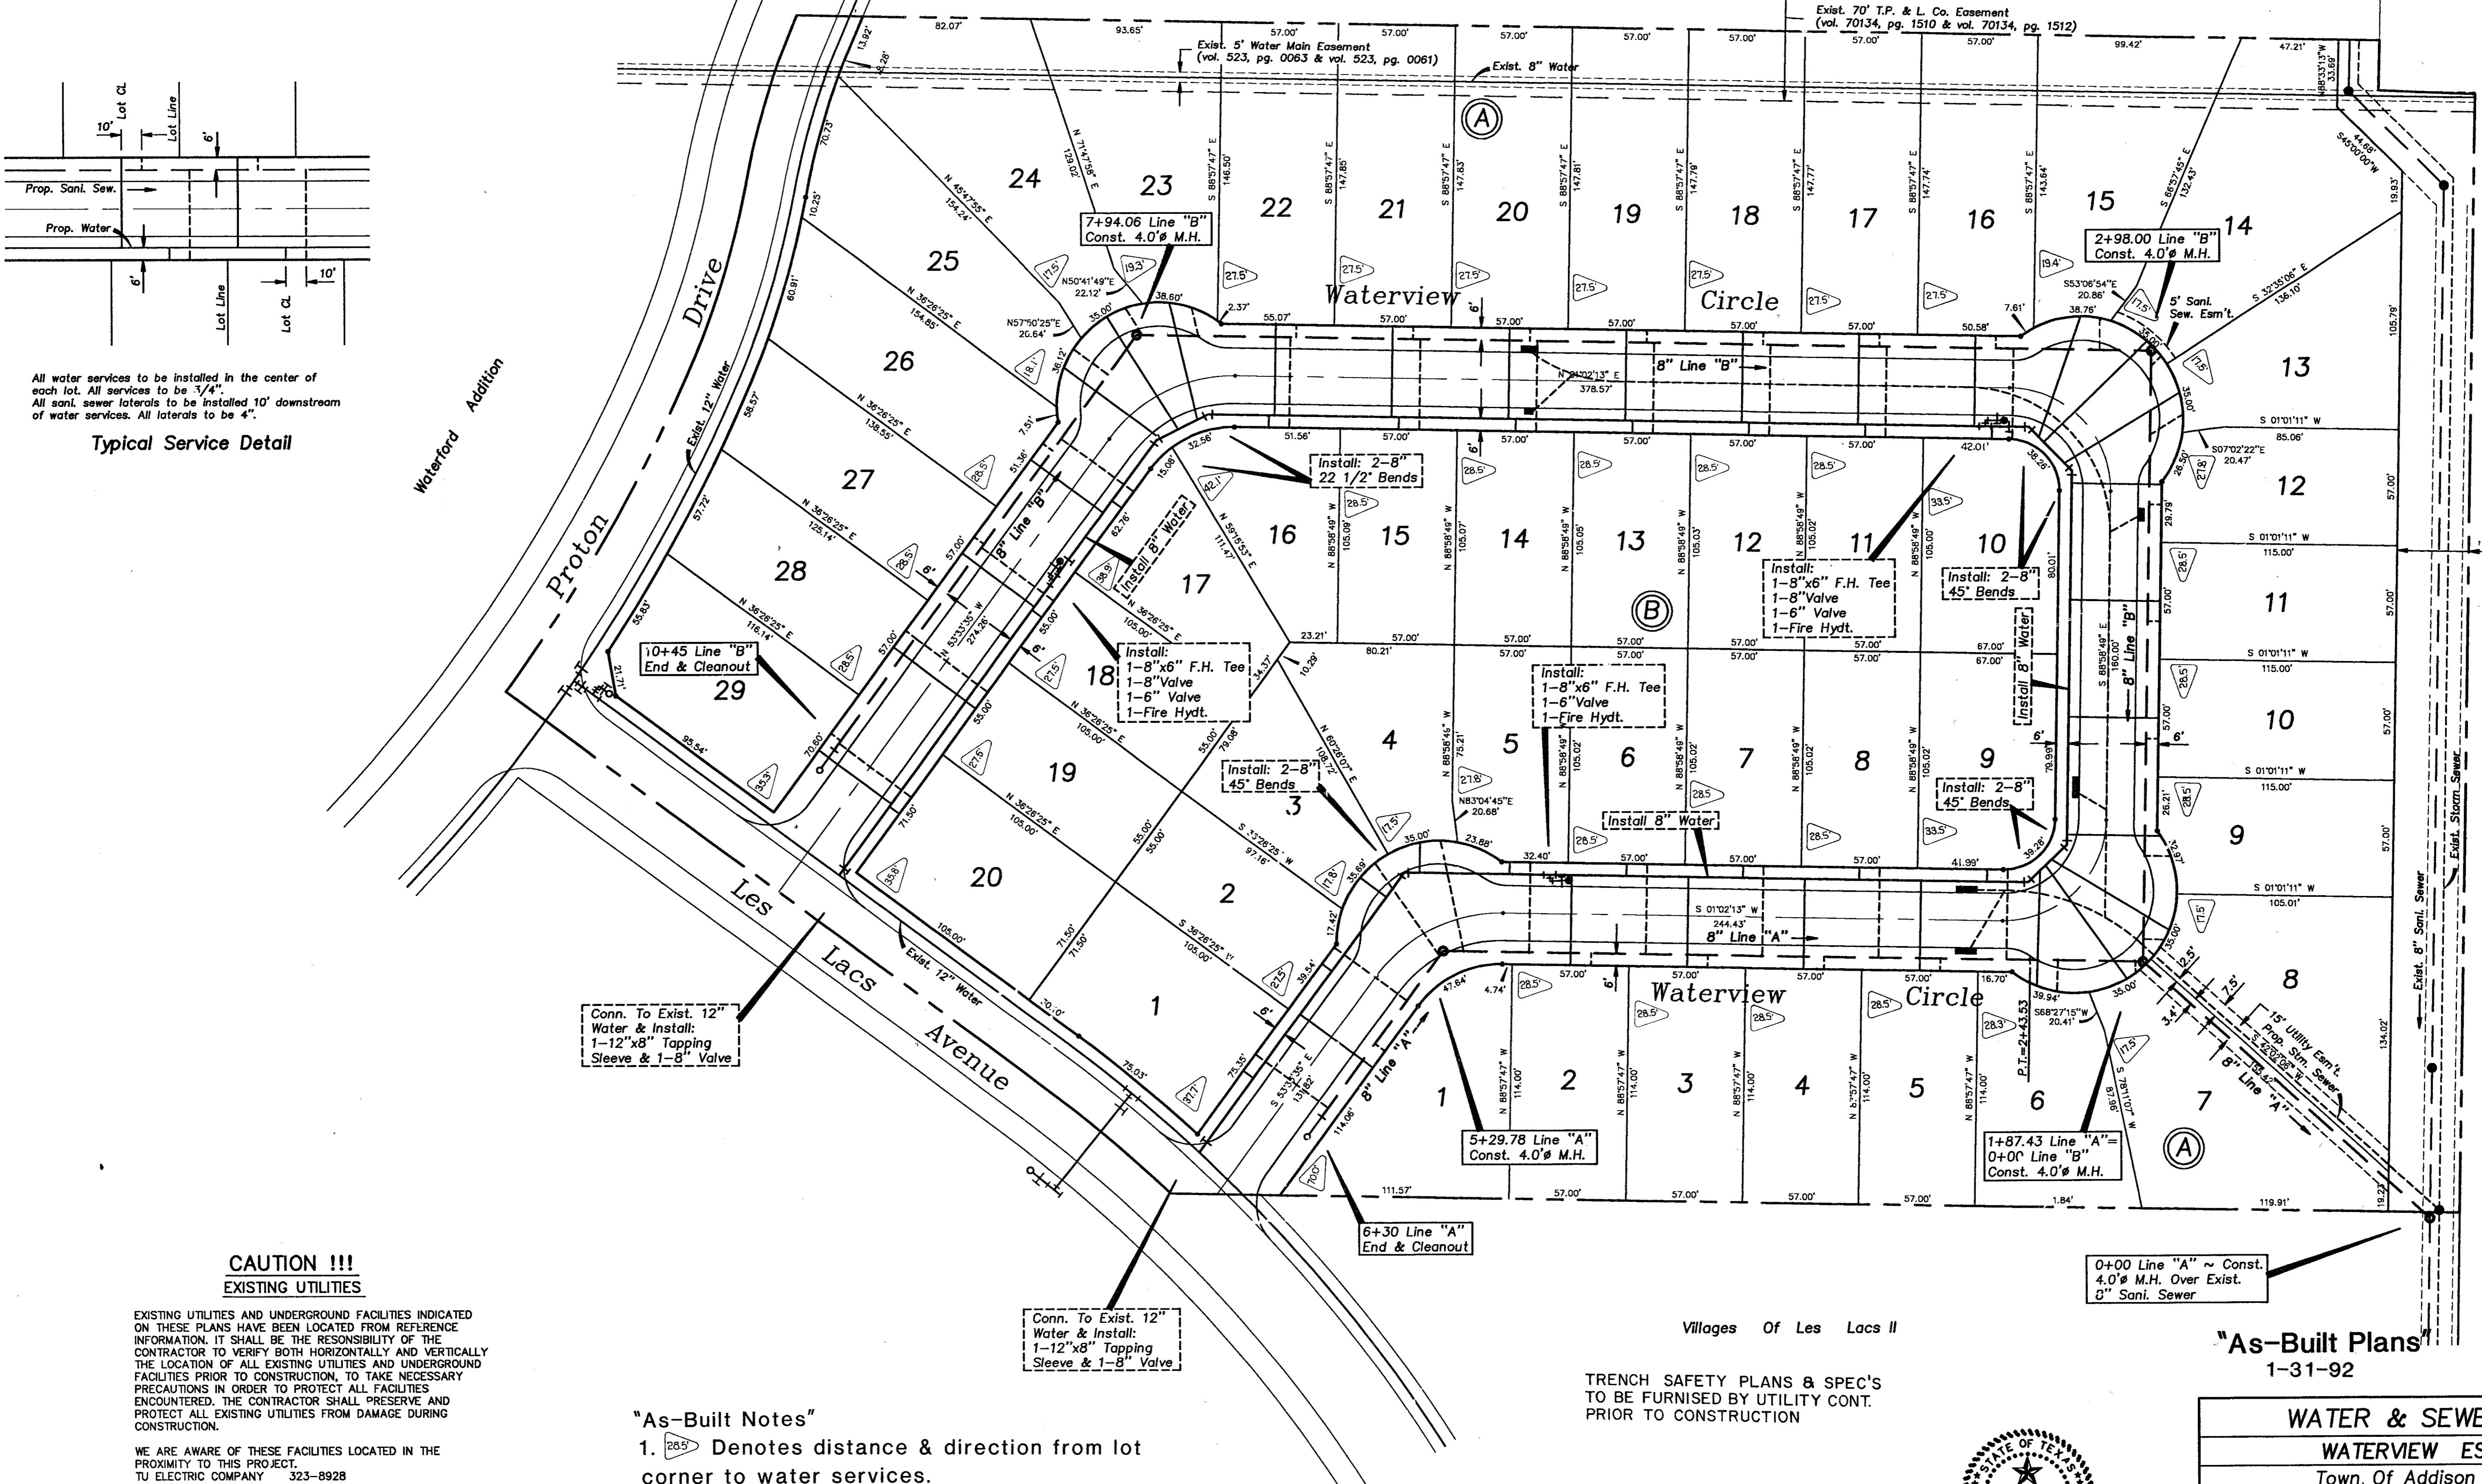

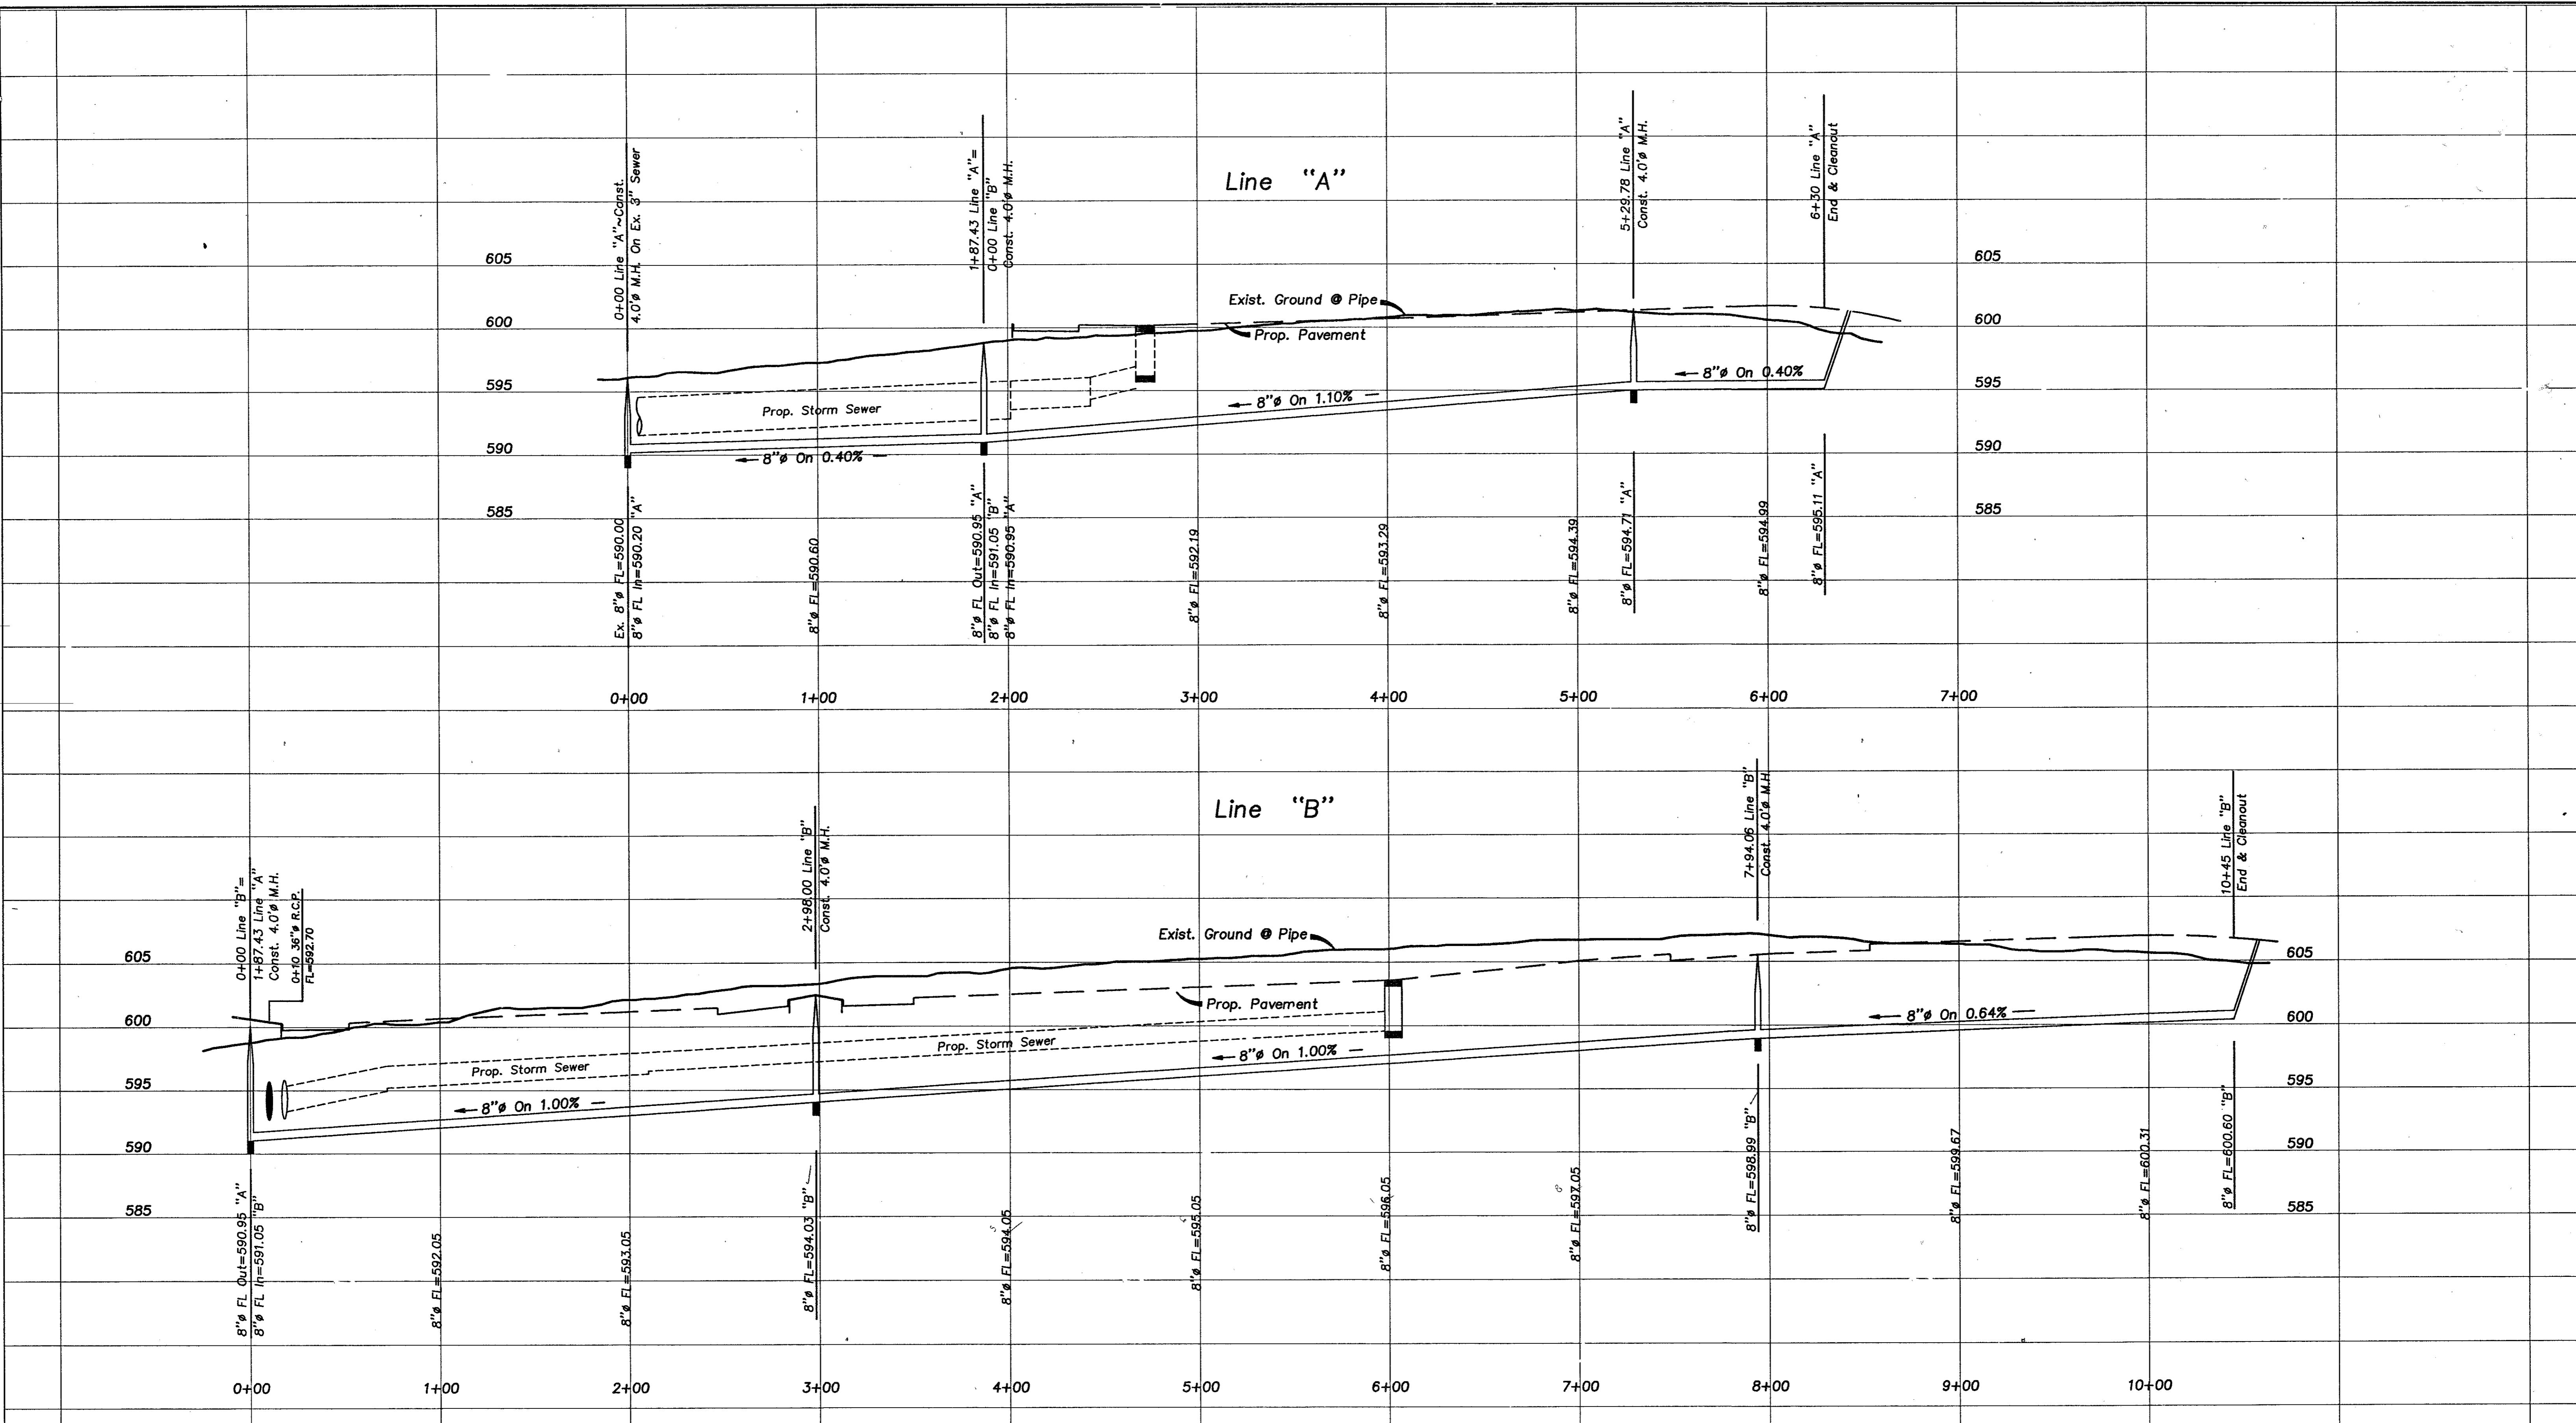

CAUTION !!!

EXISTING UTILITIES

EXISTING UTILITIES LOCATED ON THESE PLANS HAVE BEEN LOCATED FROM REFERENCE INFORMATION. IT SHALL BE THE RESPONSIBILITY OF THE CONTRACTOR TO VERIFY BOTH HORIZONTALLY AND VERTICALLY THE LOCATION OF ALL EXISTING UTILITIES AND UNDERGROUND FACILITIES PRIOR TO CONSTRUCTION, TO TAKE NECESSARY PRECAUTIONS IN ORDER TO PROTECT ALL FACILITIES ENCOUNTERED. THE CONTRACTOR SHALL PRESERVE AND PROTECT ALL EXISTING UTILITIES FROM DAMAGE DURING CONSTRUCTION.

WE ARE AWARE OF THESE FACILITIES LOCATED IN THE PROXIMITY TO THIS PROJECT.
TU ELECTRIC COMPANY 323-8923
LONE STAR GAS COMPANY 487-3885
SOUTHWESTERN BELL TELEPHONE 464-4095
STORECABLE 840-2388

NOTE:
TRENCH SAFETY PLANS & SPECIFICATIONS
TO BE FURNISHED BY UTILITY CONTRACTOR
PRIOR TO UTILITY CONSTRUCTION.

Bench Mark 1
"Top of concrete footing of Southwest corner of tower #12-3W-T291. Elev. 619.46
Bench Mark 2
"Top of curb-South side of Proton Drive, 400' East of Les Lacs Ave. Elev. 611.31(Set)
Bench Mark 3
"Top of concrete footing of Northwest corner of tower #12-3W-T290. Elev. 613.08

TRENCH SAFETY REQUIRED ON ALL
SANITARY SEWER MARKS & ON ALL
STORM SEWER MARKS OVER 5' DEEP
FROM PROPOSED GRADE.

"As-Built Plans"

1-31-92

SANI. SEWER PROFILES

WATERVIEW ESTATES

Town Of Addison , Texas

AT DON A. TIPTON, INC. CONSULTING ENGINEERS



6330 Belt Line Rd. ~ Suite C ~ Garland, Texas 75043

DESIGN DRAWN DATE SCALE NOTES FILE NO.


d.o.t. Inc. J.m.r. 8/91 1"=40'H
1"=6'V

Waterview Estates 3626

7

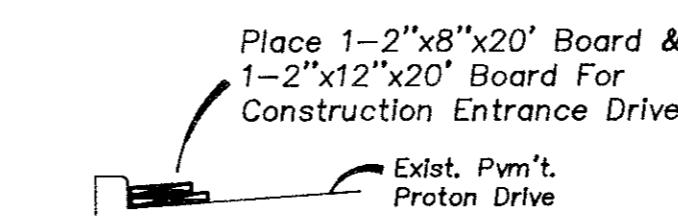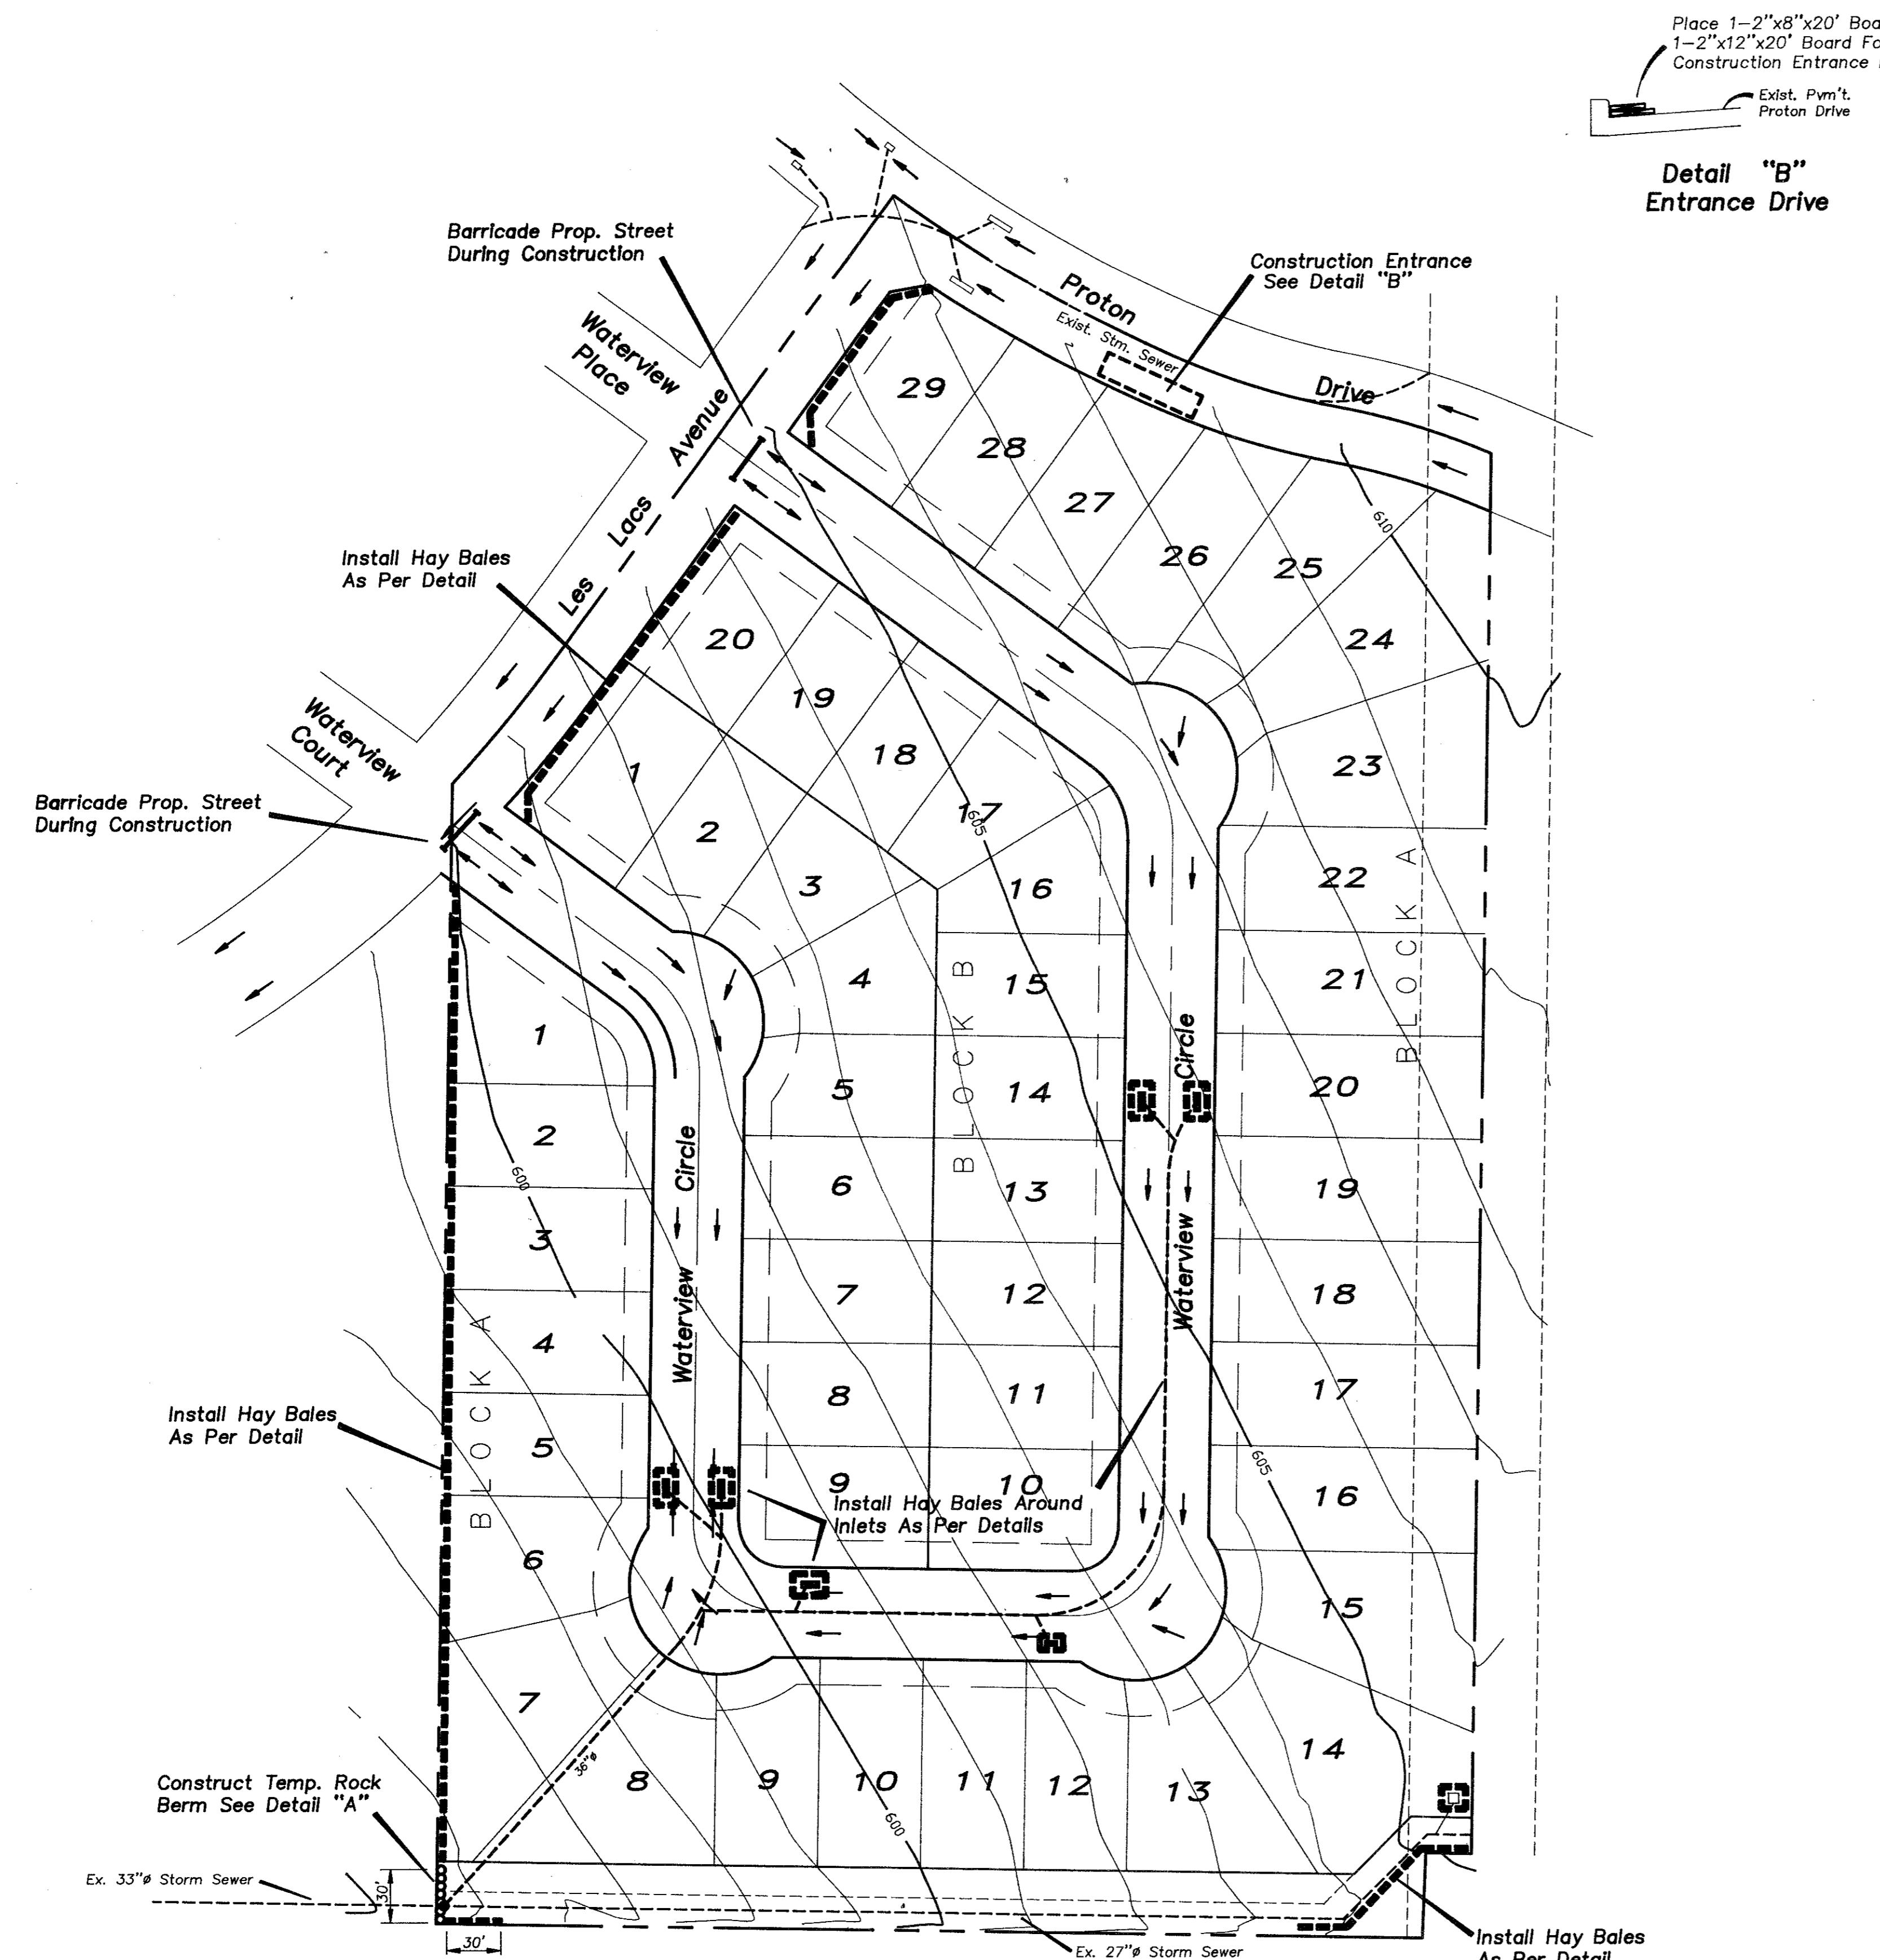

Detail "B"
Entrance Drive

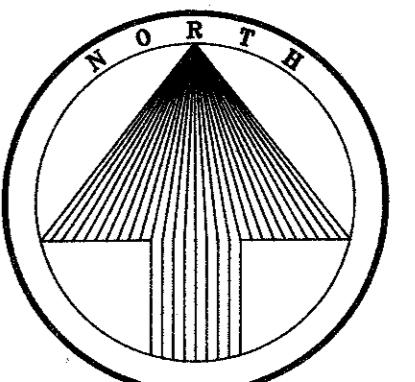

A scale bar diagram consisting of two horizontal bars. The top bar is labeled with numerical values: 60, 30, 0 on the left, and 60, 120 on the right. The bottom bar is a solid black rectangle. A vertical tick mark is located at the 50-foot position on the top bar, corresponding to the midpoint of the bottom bar.

General Notes:


- General Notes:

 1. Contractors Are Responsible For Keeping The Existing Pavement Of Proton Drive & Les Lacs Ave. Clean During Construction.
 2. Greenbelt Area To Be Restored To Original Condition Or Better If Disturbed By Construction.

CONSTRUCTION NOTES:


- CONSTRUCTION NOTES.

 1. Hay bales shall be installed a minimum of 4" into the ground.
 2. Contractor will install additional erosion control where erosion protection is needed as per the owners engineers, or the Town of Addison inspector.
 3. The existing vegetation along existing parkways and medians shall be replaced to its original condition or better.
 4. All drainage swales shall be grassed as per Town Standards, prior to the City acceptance of project.
 5. All construction erosion control shall meet Town of Addisons Ordinance.
 6. Install grass in all new parkway as per Town Standards.

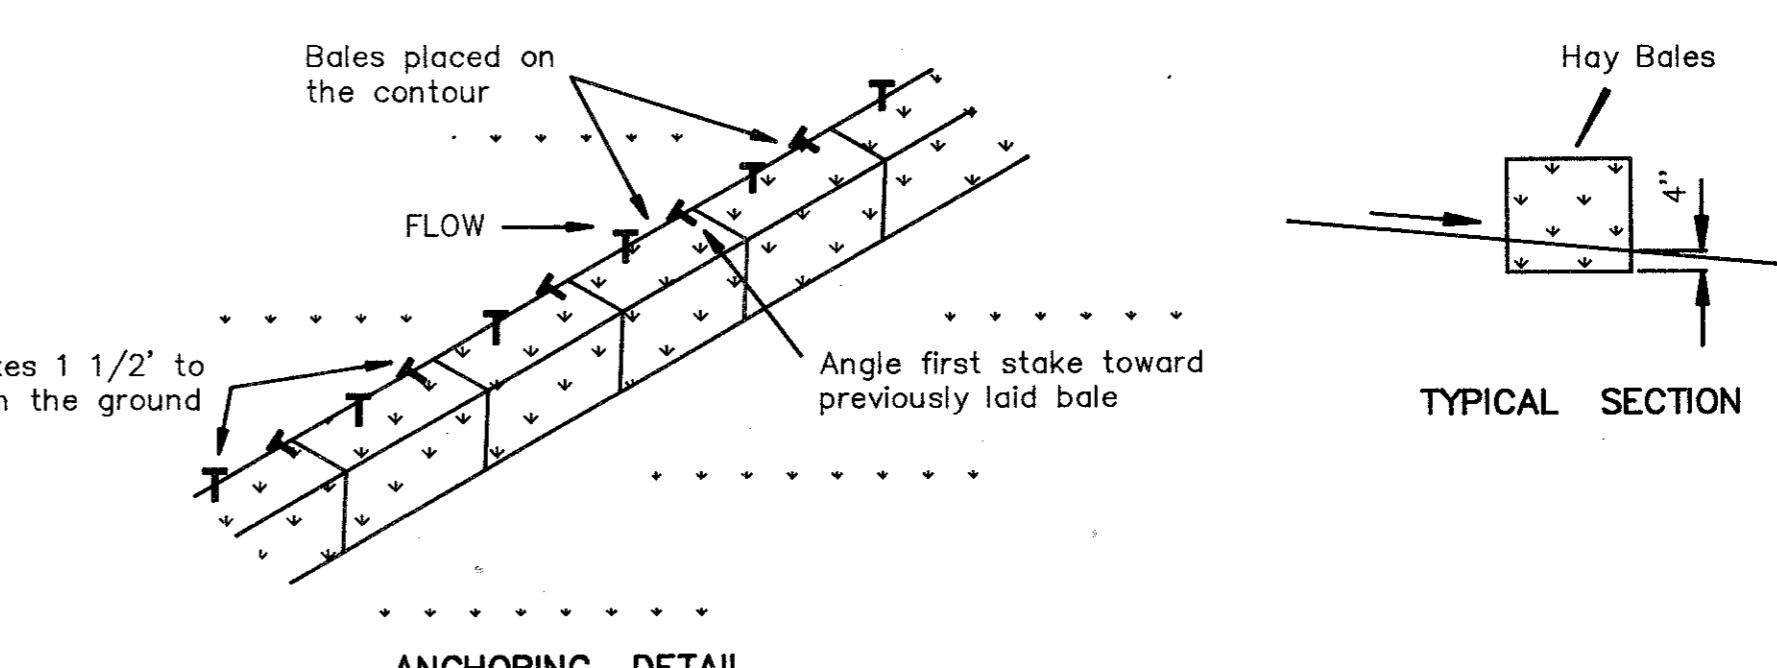

TYPICAL HAY BAFFLE PLACEMENT

Not To Scale

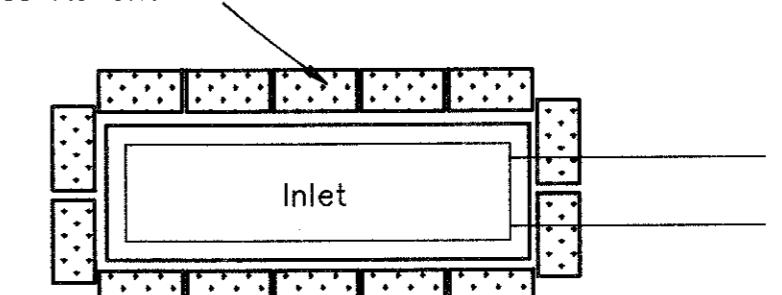

TYPICAL HAY BALE PLACEMENT

AROUND INLETS

Not To Scale

Bench Mark 1
" □ "Top of concrete footing of Southwest corner
of tower #12-3W-T291. Elev. 619.46

Bench Mark 2
" □ "Top of curb South side of Proton Drive, 400'
East of Les Lacs Ave. Elev. 611.31(Set)

Bench Mark 3
" □ "Top of concrete footing of Northwest corner
of tower #12-3W-T290. Elev. 613.08



"As-Built Plans"

1-31-92

EROSION CONTROL
WATERVIEW ESTATES
Town Of Addison, Texas