



- General Notes:
- Contractors Are Responsible For Keeping The Existing Pavement Of Proton Drive & Les Lacs Ave. Clean During Construction.
 - Greenbelt Area To Be Restored To Original Condition Or Better If Disturbed By Construction.

- CONSTRUCTION NOTES:
- Hay bales shall be installed a minimum of 4" into the ground.
 - Contractor will install additional erosion control where erosion protection is needed as per the owners engineers, or the Town of Addison inspector.
 - The existing vegetation along existing parkways and medians shall be replaced to its original condition or better.
 - All drainage swales shall be grassed as per Town Standards, prior to the City acceptance of project.
 - All construction erosion control shall meet Town of Addisons Ordinance.
 - Install grass in all new parkway as per Town Standards.

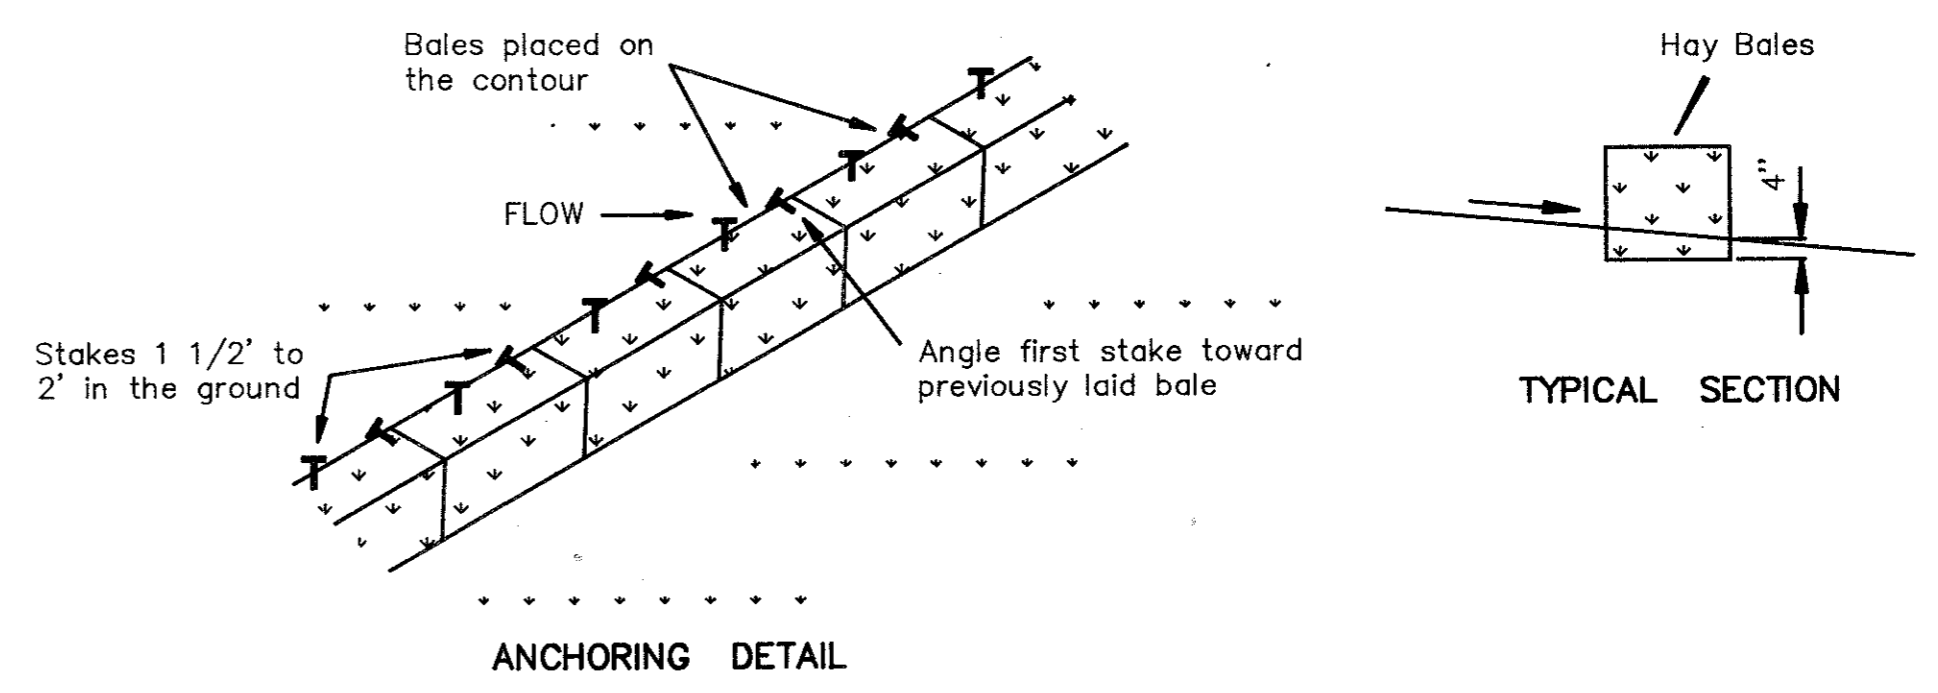


TYPICAL HAY BALE PLACEMENT

Not To Scale

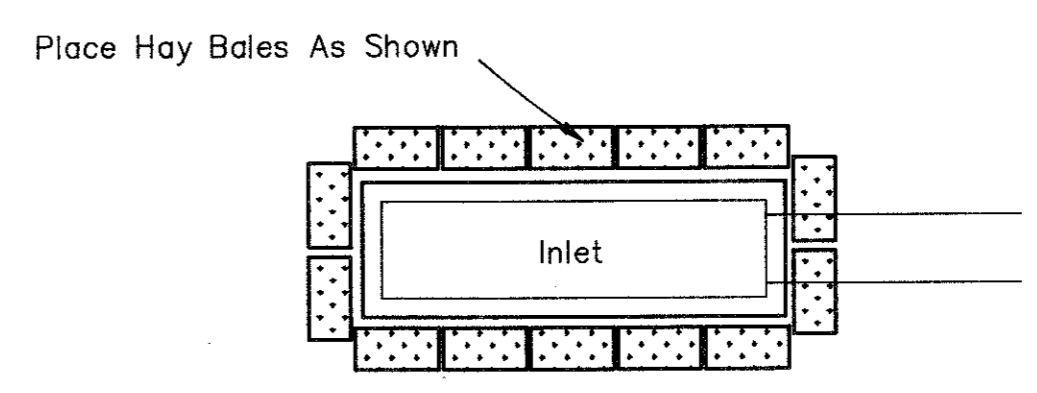

TYPICAL HAY BALE PLACEMENT AROUND INLETS

Not To Scale

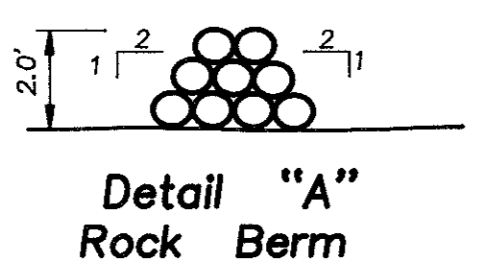

- Bench Mark 1
 "□" Top of concrete footing of Southwest corner of tower #12-3W-T291. Elev. 619.46
- Bench Mark 2
 "□" Top of curb South side of Proton Drive, 400' East of Les Lacs Ave. Elev. 611.31(Set)
- Bench Mark 3
 "□" Top of concrete footing of Northwest corner of tower #12-3W-T290. Elev. 613.08

"As-Built Plans"
 1-31-92



EROSION CONTROL						
WATERVIEW ESTATES						
Town Of Addison, Texas						
don a.t. DON A. TIPTON, INC. CONSULTING ENGINEERS						
6330 Belt Line Rd. ~ Suite C ~ Garland, Texas 75043						
DESIGN	DRAWN	DATE	SCALE	NOTES	FILE	NO.
d.a.t. inc.	d.a.t. inc.	7/91	1"=60'	d.b.	Waterview Estates 3626	8