


Revisions	Date	Description	Drawn By	Checked By

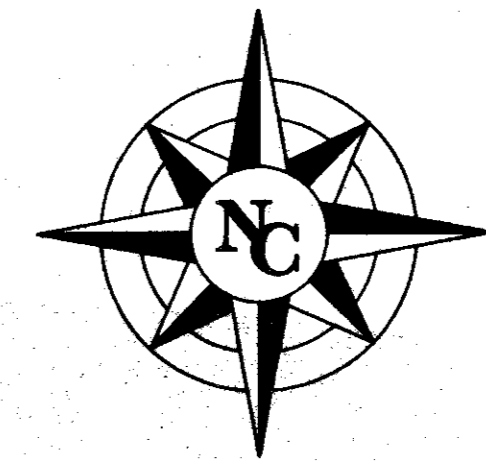

**WEST FIELD COURT**

PLANT LIST  
OCTOBER 2, 1991  
NC#90025-3/PLANTLIST

QTY	PLAN NAME/COMMON NAME	BOTANICAL NAME	SIZE	MIN. HG/SPRD.	ROOT CONDITION	COMMENT
20	DWF. BURFORD HOLLY	ILEX CORNUTA "BURFORDII" NANA	5 GAL	24" H/14"	CONTAINER	
56	"CRIMSON PYGMY" BARBERRY	BERBERIS THUNBERGII ATROPURPUREA ("CRIMSON PYGMY")	1 GAL	9" H/9"	CONTAINER	
72	L.F. STEEL EDGING			1/8" X 4"		RYERSON OR EQUAL
3	C.Y. CYPRESS MULCH					
4,400	S.F. HYDROMULCH					RYE SHALL BE HYDROMULCHED THIS FALL IN SPRING (APPROX. MID APRIL) RYE SHALL BE SCALPED AND LAWN AREA SHALL BE HYDROSEEDED WITH BERMUDA.

- NOTES:
- 1) ALL MATERIAL SHALL BE GUARANTEED FOR 1 YEAR.
  - 2) LOCATE ALL EXISTING UTILITIES PRIOR TO INSTALLATION. IF THERE ARE CONFLICTS BETWEEN LANDSCAPE AND EXISTING UTILITIES, NOTIFY THE LANDSCAPE ARCHITECT.
  - 3) LANDSCAPE CONTRACTOR WILL SUBCONTRACT THE IRRIGATION WORK. PROVIDE A SEPARATE LINE ITEM ON BID FOR CORPORATION FEE. THE SELECTED CONTRACTOR WILL PROVIDE AN IRRIGATION PLAN AND SPECIFICATIONS TO THE LANDSCAPE ARCHITECT FOR APPROVAL PRIOR TO INSTALLATION.
  - 4) PROVIDE NAMES, ADDRESSES AND PHONE NUMBER OF ALL SUB-CONTRACTORS.
- ALTERNATES:
- 1) BID AS AN ALTERNATE THE ONE YEAR MAINTENANCE OF ALL INSTALLED MATERIAL. (SUBMIT MAINTENANCE SCHEDULE WITH BID)


NOTES: WALL LOCATION TO FOLLOW CITY OF PLANO STANDARD CONSTRUCTION DETAILS.

ALL STRUCTURAL DETAILS ARE FROM CITY OF PLANO CONSTRUCTION DETAILS.

CONTRACTOR SHALL VERIFY ALL UTILITY LOCATIONS, EASEMENTS, SIGHT LINES, ECT. PRIOR TO CONSTRUCTION.


BRICK SIZE SHALL BE BIG JOHN. BRICK COLOR SHALL BE ACME'S "OLD COLONIAL" WITH LESS WHITES AND MORE GRAYS OR EQUAL. SELECTED CONTRACTOR SHALL PROVIDE SAMPLE BOARD FOR OWNER'S APPROVAL PRIOR TO CONSTRUCTION.

SPECIAL PAVING SHALL BE BOMANITE PATTERN "FISHSCALE COBBLESTONE WITH DEEP SET-IMPRINT". BOMANITE COLOR SHALL BE COBBLESTONE GRAY. BOMANITE PAVING SHALL CONFORM TO TOWN OF ADDISON STANDARDS.

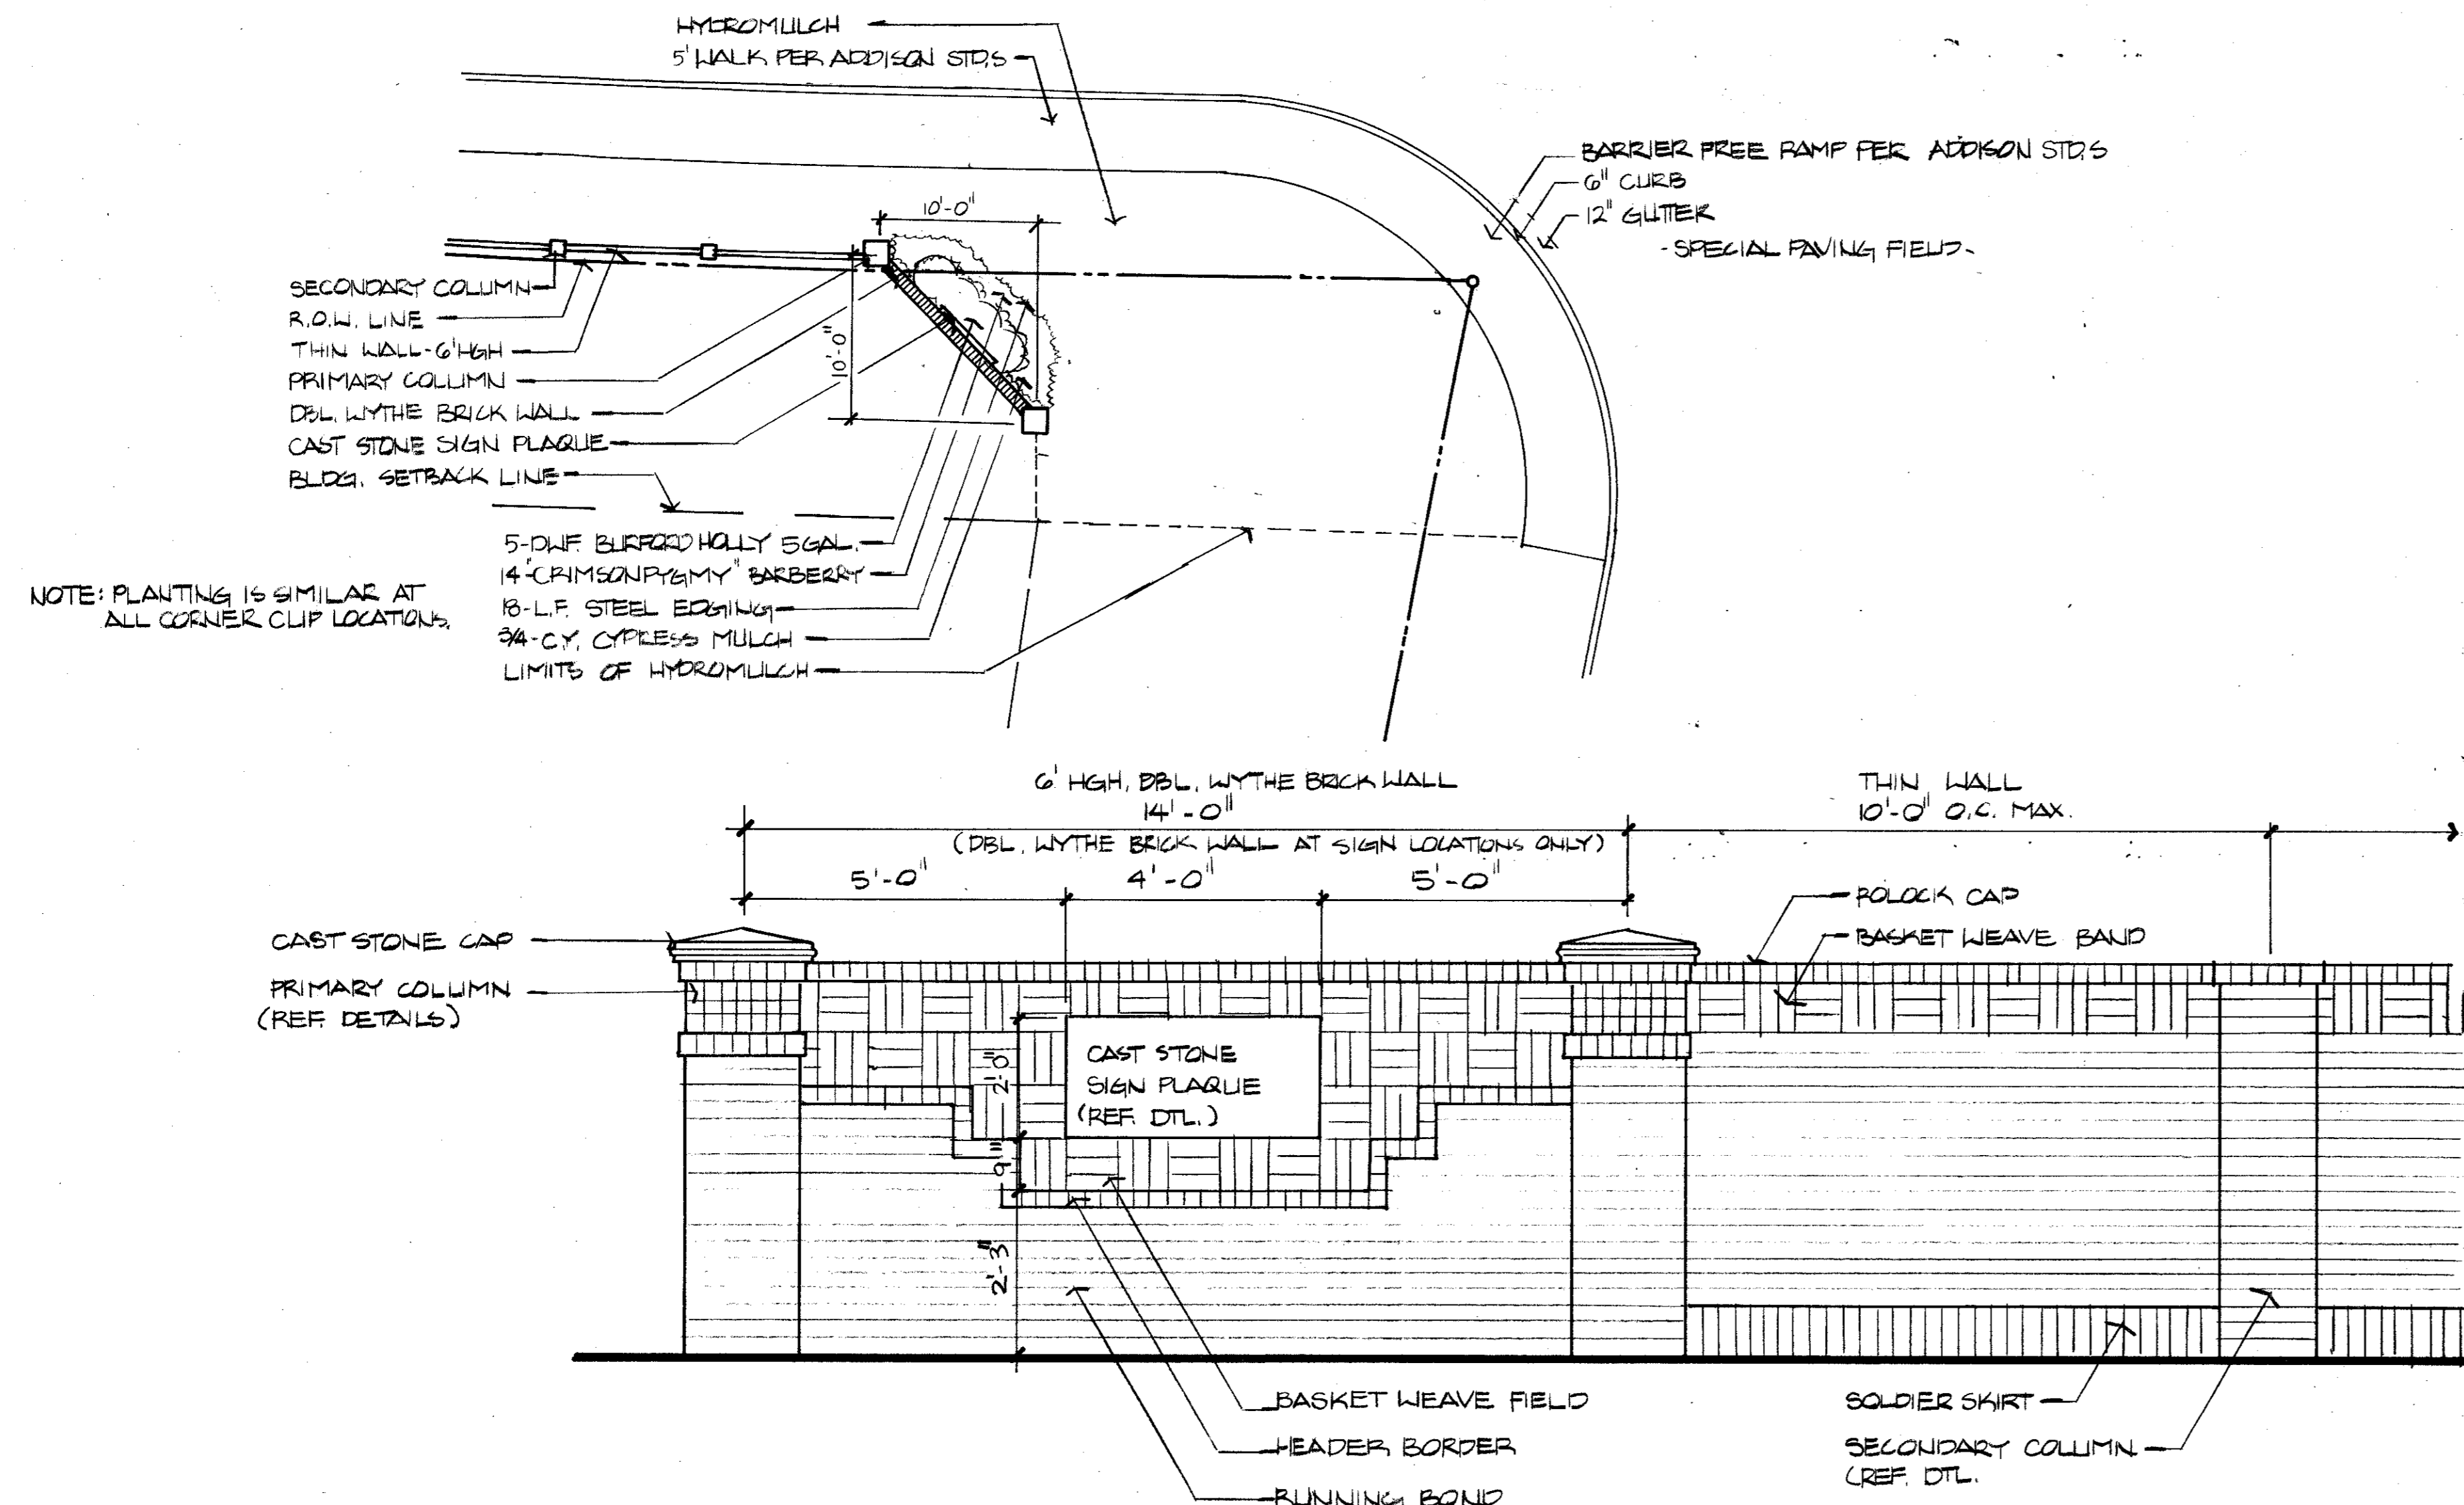

**WALL ELEVATION**

SCALE: 1/2" = 1'-0"

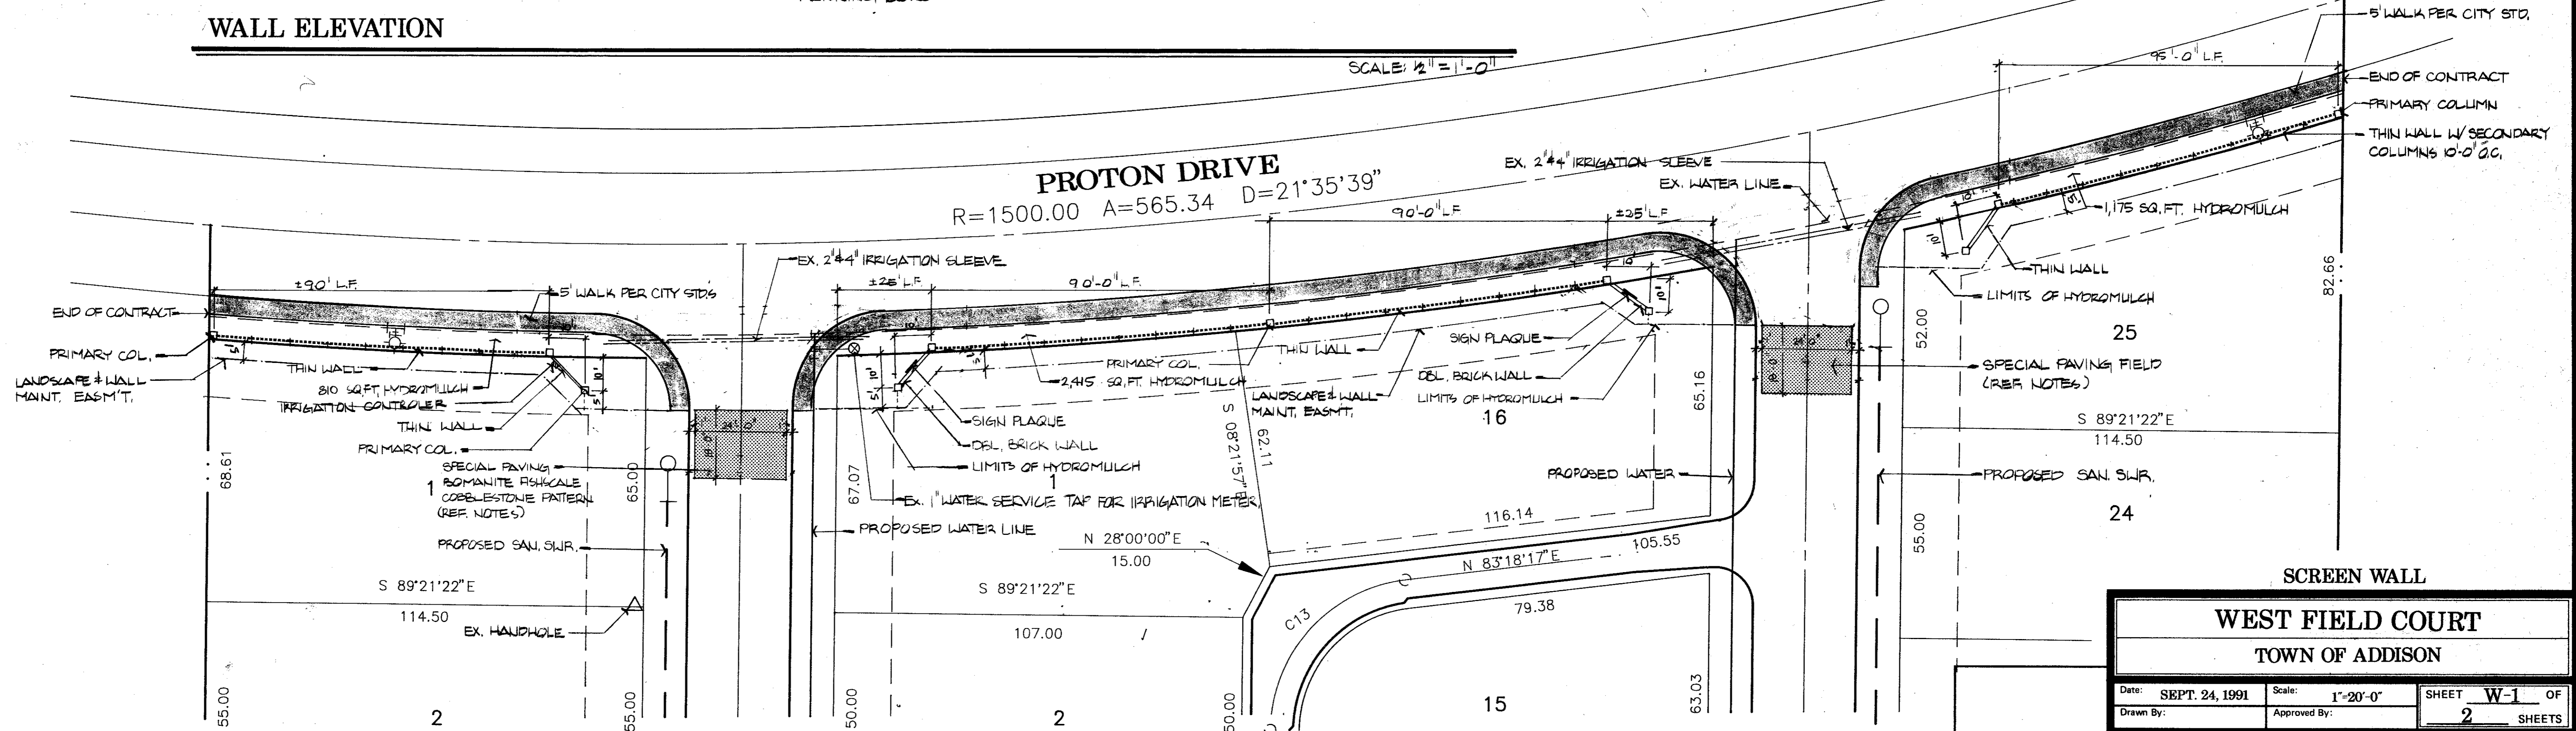

**SCREEN WALL**

**WEST FIELD COURT**  
TOWN OF ADDISON

Date: SEPT. 24, 1991    Scale: 1"=20'-0"    SHEET **W-1** OF 2 SHEETS

Drawn By:    Approved By:

**NC THE NELSON CORPORATION**  
LAND PLANNING • ENGINEERING • SURVEYING  
5999 SUMMERSIDE DRIVE • SUITE 202 • DALLAS, TEXAS 75252 • (214) 380-2605