


AS BUILT

BENCH MARKS:

Box cut in the northwest corner of the concrete foot of Tower No. 12N-2W-T294 at the intersection of the transmission lines with Midway Road. ELEV. 607.46

Box cut in the concrete curb, located at the northeast corner of site. ELEV. 615.92

Box cut in the northwest corner of the concrete foot of Tower No. 12N-3W-T290 at the angle point of the transmission line. ELEV. 613.16

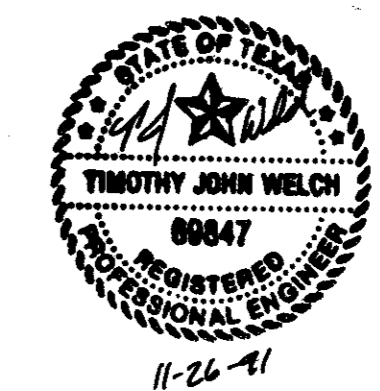

SANITARY SEWER PROFILE						
WESTFIELD COURT						
TOWN OF ADDISON, TEXAS						
THE NELSON CORPORATION LAND PLANNING • ENGINEERING • SURVEYING 5999 SUMMERSIDE DRIVE • SUITE 202 • DALLAS, TEXAS 75252 • (214) 380-2605						
DESIGN	DRAWN	DATE	SCALE	NOTES	FILE	NO.
N.E.C.	N.E.C.	JUNE 1991	1"=100' H. 1"= 6" V		90025-3	WS-2

TEL: 214-380-2605 FAX: 214-380-2605