
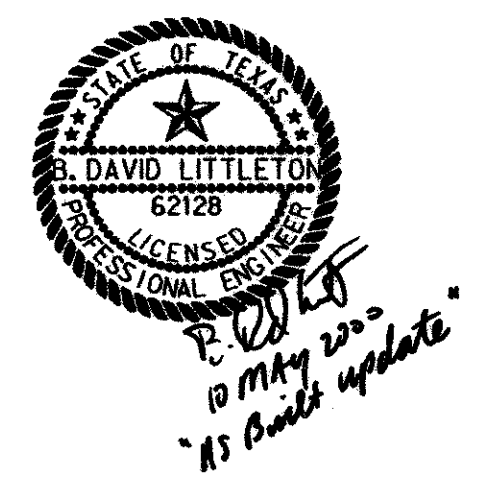


DRAINAGE AREA NO.	AREA (ACRES)	RUNOFF COEFF 0.00	INLET TIME (MIN)	1 100	0 100 (CFS)
A-1	0.24	0.90	10	8.74	1.9
A-2	0.33	0.90	10	8.74	2.6
A-3	0.34	0.90	10	8.74	2.7
A-4	0.22	0.90	10	8.74	1.7
B-1	0.34	0.90	10	8.74	2.7
B-2	0.44	0.90	10	8.74	3.5
B-3	0.86	0.90	10	8.74	6.8
C-1	0.91	0.90	10	8.74	7.2
D-1	0.51	0.90	10	8.74	4.0
D-2	0.53	0.90	10	8.74	4.2
E-1	1.82	0.90	10	8.74	14.3
F-1	0.23	0.90	10	8.74	1.8
G-1	0.13	0.90	10	8.74	1.0
H-1	0.30	0.90	10	8.74	2.4
O-1	0.22	0.90	10	8.74	1.7
O-2	0.16	0.90	10	8.74	1.3
T-1	0.02	0.90	10	8.74	0.16

DRAINAGE AREA DESIGN CRITERIA

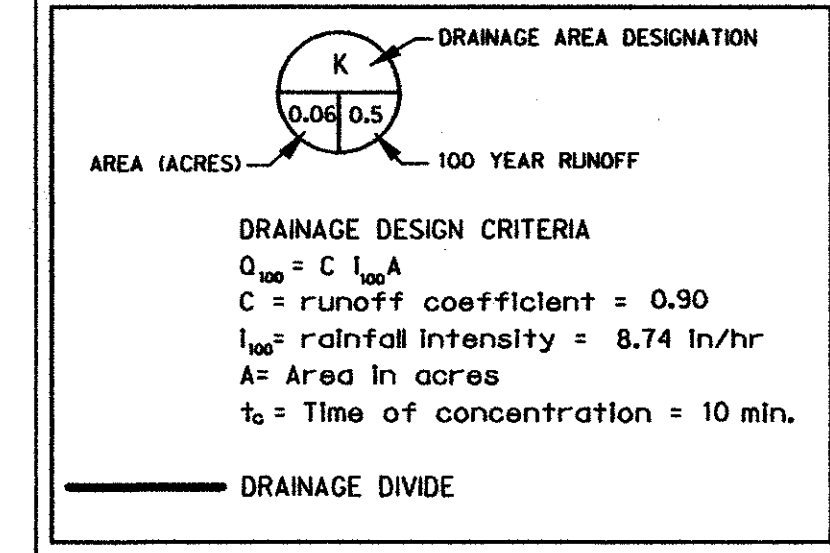

- △ "AS BUILT" BASED ON FIELD OBSERVATIONS OF SURFACE FEATURES ON MAY 4, 2000 AND CONTRACTOR PROVIDED INFORMATION. ELEVATIONS NOT FIELD VERIFIED. PARKING STRIPING NOT COMPLETED IN FIELD.
- △ 02-08-00, ADDED TRUCK WELL DRAINAGE AREA.
- △ 11-16-99, CHANGES TO DRAINAGE AREA DUE TO RELOCATED DUMPSTER.

BENCHMARK:
 "X" CUT IN CONCRETE AS THE NORTHWEST CORNER OF THE SUBJECT TRACT.
 ELEV = 645.20

DRAINAGE AREA MAP
 ADDISON COM CENTER
 JACKSON - SHAW COMPANY
 TOWN OF ADDISON, TEXAS

Half Associates
 ENGINEERS • ARCHITECTS • SCIENTISTS • PLANNERS • SURVEYORS

DESIGN	DRAWN	DATE	SCALE	NOTES	FILE	NO.
HALFF	CADD	SEPTEMBER 1999	1" = 40'	AVO 17986 986DAM		C-1