


AS-BUILT
 BASED ON FIELD OBSERVATIONS OF
 SURFACE FEATURES ON MAY 4, 2000
 AND CONTRACTOR PROVIDED INFORMATION.
 ELEVATIONS NOT FIELD VERIFIED. PARKING
 STRIPING NOT COMPLETED IN FIELD.

MODIFIED ALIGNMENT OF LINE D-2

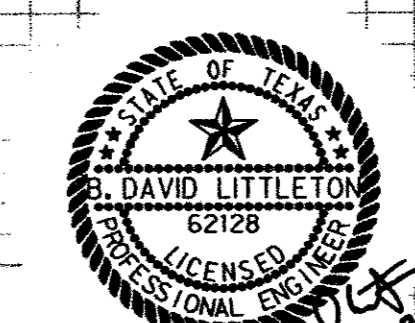

STORM DRAIN PROFILES
ADDISON COM CENTER
JACKSON - SHAW COMPANY
TOWN OF ADDISON, TEXAS

Half Associates
 ENGINEERS • ARCHITECTS • SCIENTISTS • PLANNERS • SURVEYORS

DESIGN	DRAWN	DATE	SCALE	NOTES	FILE	NO.
HALFF	CADD	SEPTEMBER 1999	1"=40' H, 1"=3' V	17986 986PROF-1		C-4