


# TOWN OF ADDISON

## ADDISON COM CENTER

*JACKSON - SHAW*  
COMPANY


ADDISON, TEXAS  
SEPTEMBER, 1999

AVO. NO. 17986

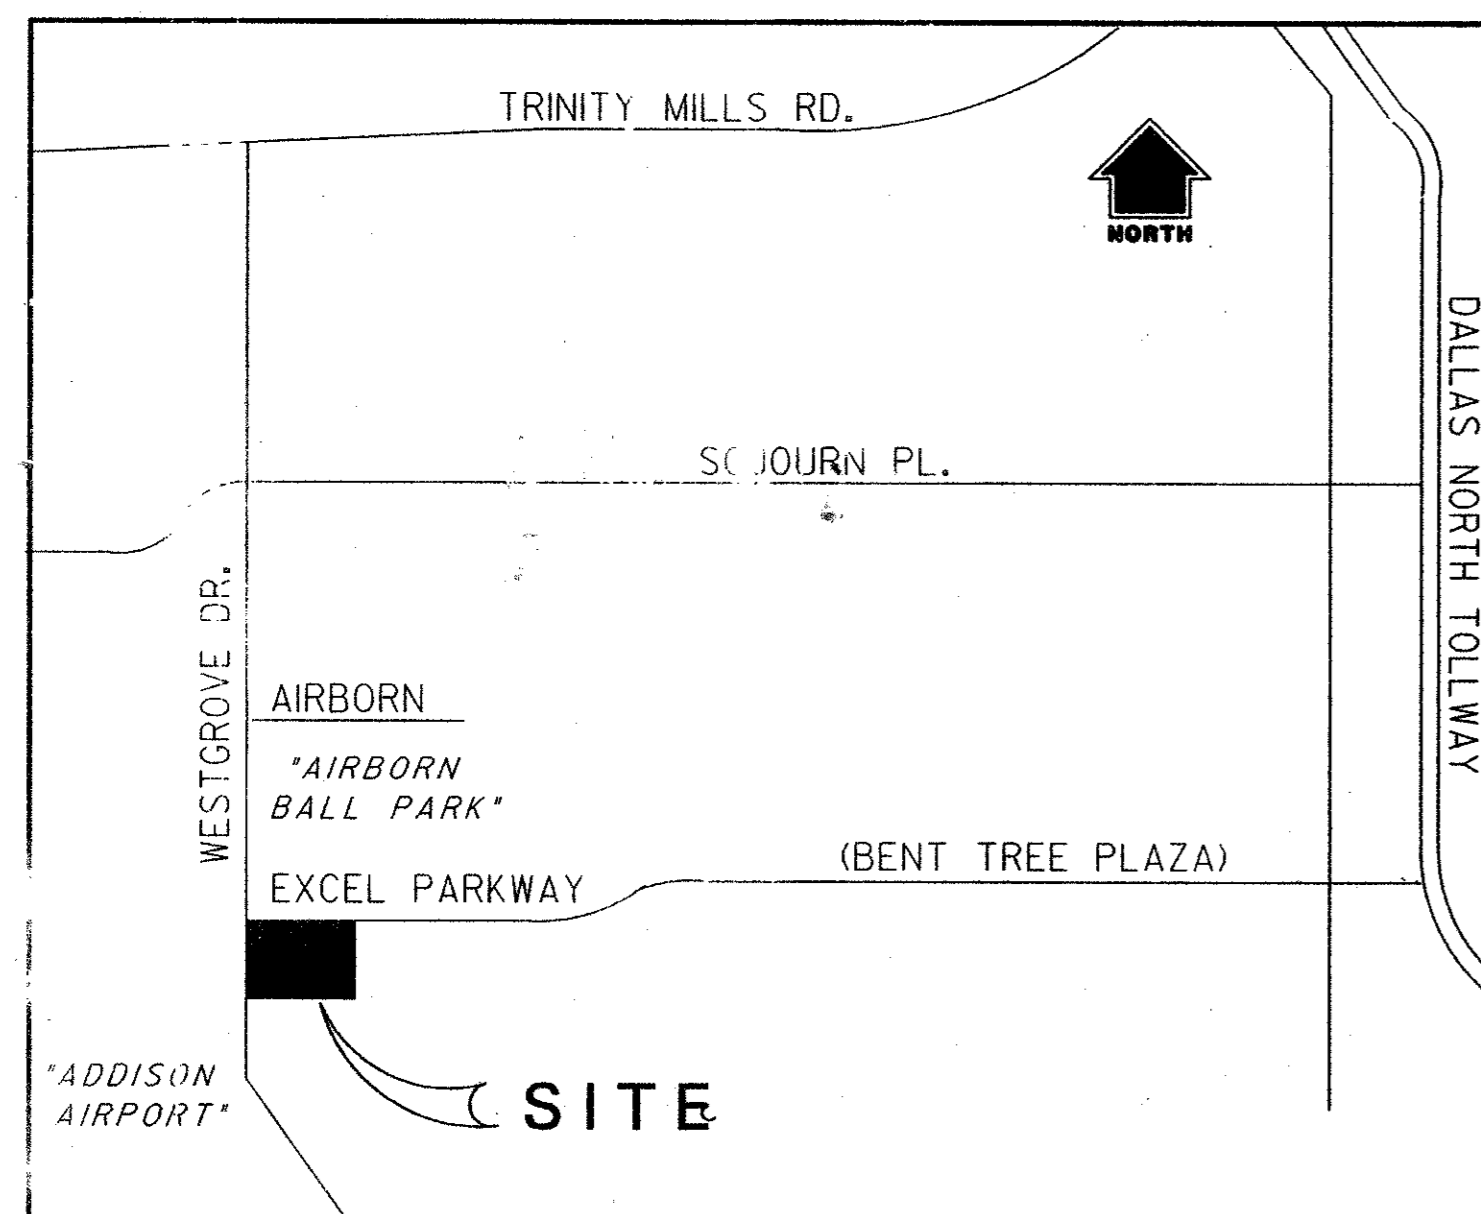

LOCATION MAP  
N.T.S.

 **Half Associates**  
ENGINEERS . ARCHITECTS . SCIENTISTS . PLANNERS . SURVEYORS

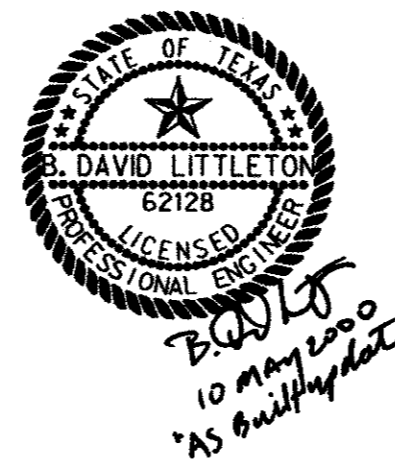

"AS-BUILT"  
BASED ON FIELD OBSERVATIONS OF  
SURFACE FEATURES ON MAY 4, 2000 AND  
CONTRACTOR PROVIDED INFORMATION  
ELEVATION NOT FIELD VERIFIED.  
PARKING STRIPING NOT COMPLETED IN FIELD.

SHEET INDEX	
SHEET NUMBER	TITLE
	COVER SHEET / INDEX
	PLAT 1 / 2
	PLAT 2 / 2
	BOUNDARY SURVEY
C-1	DRAINAGE AREA MAP
C-2	GRADING PLAN
C-3	STORM DRAINAGE PLAN
C-4	STORM DRAINAGE PROFILE
C-4A	STORM DRAINAGE CALCULATIONS & DETAILS
C-5	WATER & SANITARY SEWER PLAN
C-6	EROSION CONTROL PLAN
C-7	EROSION CONTROL DETAILS
C-8	PAVING PLAN
C-9	PAVING DETAILS