


Runoff Collection Point	Distance Between Collection Points	Area Drainage	Incremental Runoff Coeff.	Incremental Drainage Area Inc.	Accumulated Drainage Area	Time at Upstream Station	Design Storm Frequency	Intensity "I"	Storm Water Runoff "Q"	Slope of Hydraulic Gradient "S"	Selected Storm Sewer Size	Velocity Between Collection Pts. "V"	Head Loss Coeff. "Kj"	Velocity Head Loss At Upstream Station	Flow Time in Sewer	Time at Downstream Station	H1	H2	REMARKS		
Upstream Station	Downstream Station	Collection Points	No.	Area "A"	"C"	"CA"	(min)	(yrs.)	(inches/hr)	(c.f.s.)	(ft/ft)	(inches)	(f.p.s.)	"Kj"	(feet)	(min)	(min)				
Storm Drain Line "A"																					
24"x24" GRATE INLET	4+08.0	120.00	A4	0.22	0.9	0.20	0.20	10.00	100	8.74	1.73	0.0003	18	0.98	1.25	0.02	2.04	10.00	642.22	642.24	Top = 643.75
24"x24" GRATE INLET	2+68.0	140.00	A3	0.34	0.9	0.31	0.50	10.00	100	8.74	4.40	0.0018	18	2.49	0.50	0.05	0.94	10.00	642.14	642.19	Top = 643.5
30"x30" GRATE INLET	1+58.0	110.00	A2	0.33	0.9	0.30	0.80	10.00	100	8.74	7.00	0.0020	21	2.91	0.50	0.07	0.63	10.00	641.83	641.89	Top = 643.5
30"x30" GRATE INLET	0+00	158.00	A1	0.24	0.9	0.22	1.02	10.00	100	8.74	8.89	0.0031	21	3.70	0.50	0.15	0.71	10.00	641.47	641.61	Beginning Hg = 640.97, Top = 643.75
Storm Drain Line "B"																					
6' INLET	1+99.5	6.30	B-1	0.34	0.9	0.31	0.31	10.00	100	8.74	2.67	0.0006	18	1.51	1.25	0.04	0.07	10.00	637.74	637.78	Gutter = 642.6
1+99.5	0+05.0	194.50				0.31				8.74	2.67	0.0006	18	1.51	0.60	0.01	2.14	10.00	637.72	637.73	
14' INLET	0+94.6	179.73	B-3	0.86	0.9	0.77	0.77	10.00	100	8.74	6.76	0.0041	18	3.83	1.25	0.28	0.78	10.00	639.84	640.12	Gutter = 640.2
6' INLET	0+05.0	89.60	B-2	0.44	0.9	0.40	1.17	10.00	100	8.74	10.23	0.0095	18	5.79	1.25	0.65	0.26	10.00	638.44	639.09	Gutter = 639.6
0+05.0	0+00.00	5.00				1.48				8.74	12.90	0.0151	18	7.30	0.60	0.52	0.01	10.00	637.08	637.59	Beginning Hg = 637 (assumed)
Storm Drain Line "C"																					
14' INLET	0+00.00	29.50	C-1	0.91	0.9	0.82	0.82	10.00	100	8.74	7.16	0.0046	18	4.05	1.25	0.32	0.12	10.00	638.89	639.21	Beginning Hg=638.75, Gutter=640.20
Storm Drain Line "E"																					
14' INLET	0+00.00	18.80	E-1	1.82	0.9	1.64	1.64	10.00	100	8.74	14.32	0.0186	18	8.10	1.25	1.27	0.04	10.00	639.10	640.37	Beginning Hg=638.75, Gutter=641.65
Storm Drain Line "F"																					
6' INLET	0+00.00	18.80	F-1	0.23	0.9	0.21	0.21	10.00	100	8.74	1.81	0.0003	18	1.02	1.25	0.02	0.31	10.00	638.76	638.78	Beginning Hg=638.75, Gutter=640.92
Storm Drain Line "G"																					
6' INLET	0+7.3	13.10	G-1	0.13	0.9	0.12	0.12	10.00	100	8.74	1.02	0.0001	18	0.58	1.25	0.01	0.38	10.00	640.97	640.98	Beginning Hg=640.97, Gutter=642.25
Storm Drain Line "H"																					
6' INLET	0+00.00	15.20	H-1	0.30	0.9	0.27	0.27	10.00	100	8.74	2.36	0.0005	18	1.34	1.25	0.03	0.19	10.00	640.98	641.01	Beginning Hg=640.97, Gutter=643.45
Storm Drain Line "D-1"																					
0+59.7	0+00.00	53.80	A.D1.G.H								2.50	0.0428	8	7.16	1.25	1.00	0.13	10.00	639.97	640.97	Beginning Hg=637.67, Basin FL=638.21
Storm Drain Line "D-2"																					
0+58.3	0+00.00	58.30	C.D2.E.F								9.80	0.0230	15	7.99	1.25	1.24	0.12	10.00	637.51	638.75	Beginning Hg=636.15, Basin FL=635.36

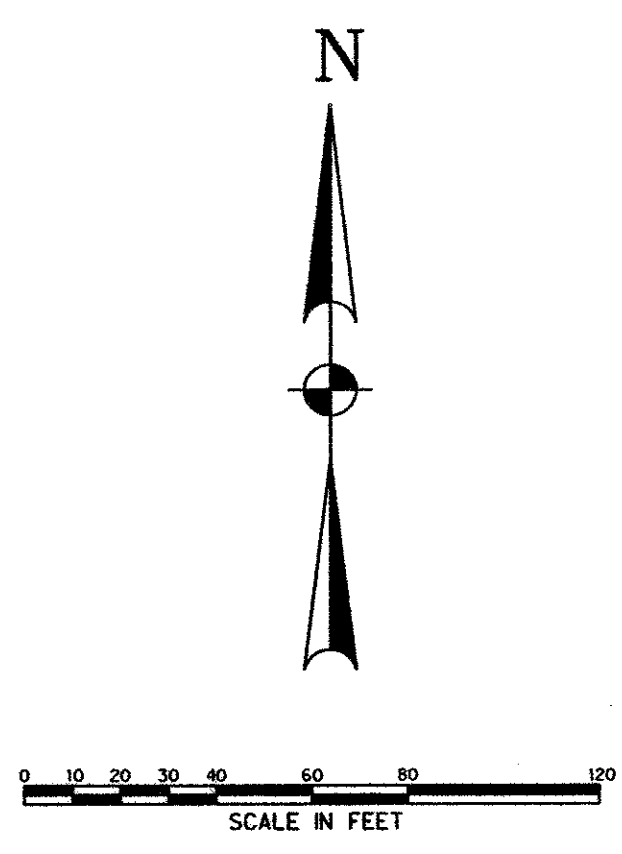

MODIFIED RATIONAL METHOD DETENTION BASIN DESIGN
PROJECT: SOUTH BASIN ALONG WESTGROVE

Runoff Coefficient C = 0.9
 Drainage Area - A = 3.48 acres
 Time of Concentration - tc = 10 minutes
 Maximum Outflow Rate - Q = 9.8 cfs

Duration (minutes)	Intensity (inches/hr)	Depth (inches)	Inflow Discharge Q=CiA	Inflow Volume Cu. Ft.	Duration (minutes)	Outflow Volume Cu. Ft.	Storage Volume Cu. Ft.	
5	10.49	0.87	32.9	9.856	15	4.410	5.446	
10	8.74	1.46	27.4	16.424	20	5.880	10.544	
15	7.52	1.88	23.6	21.197	25	7.350	13.847	
20	6.80	2.27	21.3	25.557	30	8.820	16.737	
30	5.75	2.88	18.0	32.416	40	11.760	20.656	
40	5.00	3.33	15.7	37.584	50	14.700	22.884	
50	4.40	3.67	13.8	41.342	60	17.640	23.702	
60	3.91	3.91	12.2	44.086	70	20.580	23.506	
70	3.63	4.24	11.4	47.750	80	23.520	24.230	
80	3.33	4.44	10.4	50.062	90	26.460	23.602	
90	3.18	4.77	10.0	53.783	100	29.400	24.383	
120	2.62	5.24	8.2	59.082	130	38.220	20.862	
180	1.91	5.73	6.0	64.607	190	55.860	8.747	
Required Storage Volume			24.383	cubic feet				
			0.56	acre-feet				

Note: 100yr. c=.9 in. 25 yr. c=.5 out


MODIFIED RATIONAL METHOD DETENTION BASIN DESIGN
PROJECT: NORTH BASIN ALONG WESTGROVE

Runoff Coefficient C = 0.9
 Drainage Area - A = 2.07 acres
 Time of Concentration - tc = 10 minutes
 Maximum Outflow Rate - Q = 2.5 cfs


Duration (minutes)	Intensity (inches/hr)	Depth (inches)	Inflow Discharge Q=CiA	Inflow Volume Cu. Ft.	Duration (minutes)	Outflow Volume Cu. Ft.	Storage Volume Cu. Ft.	
5	10.49	0.87	19.5	5.863	15	1.125	4.738	
10	8.74	1.46	16.3	9.770	20	1.500	8.270	
15	7.52	1.88	14.0	12.609	25	1.875	10.734	
20	6.80	2.27	12.7	15.202	30	2.250	12.952	
30	5.75	2.88	10.7	19.282	40	3.000	16.282	
40	5.00	3.33	9.3	22.356	50	3.750	18.606	
50	4.40	3.67	8.2	24.592	60	4.500	20.092	
60	3.91	3.91	7.3	26.224	70	5.250	20.974	
70	3.63	4.24	6.8	28.403	80	6.000	22.403	
80	3.33	4.44	6.2	29.778	90	6.750	23.028	
90	3.18	4.77	5.9	31.991	100	7.500	24.491	
120	2.62	5.24	4.9	35.144	130	9.750	25.394	
180	1.91	5.73	3.6	38.430	190	14.250	24.180	
360	1.15	6.90	2.1	46.277	370	27.750	18.527	
720	0.73	8.80	1.4	59.020	730	54.750	4.270	
Required Storage Volume			25.394	cubic feet				
			0.58	acre-feet				

Note: 100yr. c=.9 in. 25 yr. c=.5 out


Inlet No.	Location	Storm Frequency	Time of Concentration (min)	Intensity Runoff "I" (in/hr)	Coeff "C"	Area (acres)	Q (cfs)	Upstream Inlet Carryover (cfs)	Total Gutter Flow (cfs)	Gutter Slope (ft/ft)	Flow Depth (ft)	Length (ft)	Selected Inlet	
													Type	Downstream Inlet Carryover
Inlet A1	A1	100	10	8.74	0.9	0.24	1.9	0.0	1.9	SAG	< 0.2		2-GRATE	0.0
Inlet A2	A2	100	10	8.74	0.9	0.33	2.6	0.0	2.6	SAG	< 0.2		2-GRATE	0.0
Inlet A3	A3	100	10	8.74	0.9	0.34	2.7	0.0	2.7	SAG	< 0.2		2-GRATE	0.0
Inlet A4	A4	100	10	8.74	0.9	0.22	1.7	0.0	1.7	SAG	< 0.2		2-GRATE	0.0
Inlet B1	B1	100	10	8.74	0.9	0.34	2.7	0.0	2.7	SAG	0.28	6.00	CURB	0.0
Inlet B2	B2	100	10	8.74	0.9	0.44	3.5	0.0	3.5	SAG	0.33	6.00	CURB	0.0
Inlet B3	B3	100	10	8.74	0.9	0.86	6.8	0.0	6.8	SAG	0.30	14.00	CURB	0.0
Inlet C1	C1	100	10	8.74	0.9	0.91	7.2	0.0	7.2	SAG	0.31	14.00	CURB	0.0
Inlet E1	E1	100	10	8.74	0.9	1.79	14.1	0.0	14.3	SAG	0.49	14.00	CURB	0.0
Inlet F1	F1	100	10	8.74	0.9	0.25	2.0	0.0	1.8	SAG	0.22	6.00	CURB	0.0
Inlet G1	G1	100	10	8.74	0.9	0.13	1.0	0.0	1.0	SAG	0.15	6.00	CURB	0.0

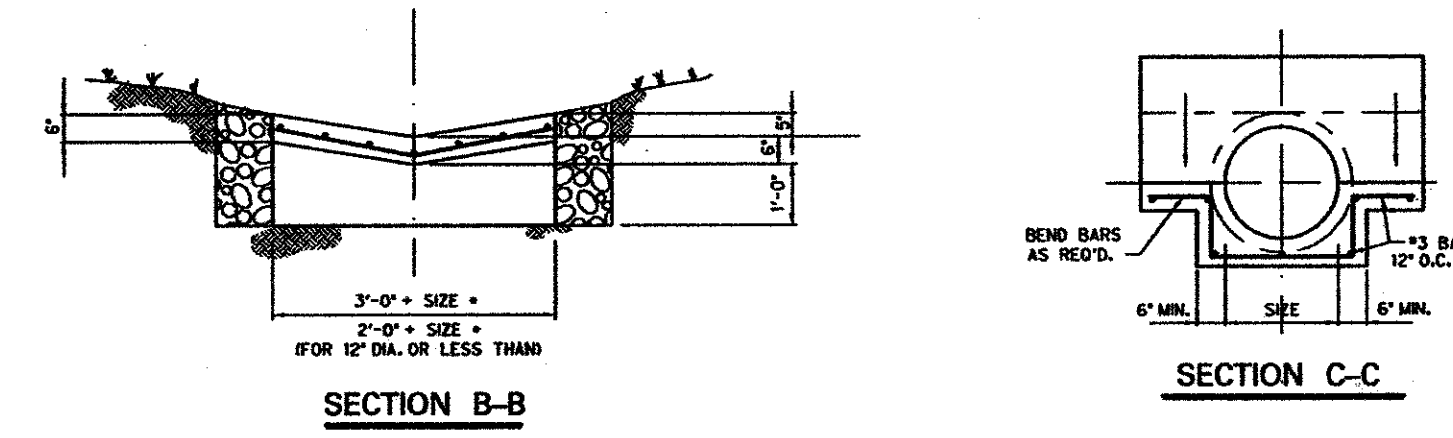


SECTION B-B and SECTION C-C

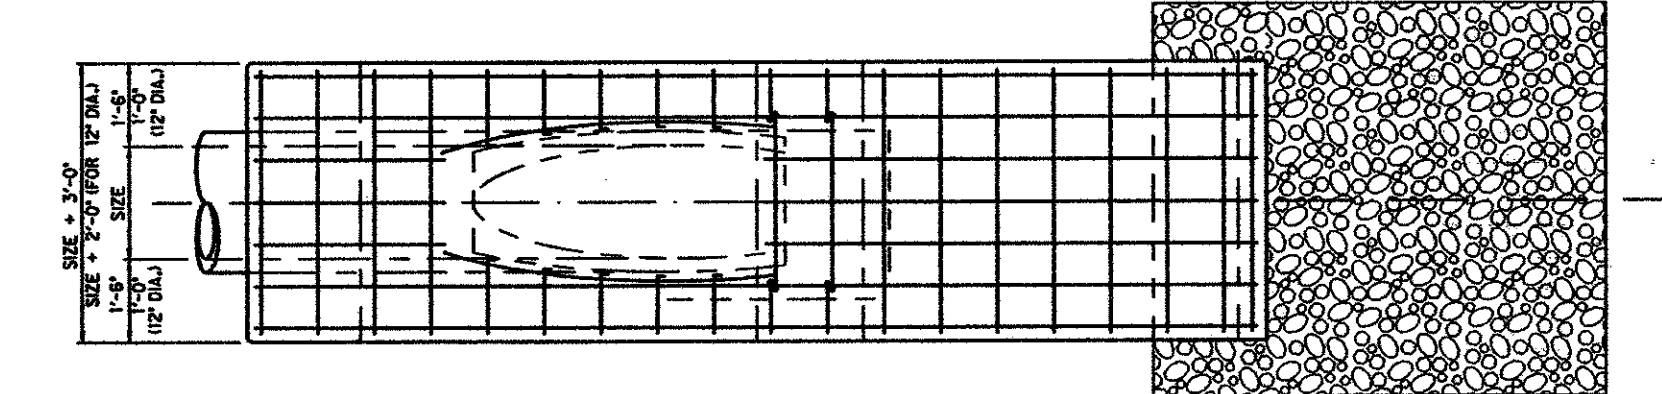


1.13-06 SLOPED END SECTION HEADWALL

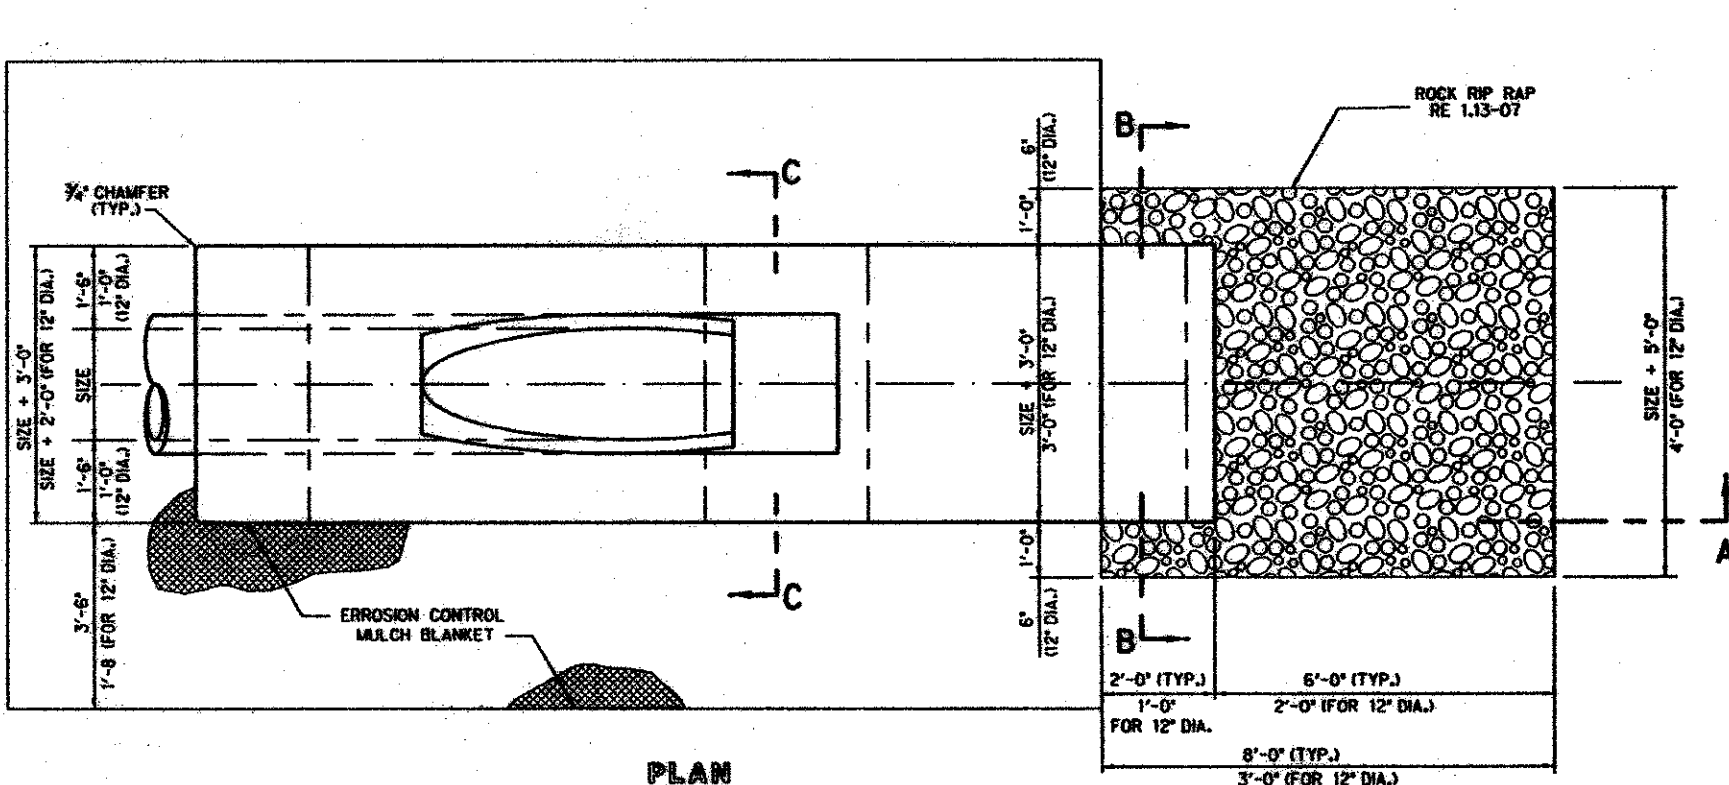

1.13-06 SLOPED END SECTION HEADWALL

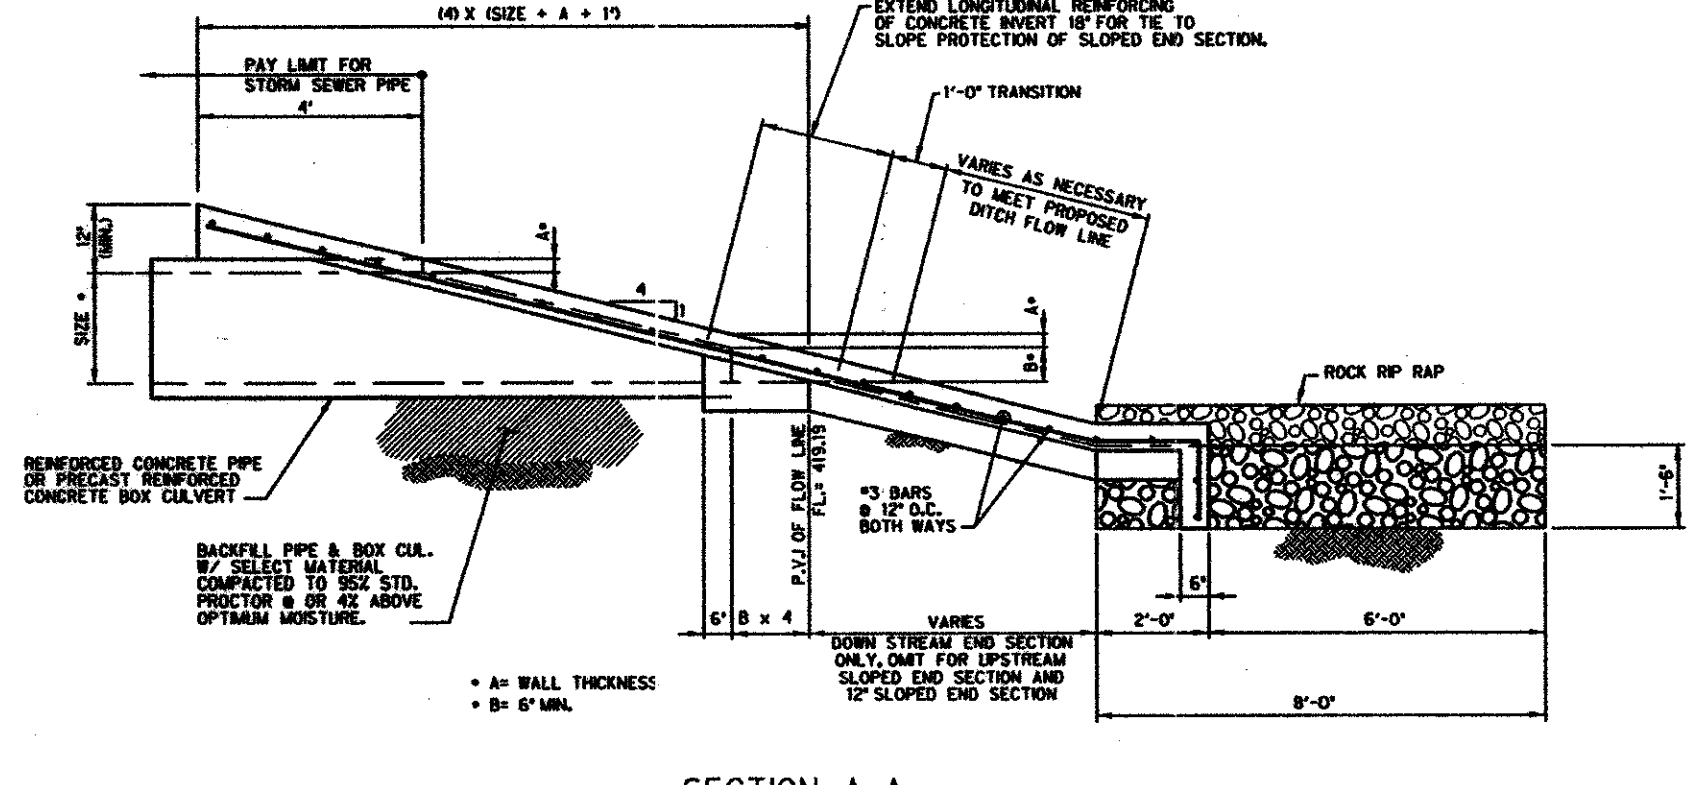

SECTION A-A

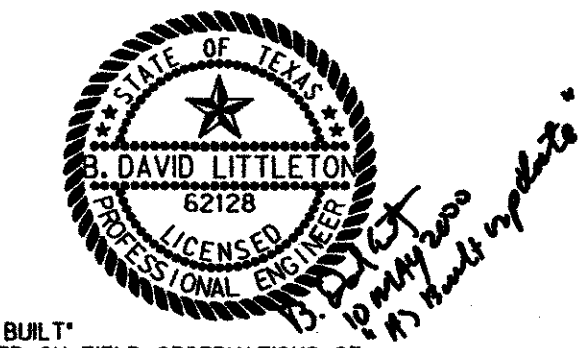

"AS BUILT" BASED ON FIELD OBSERVATIONS OF SURFACE FEATURES ON MAY 4, 2000 AND CONTRACTOR PROVIDED INFORMATION. ELEVATIONS NOT FIELD VERIFIED. PARKING STRIPING NOT COMPLETED IN FIELD.
 REVISED AS SHOWN 11/23/99

BENCHMARK: 3/4" CUT IN CONCRETE AS THE NORTHWEST CORNER OF THE SUBJECT TRACT. ELEV = 645.20

DRAINAGE CALCULATIONS AND DETAILS
 ADDISON COM CENTER
 JACKSON - SHAW COMPANY
 TOWN OF ADDISON, TEXAS

Half Associates
 ENGINEERS · ARCHITECTS · SCIENTISTS · PLANNERS · SURVEYORS

DESIGN	DRAWN	DATE	SCALE	NOTES	FILE	NO.
HALFF	CADD	SEPTEMBER 1999	1" = 40'	AVO 17986 986CALCS		C-4A