

PHASE I - CONSTRUCTION:
CONSTRUCT CONSTRUCTION
EXIT AS SHOWN. DELETE
SILT FENCE PLACEMENT AT
CONSTRUCTION EXIT AS
REQUIRED. (TYPICAL)

PHASE I - CONSTRUCTION:
CONSTRUCT 1,660 +/- LF REINFORCED
SILT FENCE AS SHOWN.

PHASE II - CONSTRUCTION:
CONSTRUCT SILT FENCE INLET
TREATMENT AROUND ALL
STORM DRAIN INLET BOTTOMS
ON SITE

PHASE III - CONSTRUCTION:
REPLACE SILT FENCE INLET
TREATMENT WITH BLOCK AND
GRAVEL INLET TREATMENT
OR GRAVEL AND SCREEN
INLET TREATMENT AROUND
ALL COMPLETED STORM
DRAIN INLETS ON SITE

PHASE II & III
CONSTRUCT INLET PROTECTION
(SEE NOTES ON SHEET C-7)
TYPICAL.

PHASE III - CONSTRUCTION:
REVEGETATE ALL DISTURBED
AREAS



PHASE II & III
CONSTRUCT CINDERBLOCK
PIPE INLET PROTECTION
(SEE DETAIL ON SHEET C-7)

LEGEND:

- SILT FENCE
- INLET PROTECTION
- CINDERBLOCK PIPE INLET PROTECTION

NOTE: SEE SHEET C7 FOR NOTES AND DETAILS


- PHASE I - SITE GRADING OPERATION
- PHASE II - SITE UTILITY AND STORM DRAIN CONSTRUCTION
- PHASE III - PAVING AND SIDEWALK CONSTRUCTION

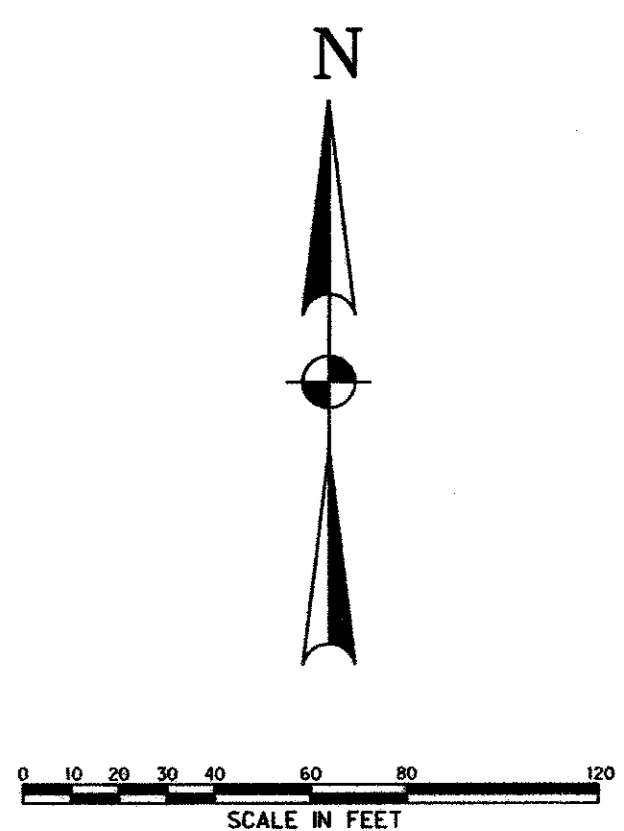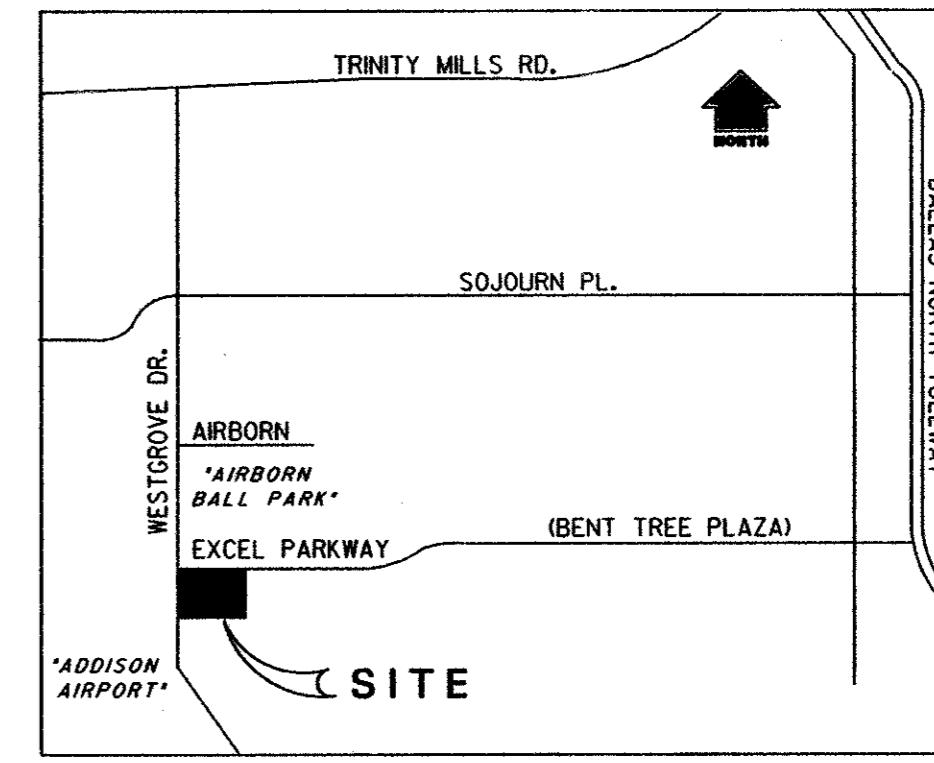

△ "AS BUILT"
BASED ON FIELD OBSERVATIONS OF
SURFACE FEATURES ON MAY 4, 2000
AND CONTRACTOR PROVIDED INFORMATION.
ELEVATIONS NOT FIELD VERIFIED. PARKING
STRIPING NOT COMPLETED IN FIELD.

△ 11-16-99
ADDITION OF PIPE INLET PROTECTION
IN DETENTION BASINS.

BENCHMARK:
"X" CUT IN CONCRETE AS THE NORTHWEST
CORNER OF THE SUBJECT TRACT.
ELEV = 645.20

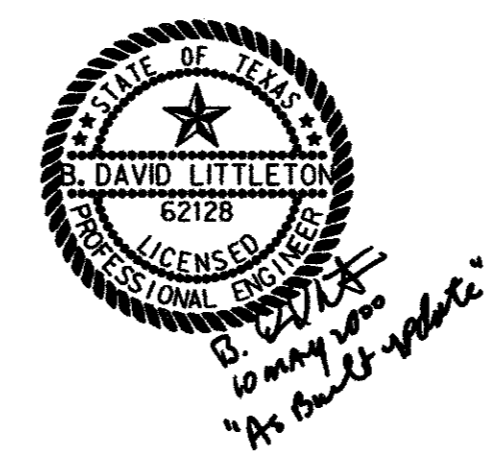

EROSION CONTROL PLAN						
ADDISON COM CENTER						
JACKSON - SHAW COMPANY						
TOWN OF ADDISON, TEXAS						
Half Associates						
ENGINEERS . ARCHITECTS . SCIENTISTS . PLANNERS . SURVEYORS						
DESIGN	DRAWN	DATE	SCALE	NOTES	FILE	NO.
HALFF	CADD	SEPTEMBER 1999	1" = 40'	AVO 17986 986ERT		C-6