

EXCEL PARKWAY



NORTH


01 PAVING AND GRADING PLAN

1" = 30'-0"

LEGEND


- PARKING STRIPE
4" STRIPES ON 2'-0" CENTERS
- NEW LANDSCAPE
- EXISTING LANDSCAPE TO REMAIN
- NEW CONCRETE PAVING
- FIRE LANE
- BOUNDARY
- EXISTING CURB REMAIN
- NEW CURB
- NEW FENCE
- 100.00 PROPOSED SPOT SHOT
- POLE LIGHT
- EXISTING FIRE HYDRANT

PROJECT:
UNITED STATES ENVIRONMENTAL PROTECTION AGENCY
 16650 WESTGROVE DRIVE SUITES 200 & 300 ADDISON, TEXAS 75001
 CITY PROJECT NUMBER PWH# 2008-20

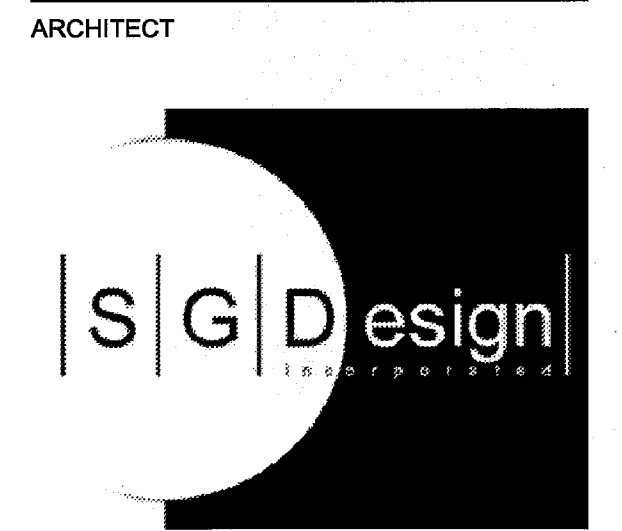

3311 Elm Street, Suite 105
 Dallas, Texas 75226
 214-742-6044
 214-742-6041 Fax

ARCHITECT'S SEAL:

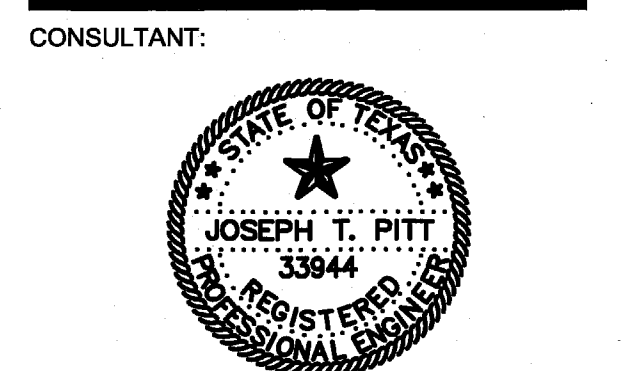

TMBP
 CONSULTING ENGINEERS INC.
 2301 N. AKARD ST. SUITE 400
 DALLAS, TEXAS 75201
 (214) 671-3302 (214) 671-8718 FAX
 THE SEAL APPEARING ON THIS DOCUMENT WAS AUTHORIZED BY JOSEPH T. PITT, P.E. 33944 ON APRIL 8, 2009

ISSUE HISTORY:

REVISION	DATE
CITY REVIEW	01/07/09
CITY COMMENT	04/09/09
CONTRACTOR'S PRICING	04/28/09
CITY COMMENT	05/14/09
CITY COMMENT	05/18/09
CITY COMMENT	05/20/09

DRAWING INFO:

FILE:

CURRENT ISSUE:

DRAWN BY:

CHECKED BY: JTP

SHEET NUMBER:

PAVING PLAN
C1.03

WESTGROVE DRIVE