


ARCHITECT



3311 Elm Street, Suite 105
 Dallas, Texas 75226
 214-742-6044
 214-742-6041 Fax

ARCHITECT'S SEAL:

CONSULTANT:

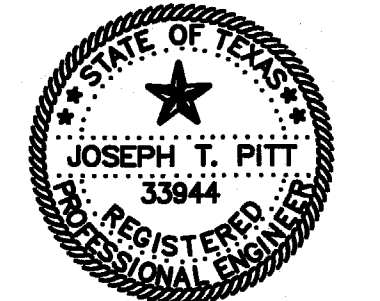

TMBP
 CONSULTING ENGINEERS INC.
 2301 N. AVARD ST. SUITE 400 DALLAS, TEXAS 75201
 (214) 871-3302 (214) 871-0718 FAX
 THE SEAL APPEARING ON THIS DOCUMENT WAS AUTHORIZED BY JOSEPH T. PITT, P.E. 33844 ON APRIL 5, 2009.

ISSUE HISTORY:


| | |
|----------------------|----------|
| CITY REVIEW | 01/07/09 |
| CITY COMMENT | 04/09/09 |
| CONTRACTOR'S PRICING | 04/28/09 |
| CITY COMMENT | 05/14/09 |
| CITY COMMENT | 05/18/09 |
| CITY COMMENT | 05/20/09 |

DRAWING INFO:


FILE:
 CURRENT ISSUE:
 DRAWN BY: RGM
 CHECKED BY: JTP

SHEET NUMBER:

PAVING AND GRADING PLAN
C1.03A

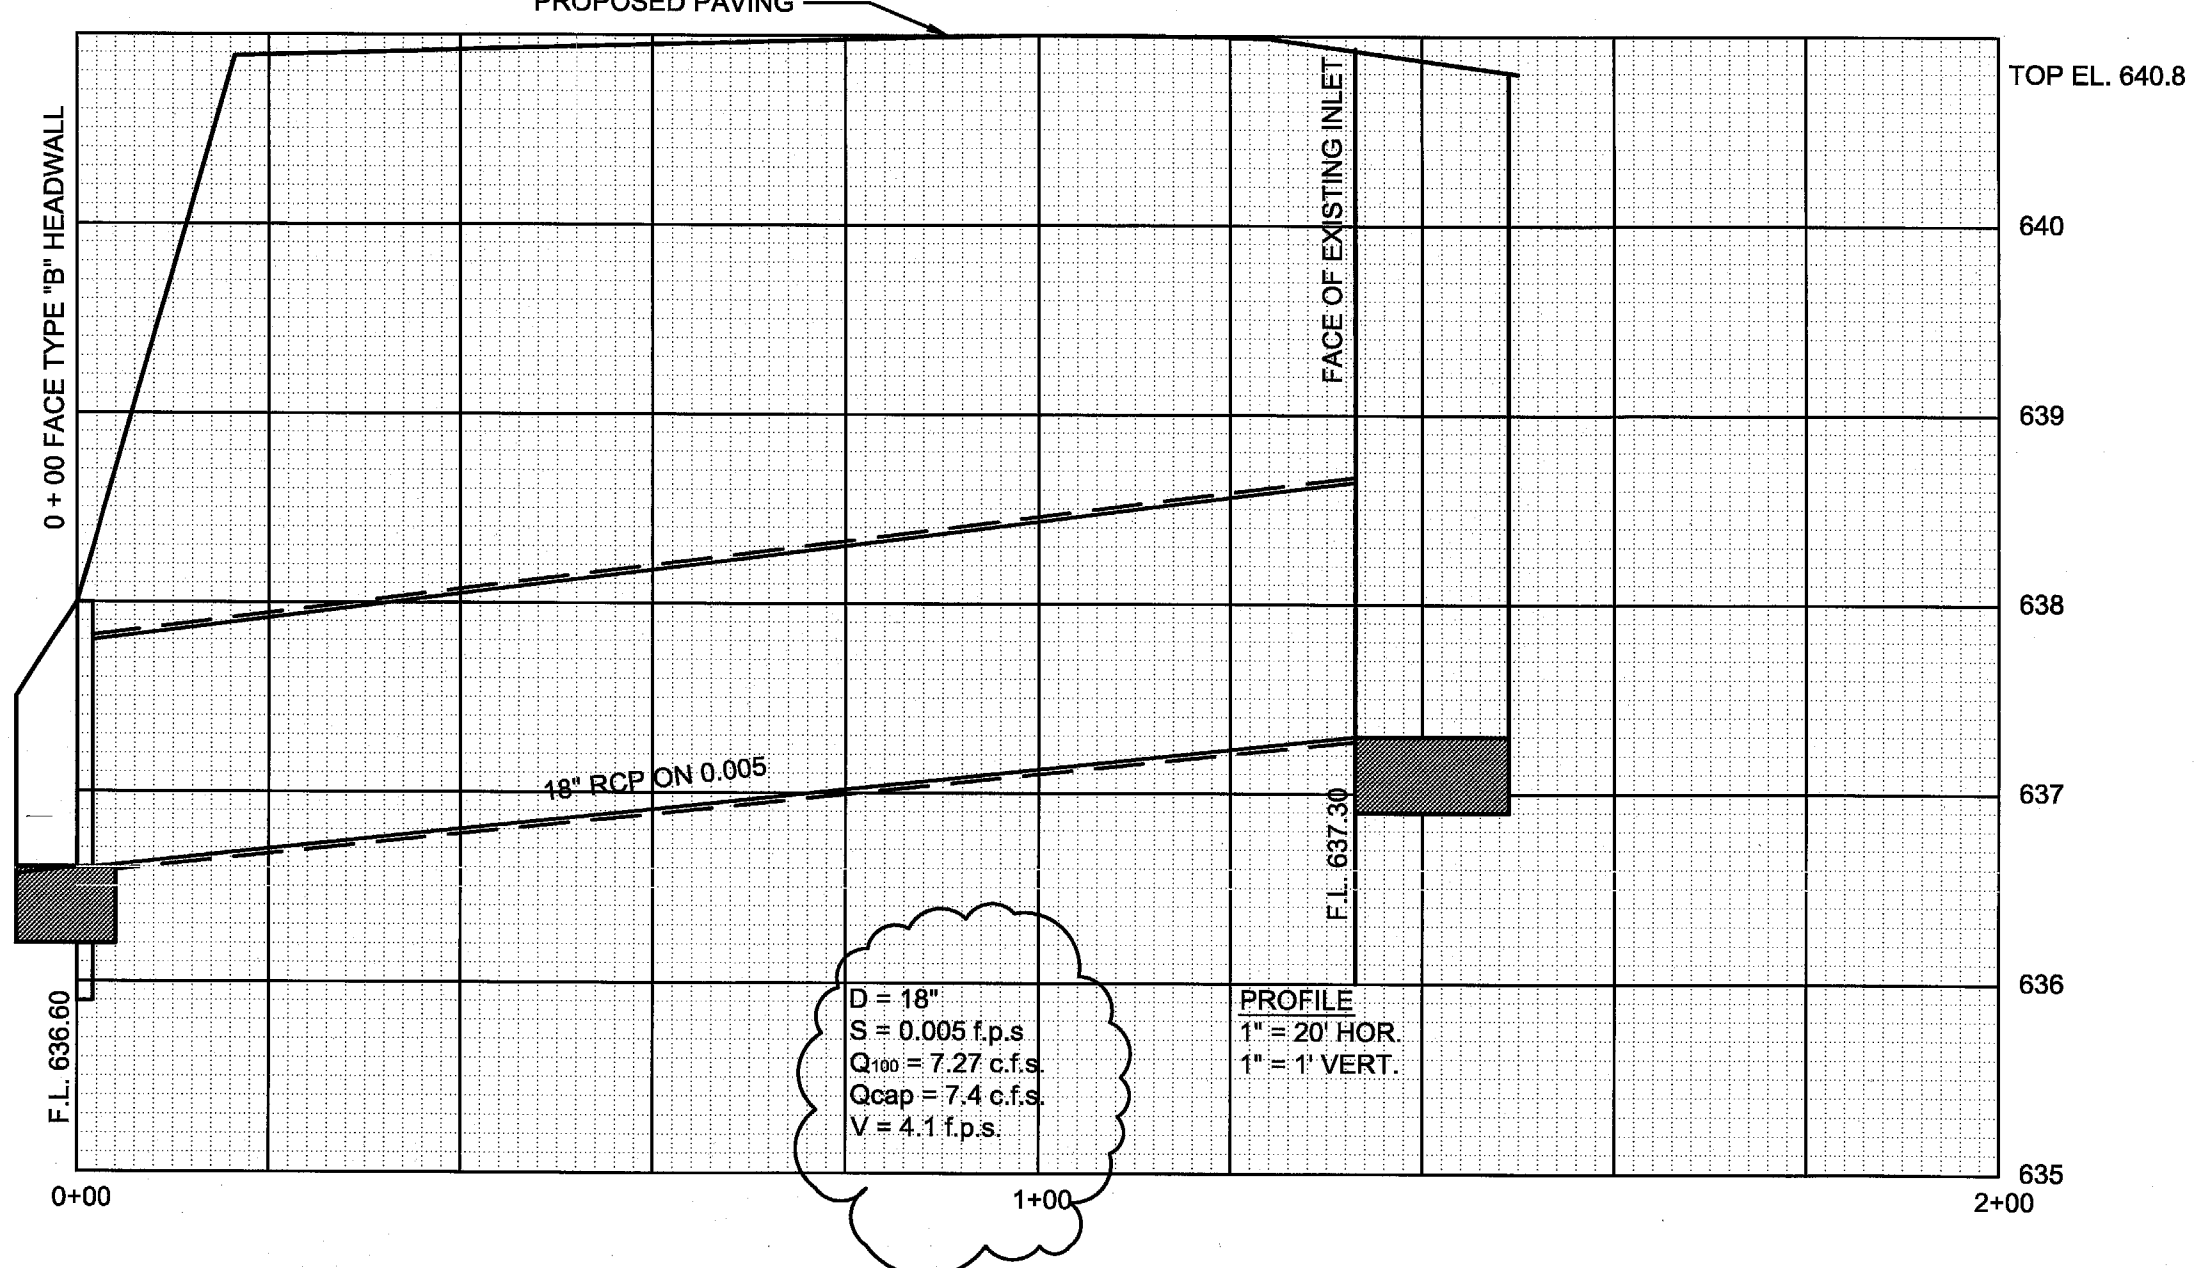

02 STORM SEWER PROFILE

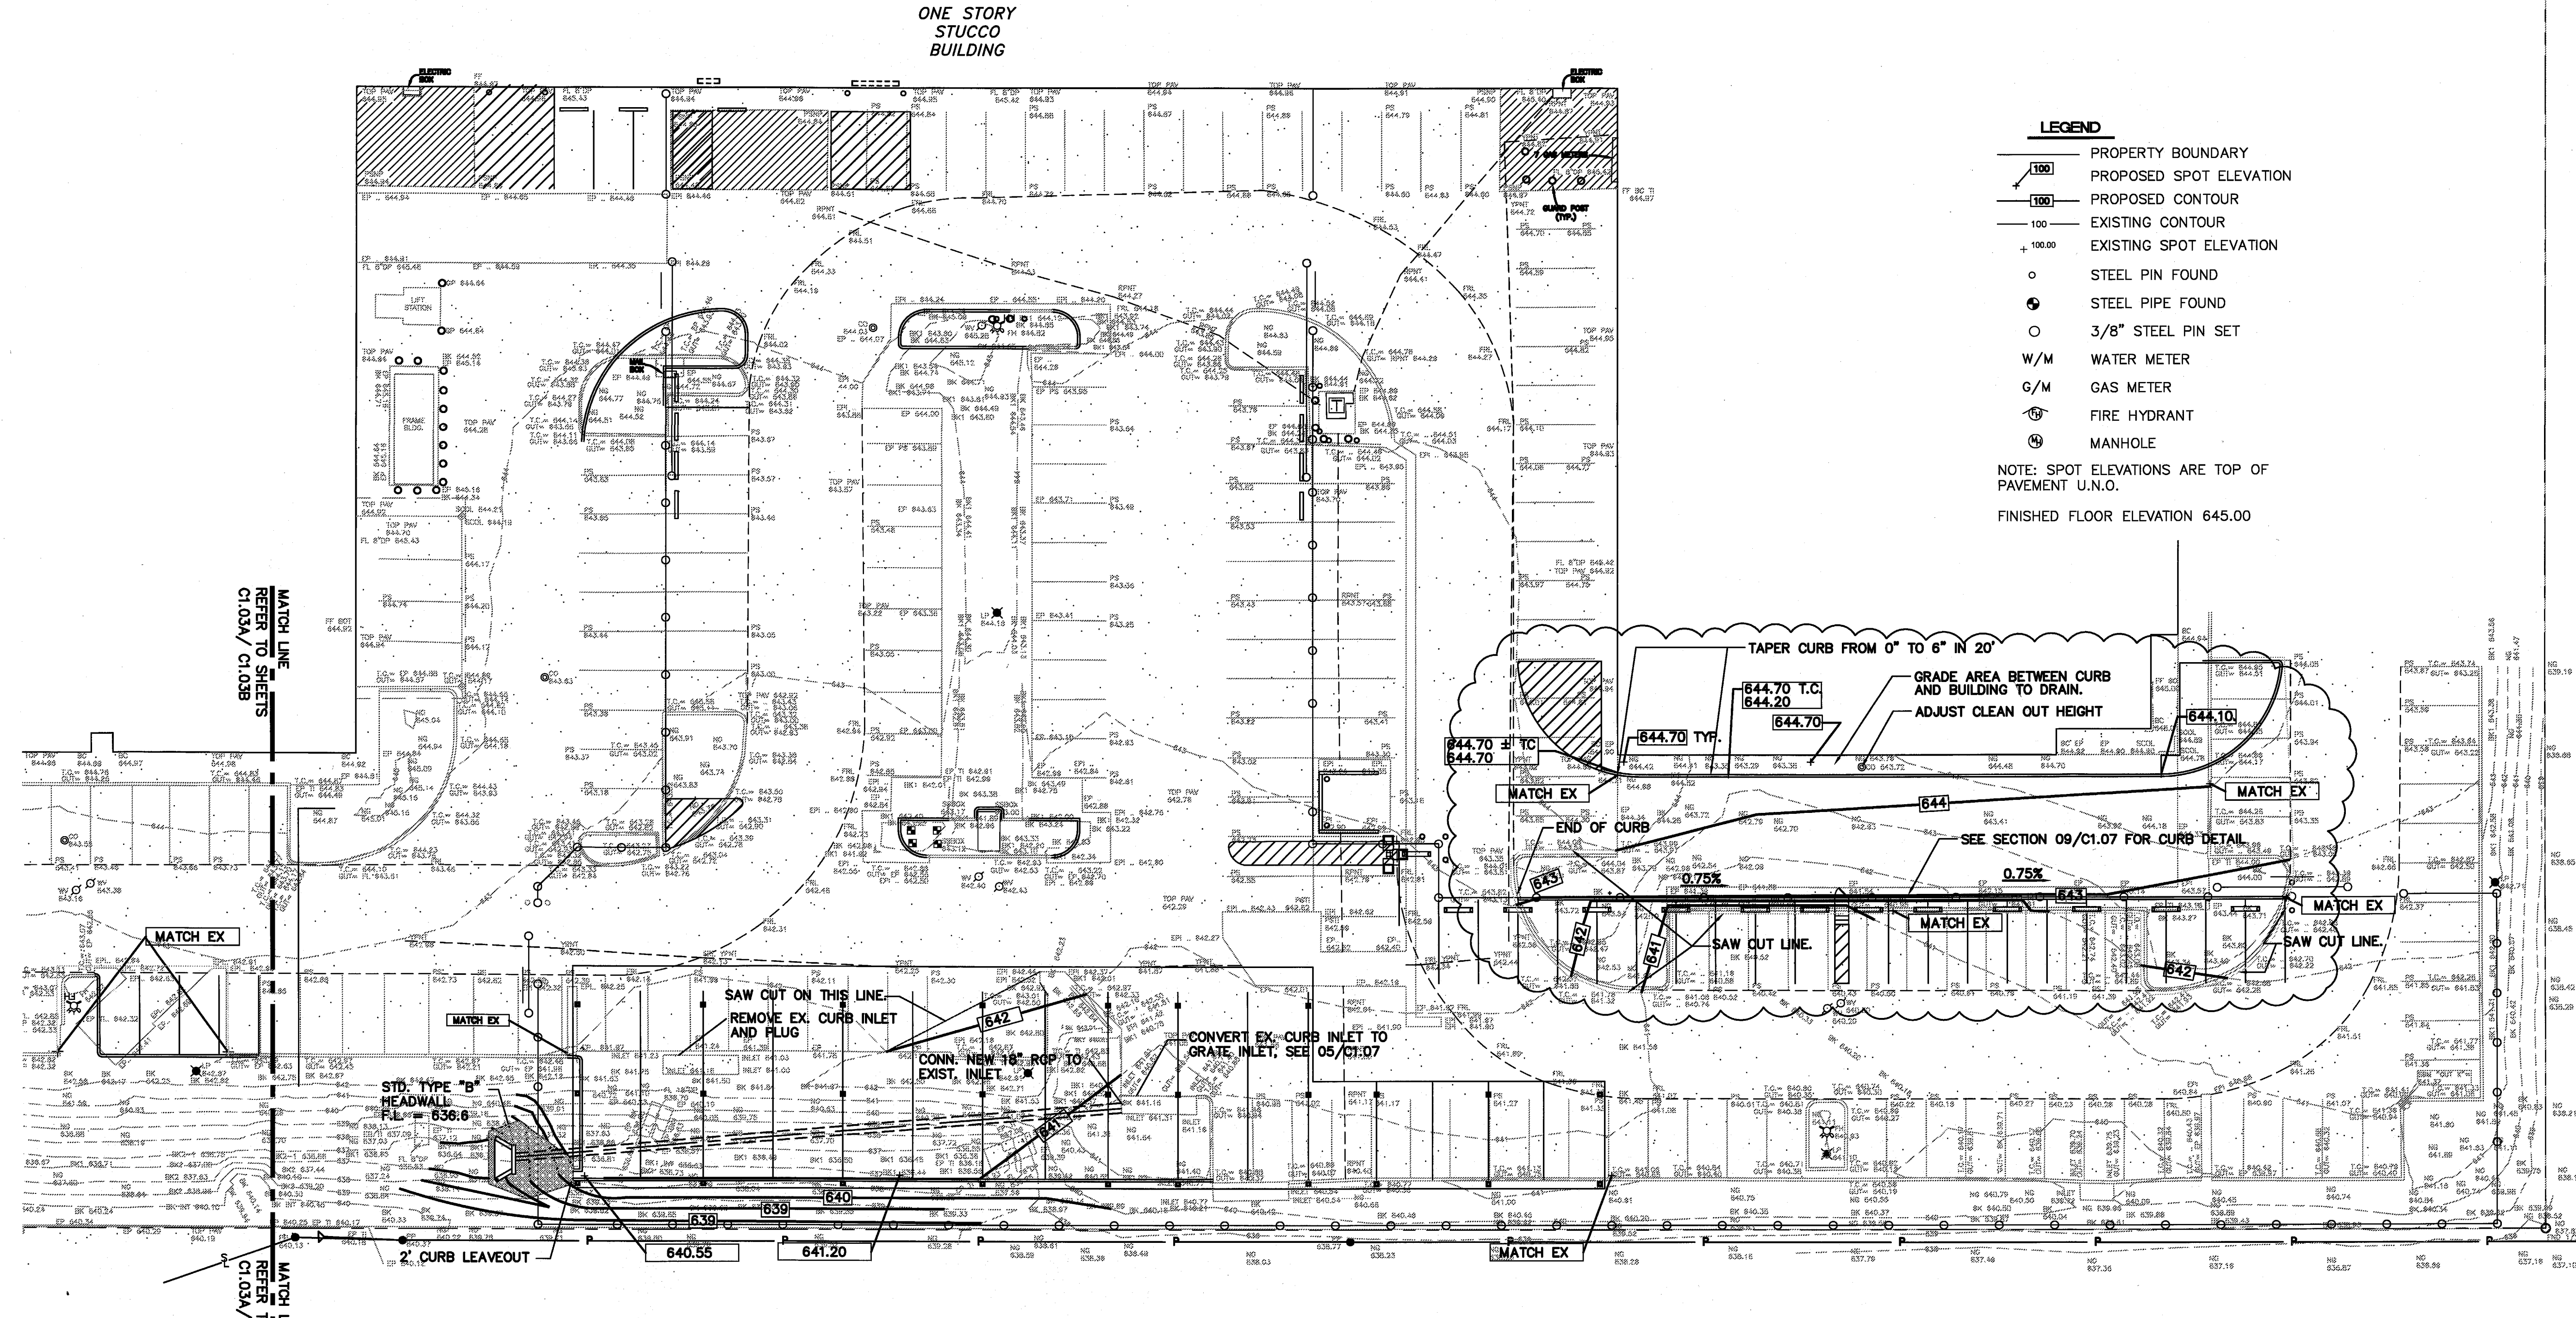

- LEGEND**
- PROPERTY BOUNDARY
 - PROPOSED SPOT ELEVATION
 - PROPOSED CONTOUR
 - EXISTING CONTOUR
 - EXISTING SPOT ELEVATION
 - STEEL PIN FOUND
 - STEEL PIPE FOUND
 - 3/8" STEEL PIN SET
 - WATER METER
 - GAS METER
 - FIRE HYDRANT
 - MANHOLE
- NOTE: SPOT ELEVATIONS ARE TOP OF PAVEMENT U.N.O.
 FINISHED FLOOR ELEVATION 645.00



01 PARTIAL GRADING PLAN
 1" = 20'