


ARCHITECT



3311 Elm Street, Suite 105  
 Dallas, Texas 75226  
 214-742-6044  
 214-742-6041 Fax

ARCHITECT'S SEAL:

CONSULTANT:

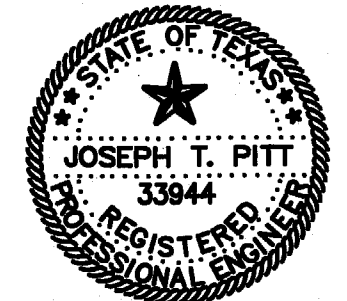

**TMBP**  
 CONSULTING ENGINEERS INC.  
 2301 N. AKARD ST. SUITE 405  
 DALLAS, TEXAS 75205  
 (214) 871-3300 (214) 871-8718 FAX  
 THE SEAL APPEARING ON THIS DOCUMENT WAS AUTHORIZED BY JOSEPH T. PITT, P.E. 33944 ON APRIL 8, 2009

ISSUE HISTORY:

CITY REVIEW	01/07/09
CITY COMMENT	04/09/09
CONTRACTOR'S PRICING	04/28/09
CITY COMMENT	05/14/09
CITY COMMENT	05/18/09
CITY COMMENT	05/20/09

DRAWING INFO:


FILE:  
 CURRENT ISSUE:  
 DRAWN BY:  
 CHECKED BY: JTP

SHEET NUMBER:


**SITE DETAILS**

**C1.06**


MARK	DESCRIPTION	FORMULA	DIM.
A	CLEAR OPENING	A	-
B	COUNTERBALANCE POST SPACING C/C	(A/2)-11"	-
C	OVERALL GATE LENGTH	A x 1.5	-
D	COUNTERBALANCE LENGTH	A x 0.5	-
E	NOMINAL GATE HEIGHT	E	-
F	POST HEIGHT (W BARB ARMS)	E + 1'-6"	-
G	FABRIC HEIGHT	E - 1'-0"	-

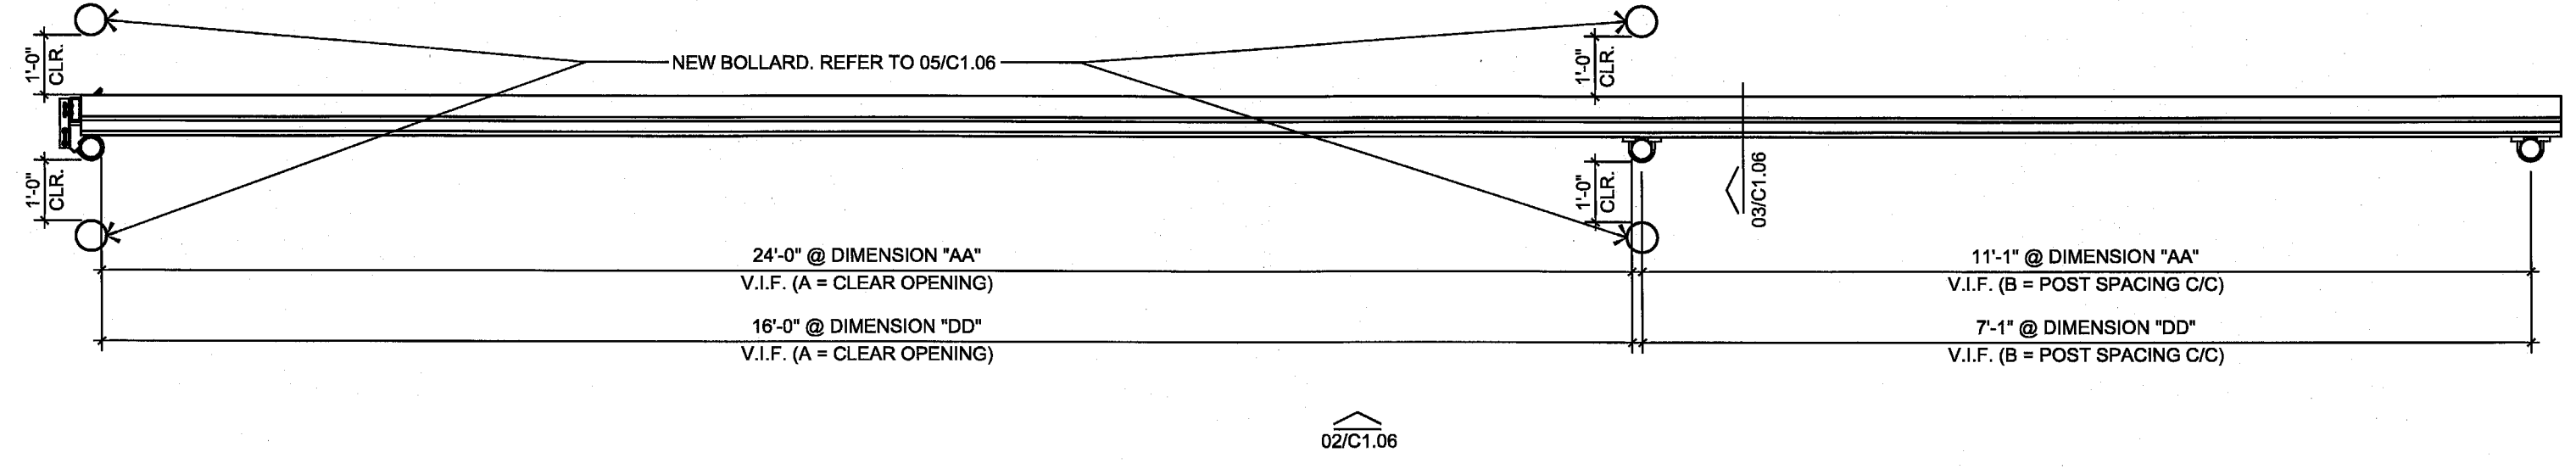


01 PLAN VIEW @ GATE 3/8"=1'-0"

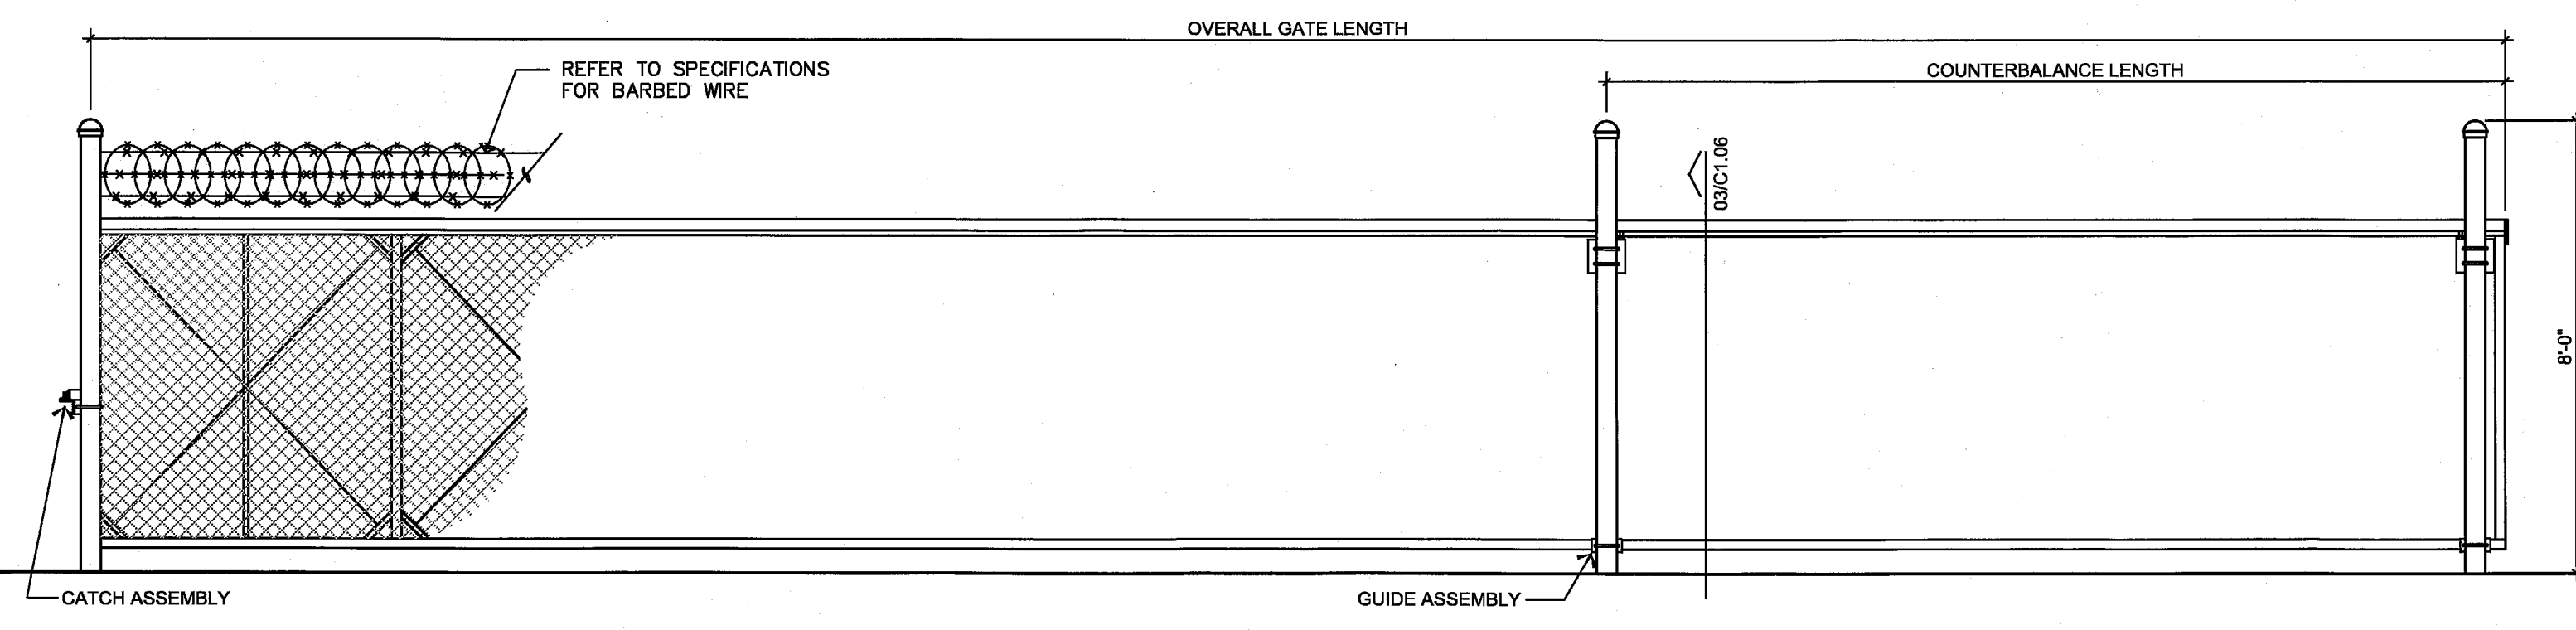


02 ELEVATION @ GATE 3/8"=1'-0"

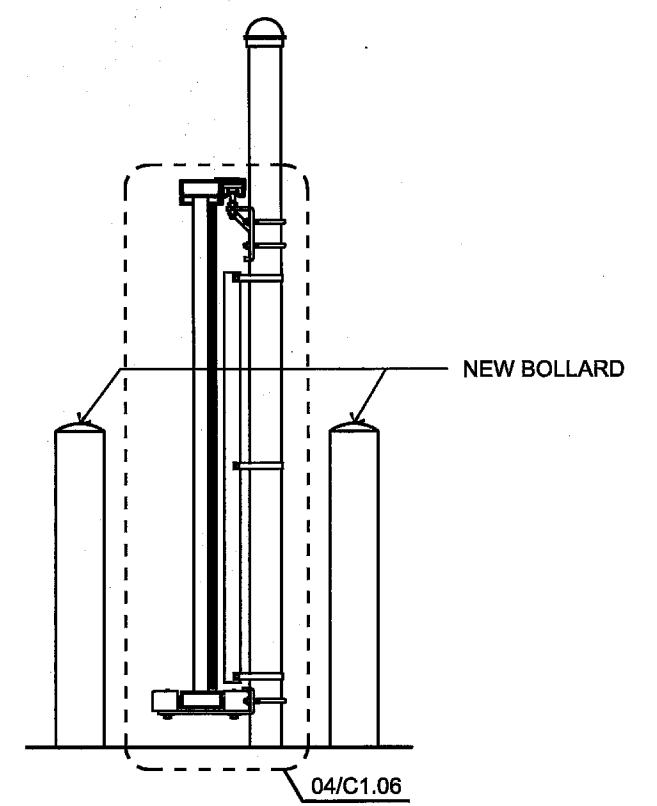


03 SECTION @ GATE 1/2"=1'-0"

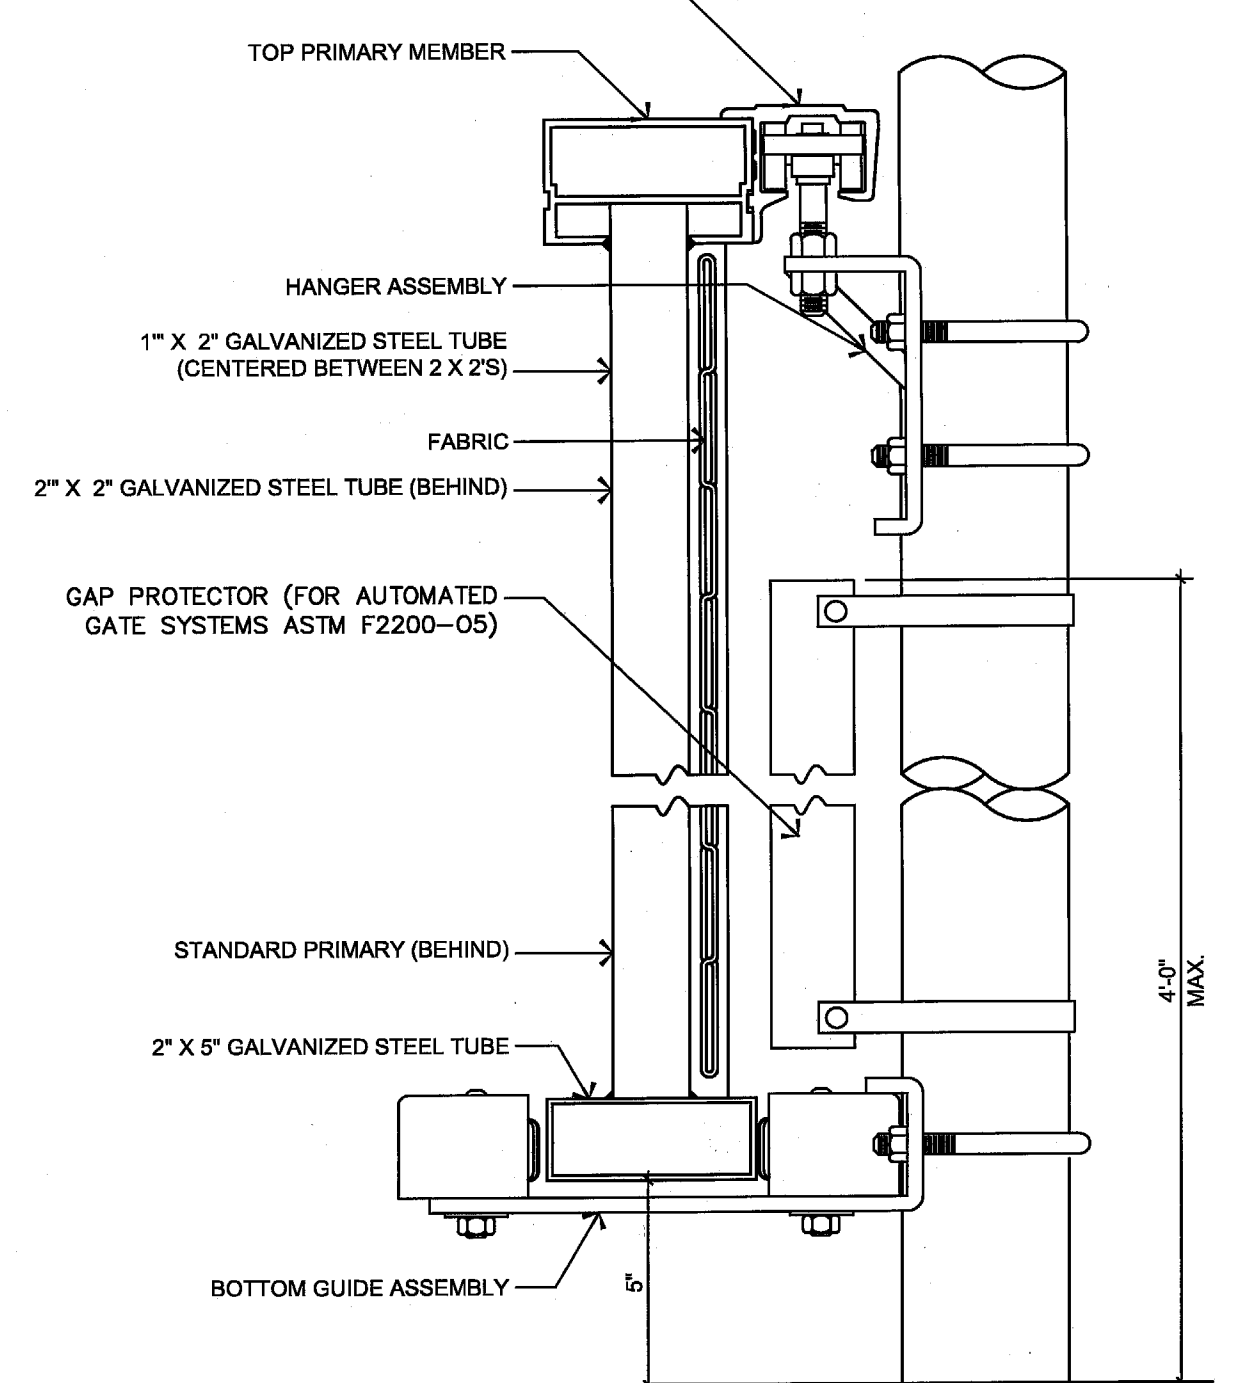


04 ENLARGED SECTION @ GATE N.T.S.

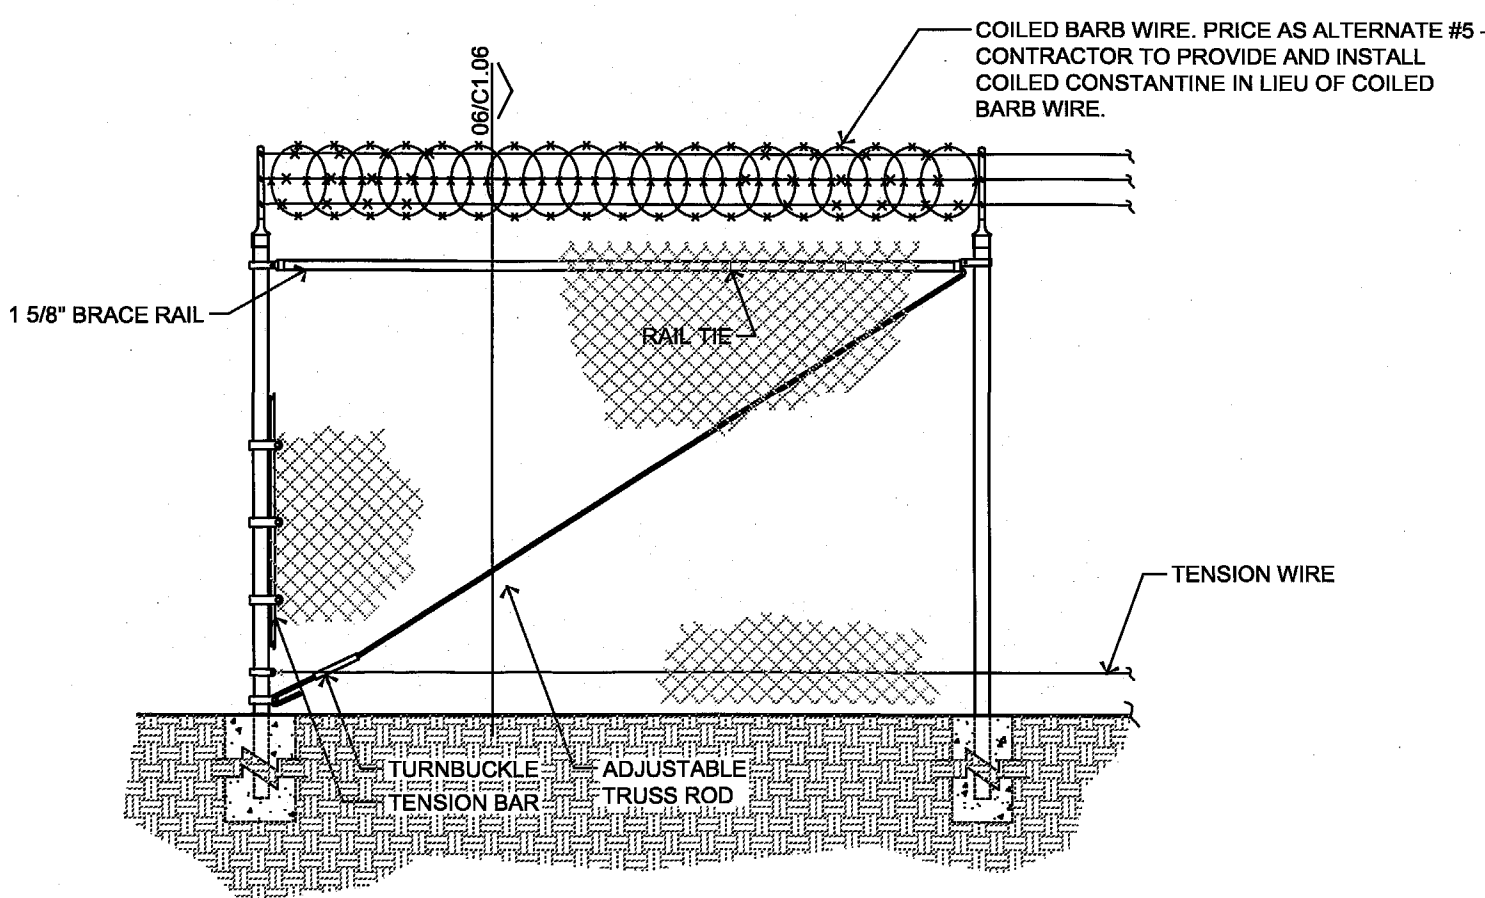


05 TYP. FENCE DETAIL 3/8"=1'-0"

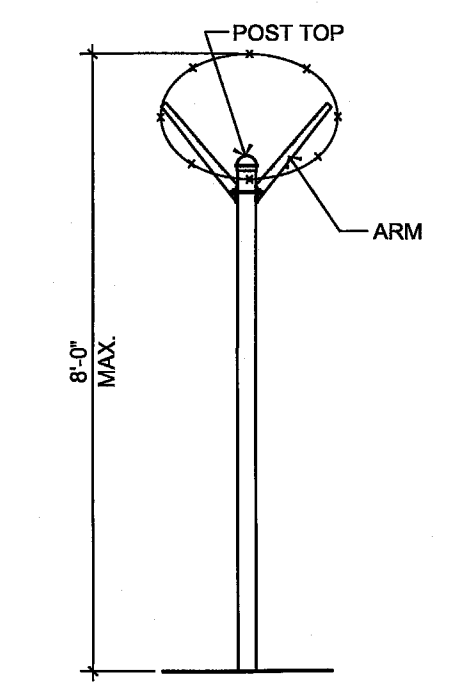


06 SECTION @ FENCE 3/8"=1'-0"

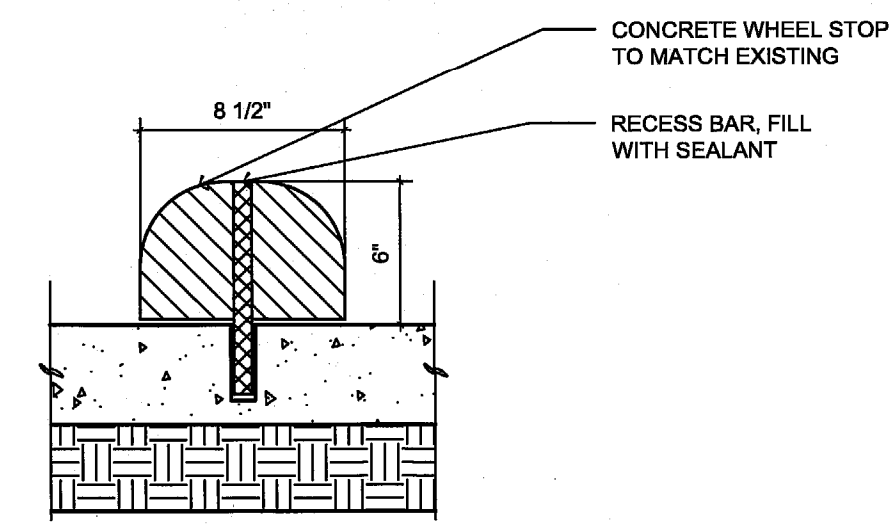


07 DETAIL @ WHEEL STOP 1-1/2"=1'-0"

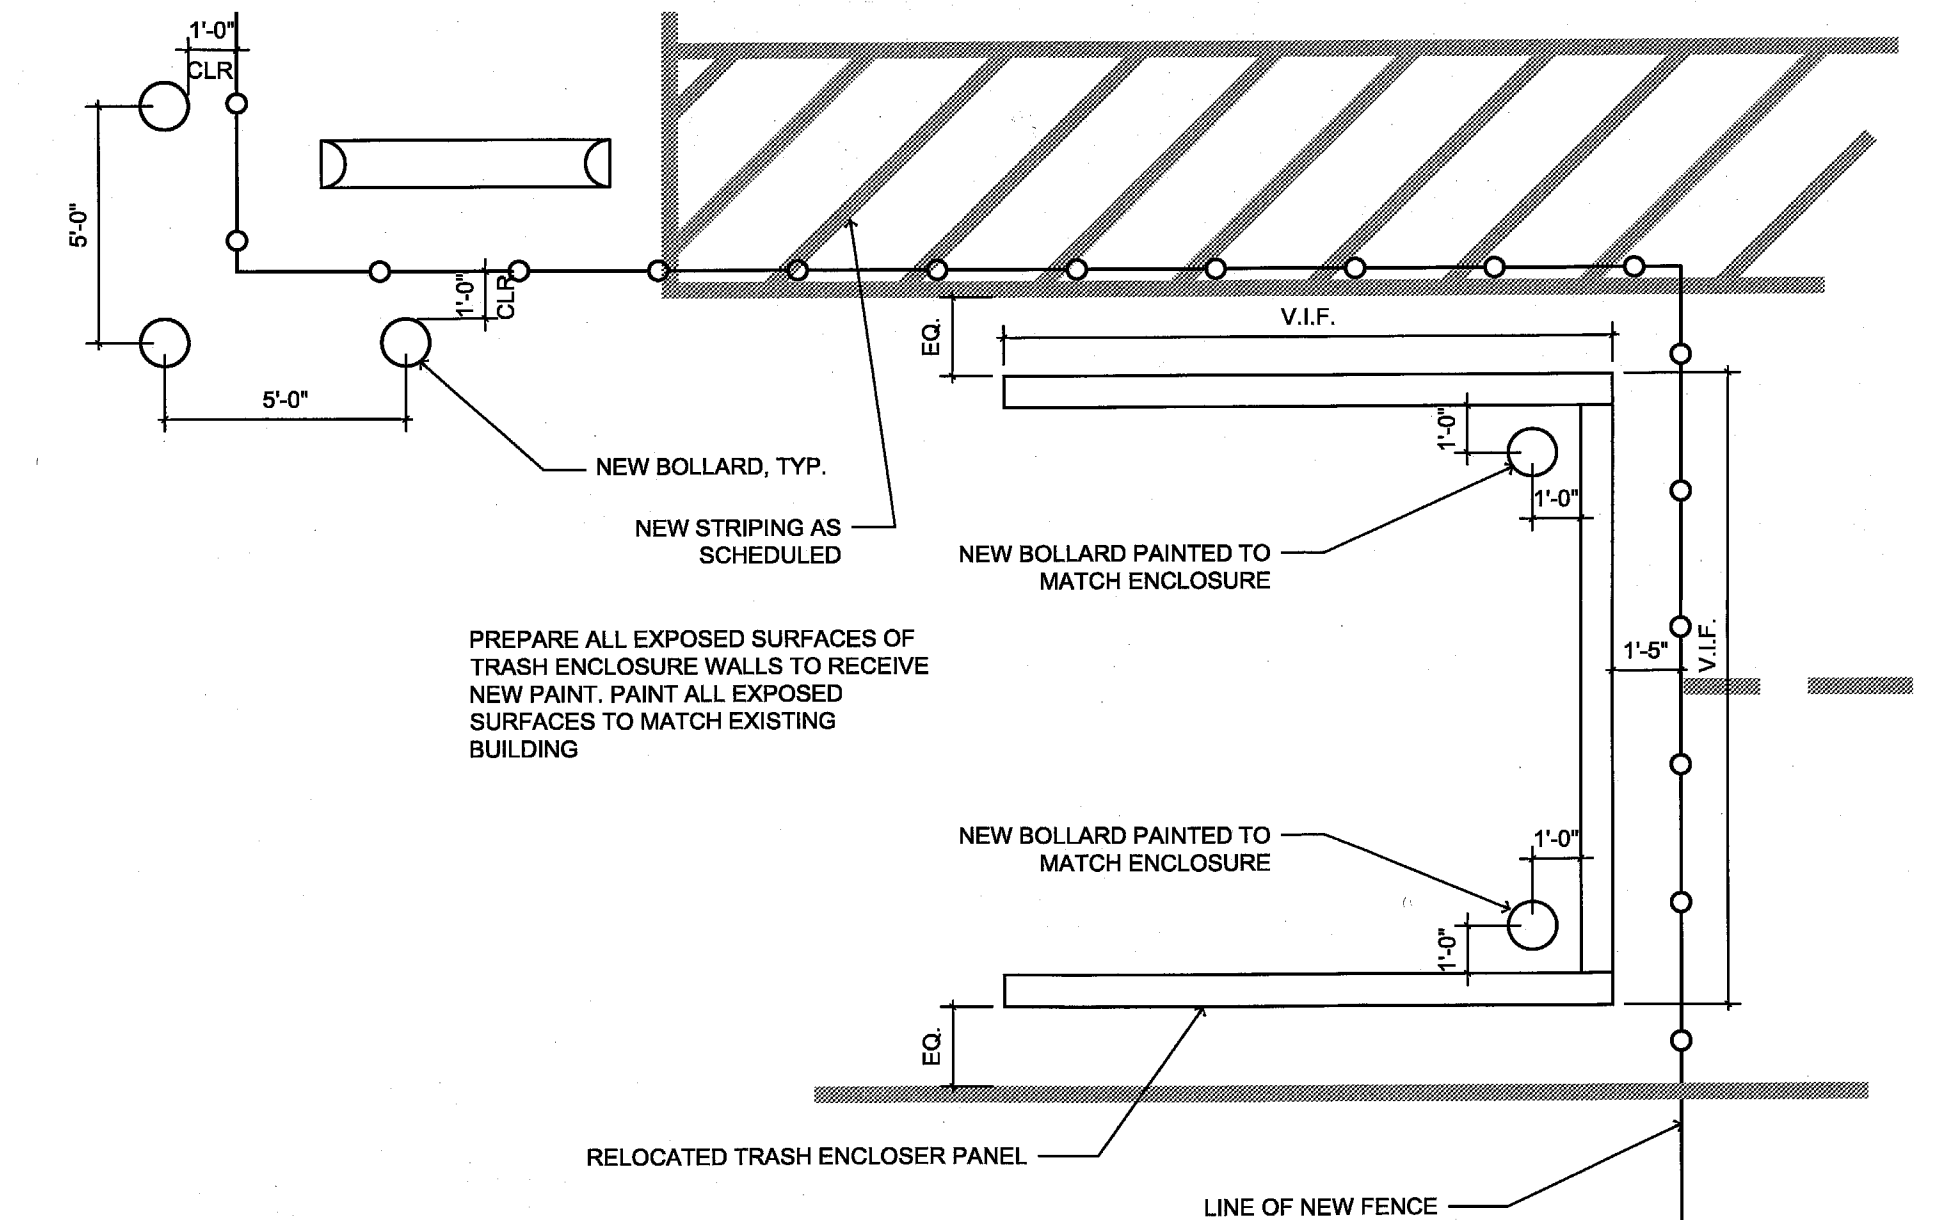


08 PLAN @ TRASH ENCLOSURE 1/4"=1'-0"

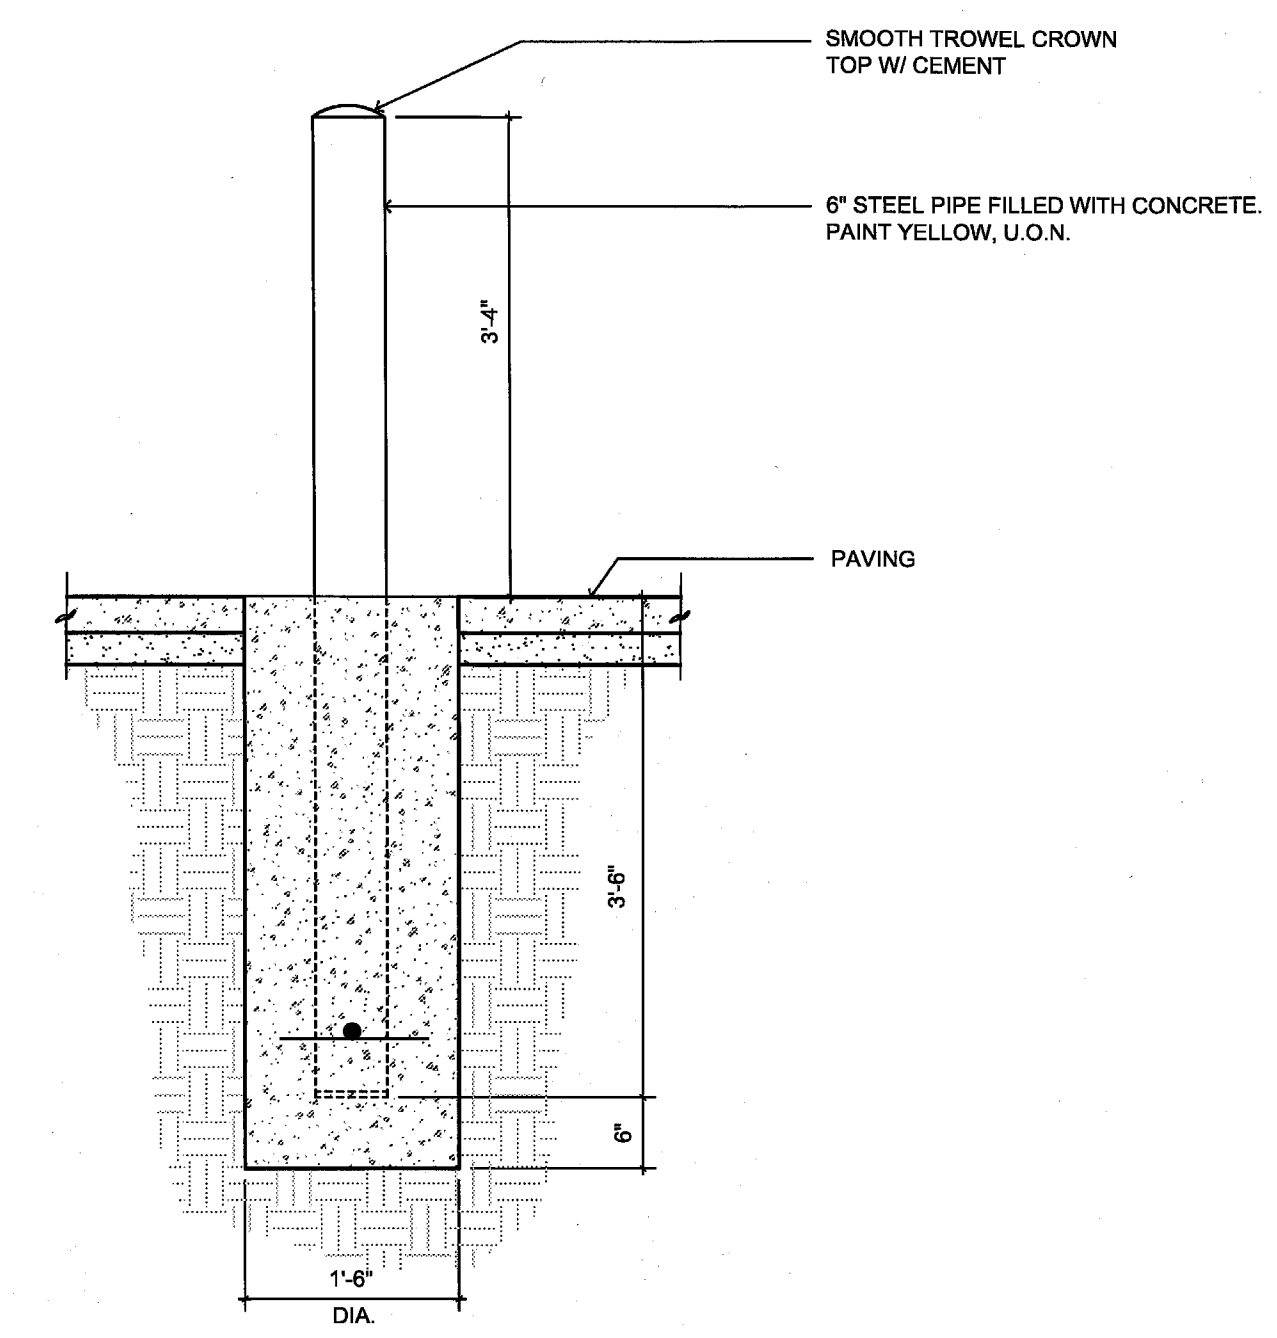


09 DETAIL @ BOLLARD 3/4"=1'-0"

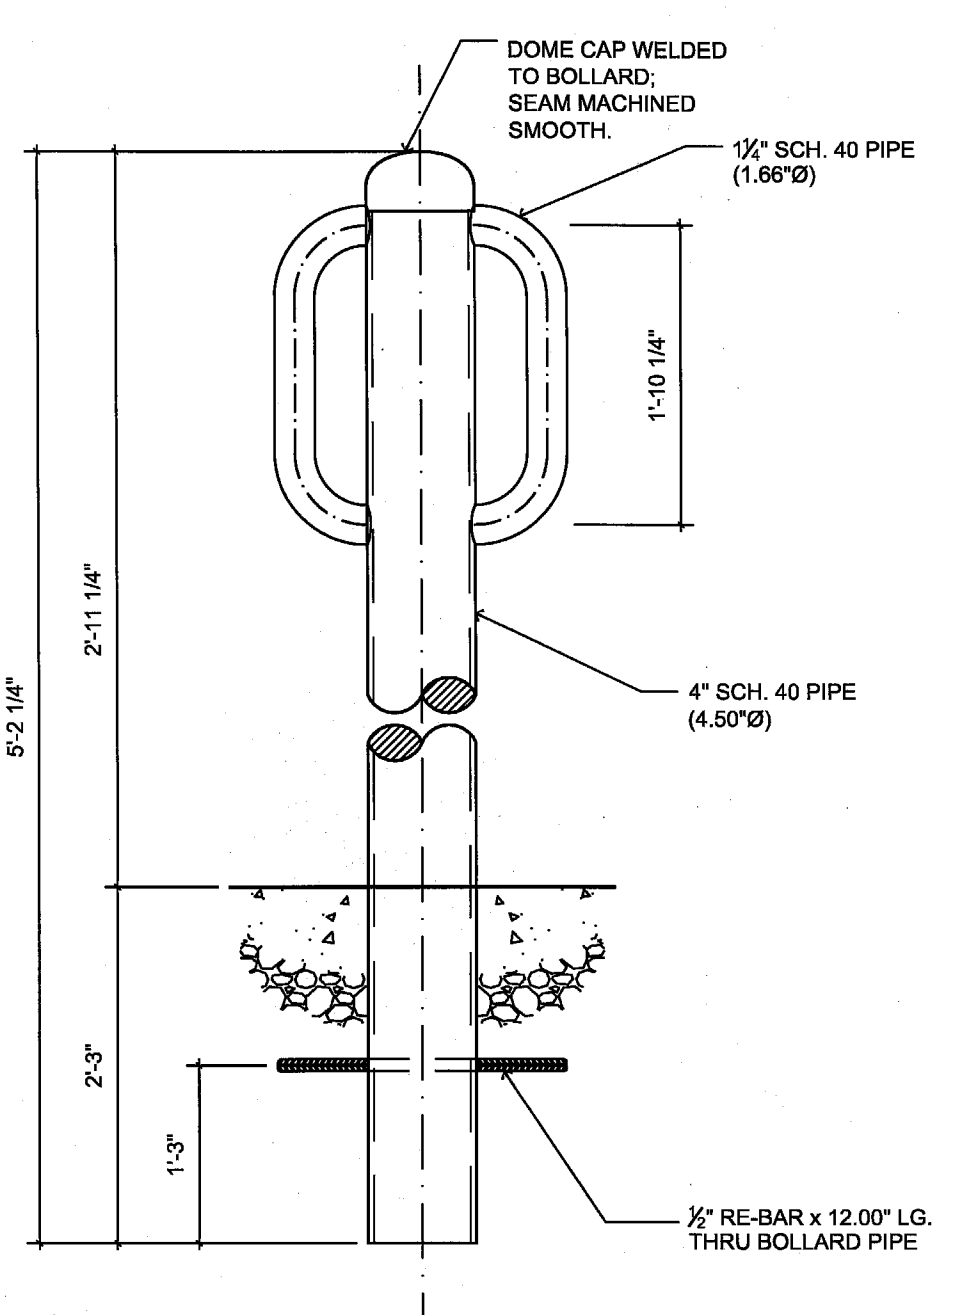

10 DETAIL @ BIKE RACK 3/4"=1'-0"

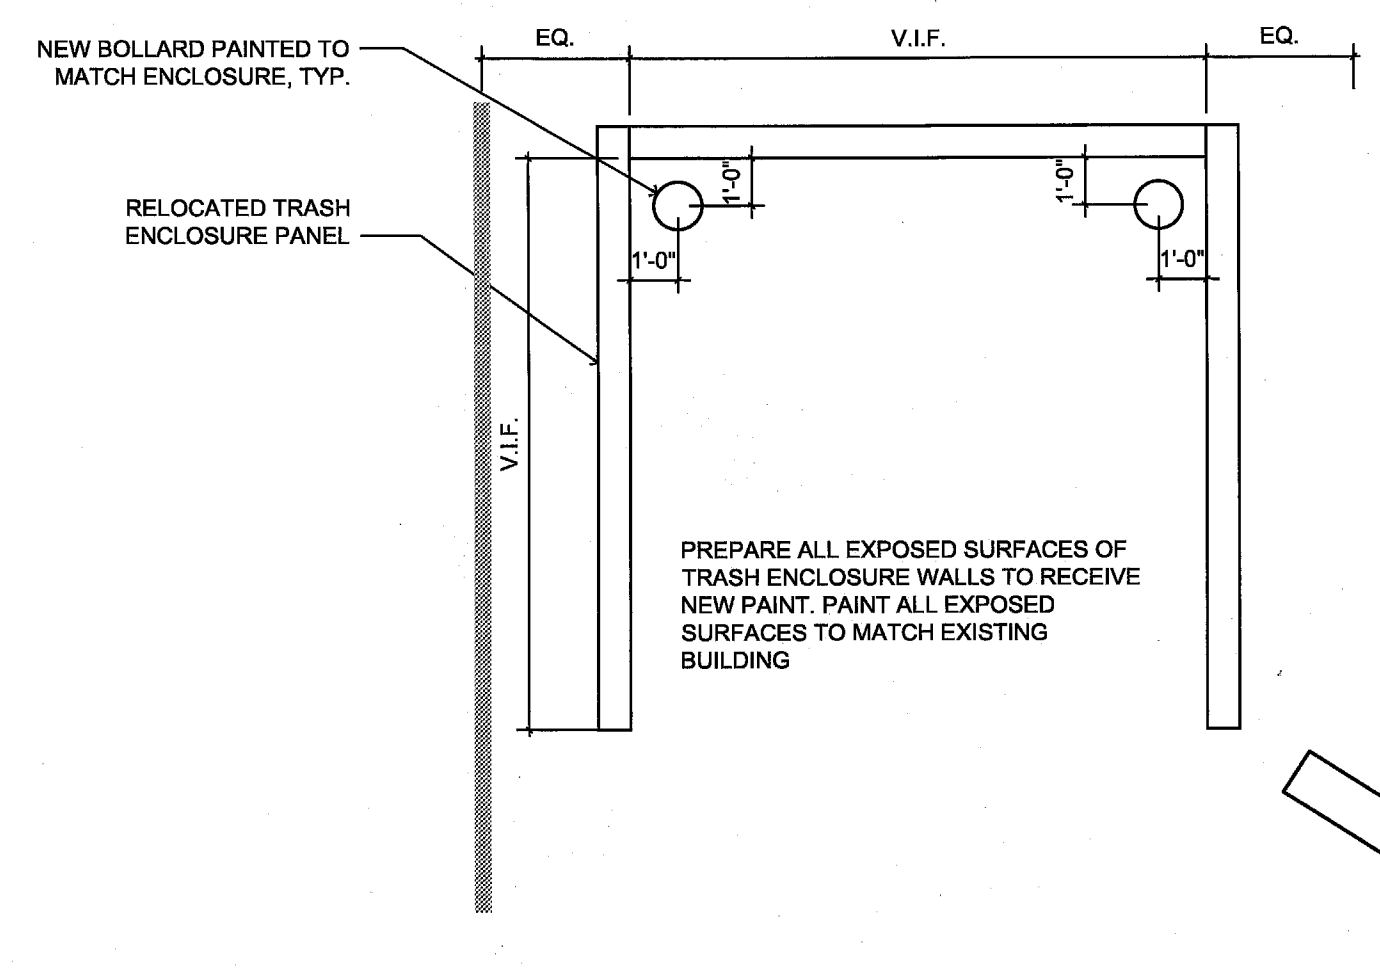

11 PLAN @ TRASH ENCLOSURE 1/4"=1'-0"

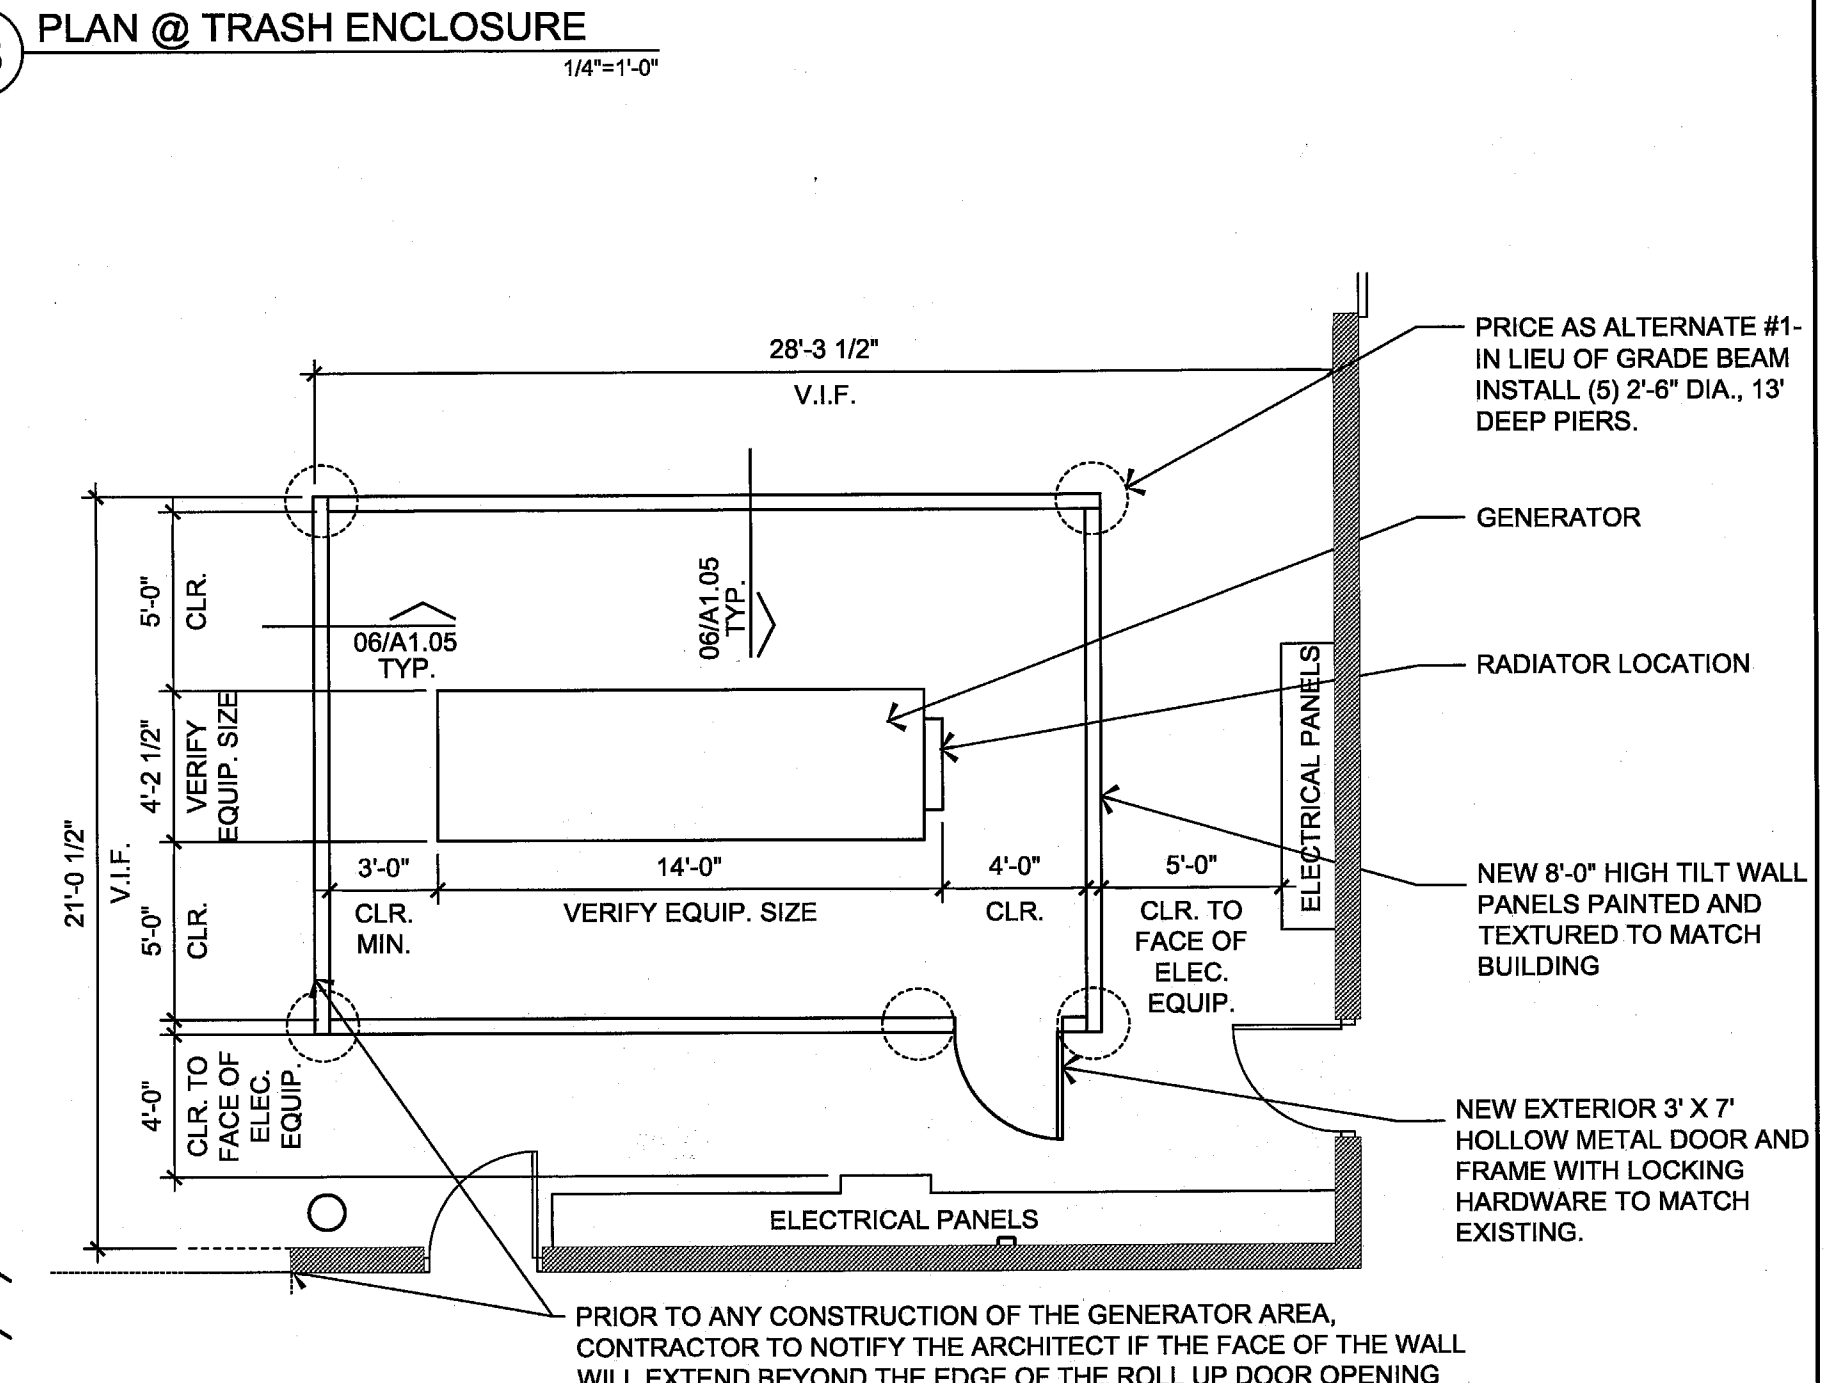

12 PLAN @ GENERATOR 3/16"=1'-0"