



PROFILE "ST-1"
SCALE: HORIZ. 1"=40'
VERT. 1"=5'

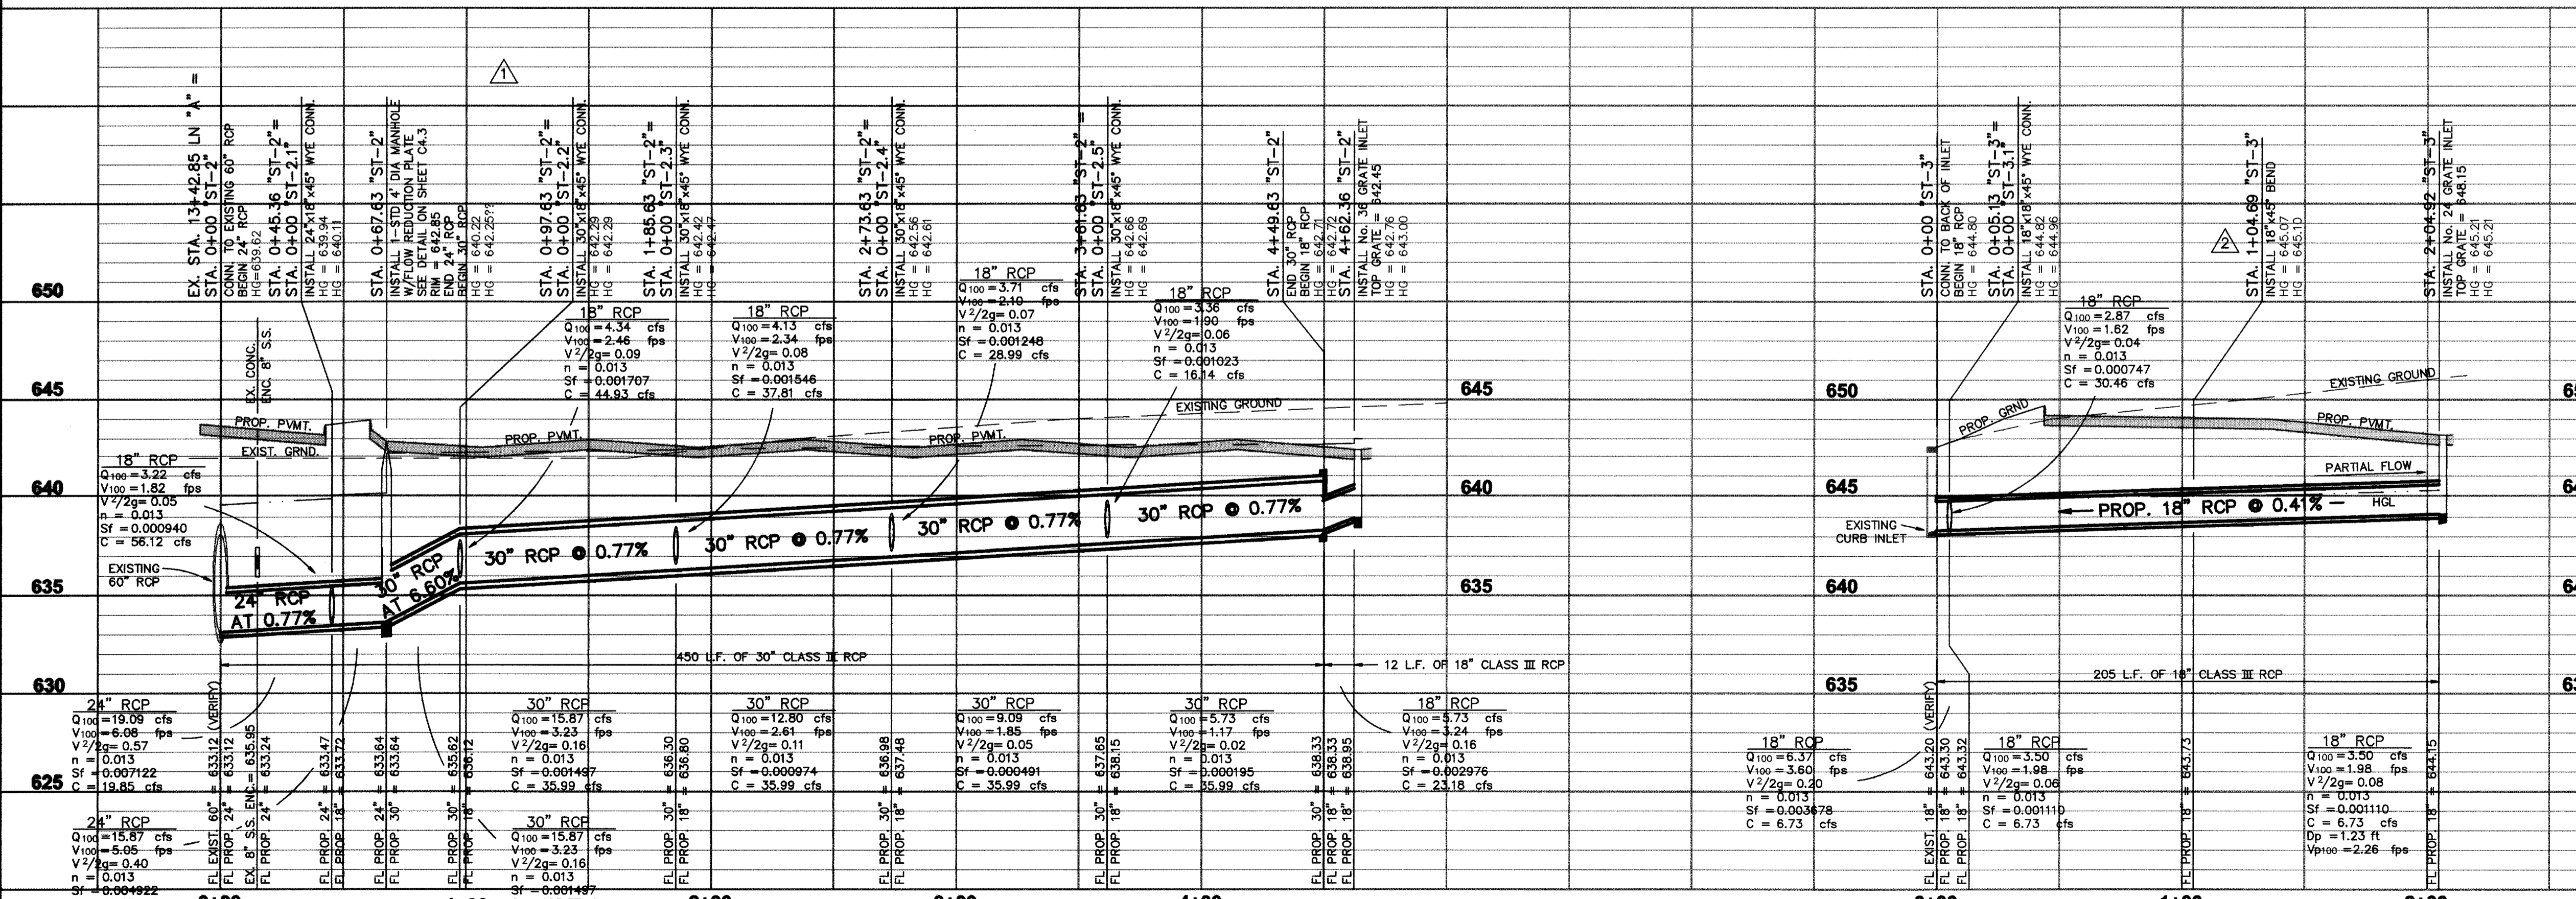

PROFILE "ST-2"
SCALE: HORIZ. 1"=40'
VERT. 1"=5'

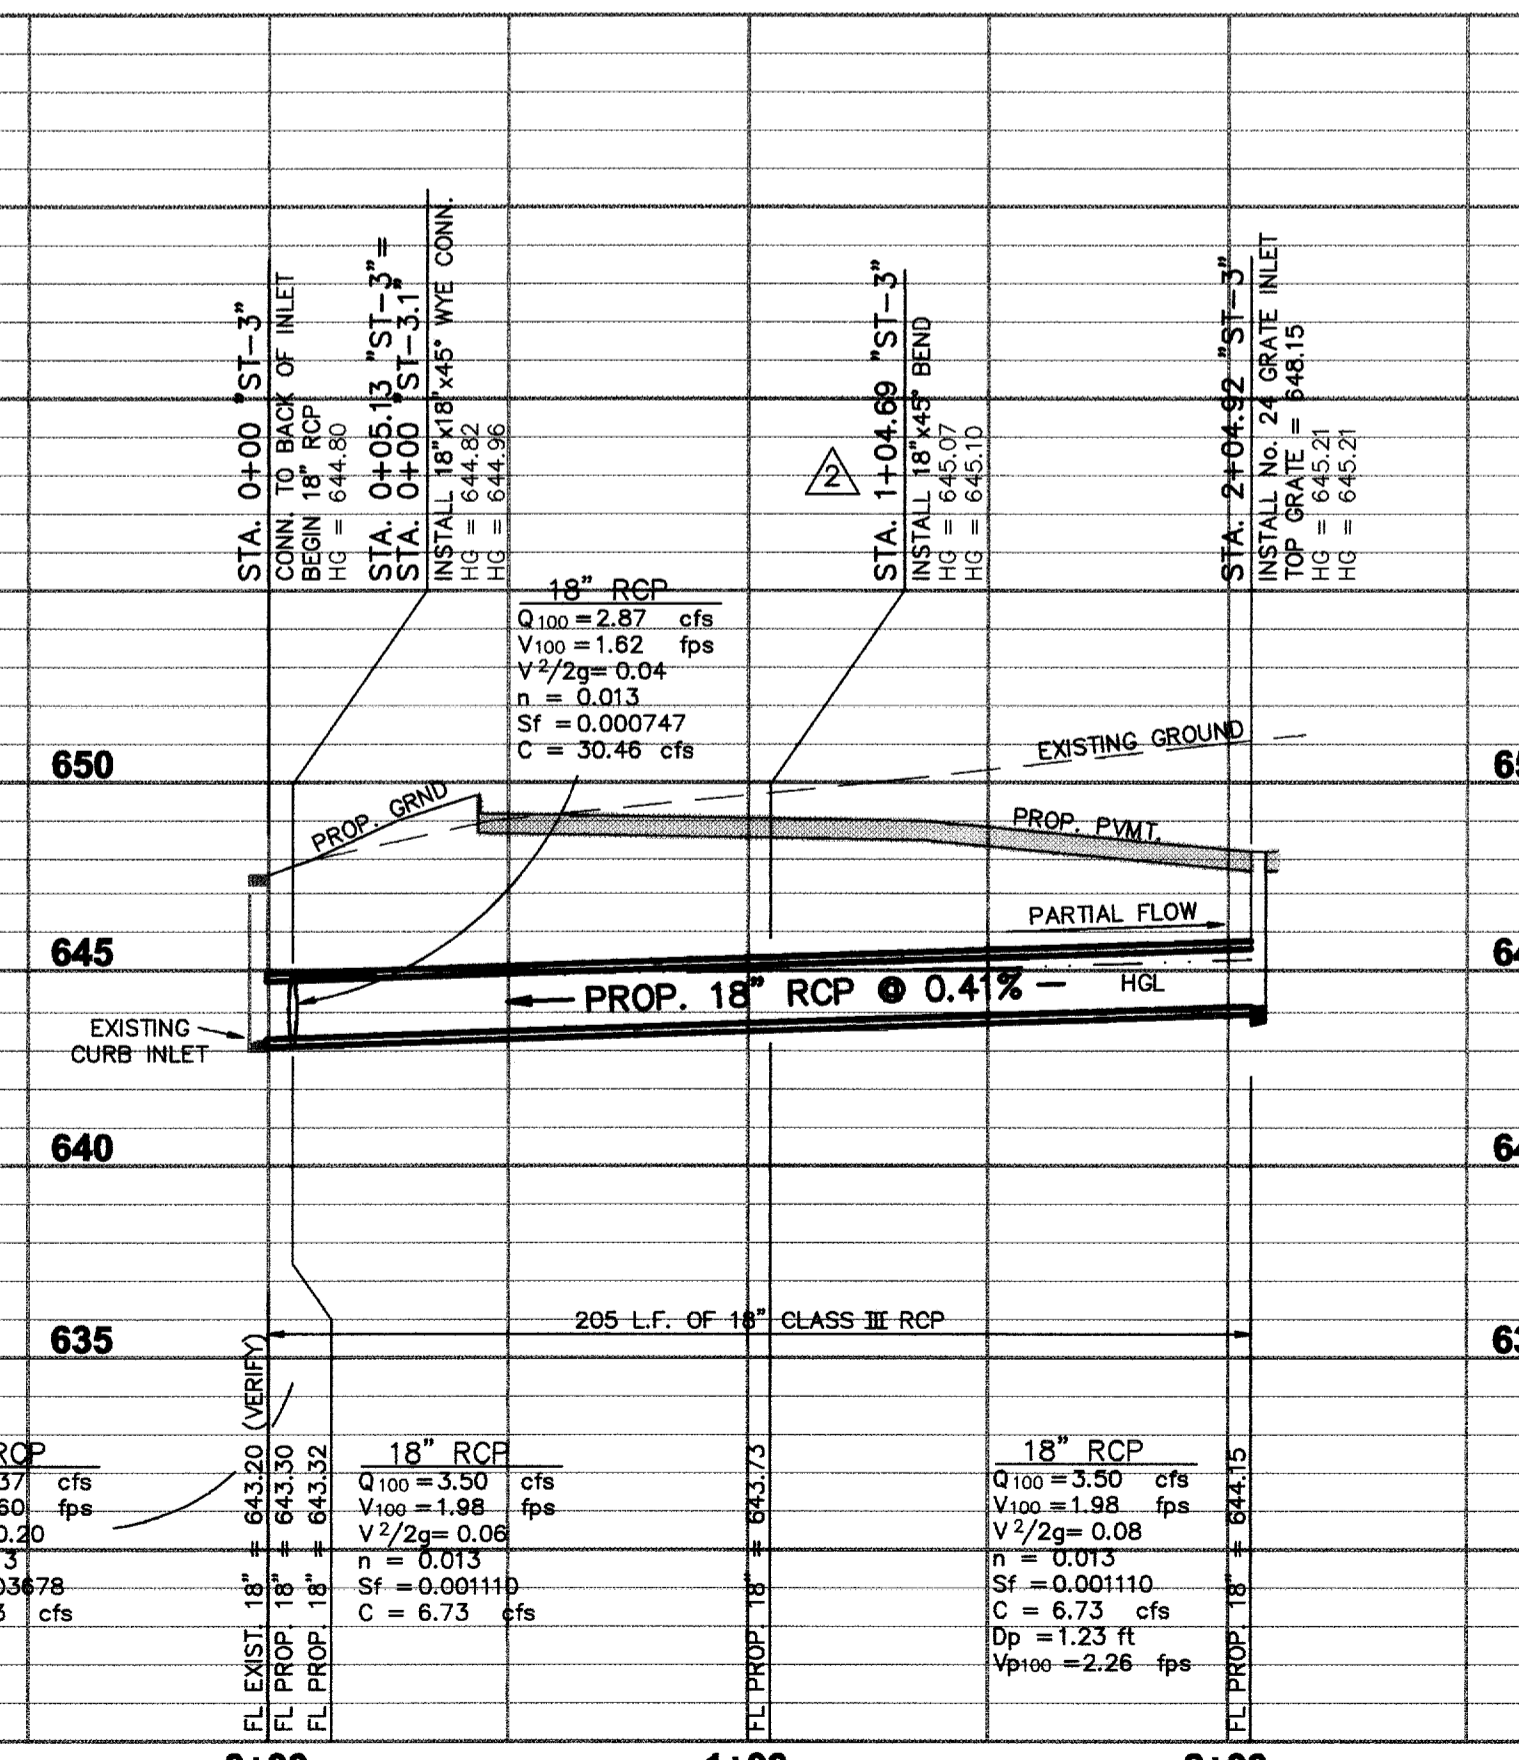

PROFILE "ST-3"
SCALE: HORIZ. 1"=40'
VERT. 1"=5'

RECORD DRAWING
THIS DRAWING HAS BEEN REVISED TO REFLECT CONSTRUCTION RECORDS MAINTAINED AND PROVIDED BY THE CONTRACTOR FOR THIS PROJECT.
CONTRACTOR: HILL & WILKINSON
DATE REVISED: 05/04/01



THE SEAL APPEARING ON THIS DOCUMENT WAS AUTHORIZED BY STEVEN A. MARKUSSEN, P.E. 70990 ON 07/26/00. ALTERATION OF A SEALED DOCUMENT WITHOUT PROPER NOTIFICATION TO THE RESPONSIBLE ENGINEER IS AN OFFENSE UNDER THE TEXAS ENGINEERING PRACTICE ACT.

REVISED 05/04/01
REVISED 11/27/00
REVISED 11/14/00

Pacheco Koch Consulting Engineers
9401 LBJ FREEWAY SUITE 300 DALLAS, TEXAS 75243 972.235.3031

STORM SEWER PROFILE
ADDISON OFFICE / WAREHOUSE COMPLEX
LOTS 1 & 2, BLOCK A
TOWN OF ADDISON, TEXAS

DESIGN	DRAWN	DATE	SCALE	NOTES	FILE	NO.
CJE	JLM	JULY 26, 2000	1"=40'			C4.4

PROJECT NO.: 9956
PREPARED BY: JLM
CHECKED BY: CJE
DATE: 7/26/00
REVISIONS: