

VOLUME 93228, PAGE 5470,
D.R.D.C.T.


AIRBORN DRIVE

NON-EXCLUSIVE EASEMENT
VOLUME 69218, PAGE 1486, D.R.D.C.T.,
AMENDED BY VOLUME 90240, PAGE 1548,
D.R.D.C.T.

LEGEND

| | | | |
|--|---|--|--------------------------|
| | PAVEMENT ON COMPACTED SUBGRADE PARKING AREA PAVEMENT FOR LIGHT AUTOMOBILE AND TRUCK TRAFFIC | | 5' SIDEWALK |
| | PAVEMENT ON COMPACTED SUBGRADE FIRE LANES AND DRIVE LANES AND AREAS SUBJECT TO LIGHT TO MEDIUM TRUCK TRAFFIC. | | NUMBER OF PARKING SPACES |
| | EXISTING FIRE LANE | | COVERED PARKING |
| | PAVEMENT ON COMPACTED SUBGRADE SERVICE AREAS (DUMPSTER) | | |

- NOTES:**
1. PARKING STALLS 8.5'x17' TYP
 2. ALL DIMENSIONS TO BACK OF CURB UNLESS OTHERWISE NOTED

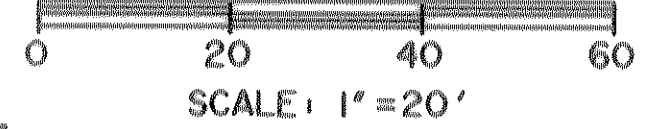

**CAUTION !!!
UNDERGROUND UTILITIES**

EXISTING UTILITIES AND UNDERGROUND FACILITIES INDICATED ON THESE PLANS HAVE BEEN LOCATED FROM REFERENCE INFORMATION SUPPLIED BY VARIOUS OWNERS OF THE FACILITIES. THE ENGINEER DOES NOT ACCEPT THE RESPONSIBILITY FOR THE UTILITY LOCATIONS SHOWN. IT SHALL BE THE RESPONSIBILITY OF THE CONTRACTOR TO VERIFY BOTH HORIZONTALLY AND VERTICALLY THE LOCATION OF ALL EXISTING UTILITIES AND UNDERGROUND FACILITIES PRIOR TO CONSTRUCTION, TO TAKE NECESSARY PRECAUTIONS IN ORDER TO PROTECT ALL FACILITIES ENCOUNTERED, AND TO NOTIFY THE ENGINEER PROMPTLY OF ALL CONFLICTS OF THE WORK WITH EXISTING FACILITIES. THE CONTRACTOR SHALL PRESERVE AND PROTECT ALL EXISTING UTILITIES FROM DAMAGE DURING CONSTRUCTION. ANY DAMAGE BY THE CONTRACTOR TO EXISTING UTILITIES SHALL BE REPAIRED BY THE CONTRACTOR AT HIS EXPENSE.

RECORD DRAWINGS
07-16-08

THE INFORMATION SHOWN ON THESE PLANS HAS BEEN REVISED TO REFLECT CHANGES TO THE PUBLIC IMPROVEMENTS MADE DURING CONSTRUCTION PROVIDED TO THE ENGINEER BY THE CONTRACTOR UNLESS NOTED OTHERWISE. THE CONSTRUCTION OF THE PUBLIC IMPROVEMENTS IS IN GENERAL CONFORMANCE WITH THESE PLANS BASED ON THE INFORMATION PROVIDED BY THE CONTRACTOR AND THE RESPONSIBILITY FOR ACCURACY AND COMPLETENESS BELONGS TO THE CONTRACTOR.

[Signature]
ULYS LANE, III
DATE 7-16-08

PREPARED BY:
VIA WIER & ASSOCIATES, INC.
ENGINEERS SURVEYORS LAND PLANNERS
701 HIGHLANDER BLVD., SUITE 300 ARLINGTON, TEXAS 76015 METRO (817)467-7700
1380 U.S. HIGHWAY 287 N. SUITE 101 WANSFIELD, TEXAS 76063 METRO (817)477-8700
6649 ELM STREET FRISCO, TEXAS 75034 METRO (214)387-8000
www.viawierassociates.com

| NO. | DATE | DESCRIPTION | BY |
|-----|------|-------------|----|
| | | | |
| | | | |
| | | | |

LOT 4, BLOCK A
SOJOURN PLAZA
TOWN OF ADDISON
DALLAS COUNTY, TEXAS

PAVING PLAN

STATE OF TEXAS
ULYS LANE III
40864
REGISTERED
PROFESSIONAL ENGINEER
7-16-08

COPYRIGHT ©
WIER & ASSOCIATES, INC.
LAST SHEET EDIT
DATE 07-15-2008
WA# 01095-03

SHEET NO.
P101