
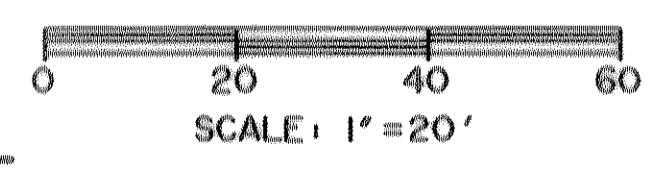


LEGEND

	650	PROP. CONTOUR		HANDICAP ACCESSIBLE ROUTE MAXIMUM 1.8% CROSS SLOPE, 4.8% LONGITUDINAL SLOPE
	650	EXISTING CONTOUR		ADA LANDING AREA MAX 2% CROSS SLOPE ANY DIRECTION
		PROP. STORM DRAIN		ADA RAMP LOCATION
	611.0	PROP. SPOT ELEVATION		BREAK LINE
	x611.0	EX. SPOT ELEVATION		
	T/C	TOP OF CURB		
	T/W	TOP OF WALL		
	B/W	BASE OF WALL		
	T/P	TOP OF PAVEMENT		
	T/I	TOP OF INLET		
	RIM	INLET RIM		
		FLOW ARROW		
		SWALE LINE		

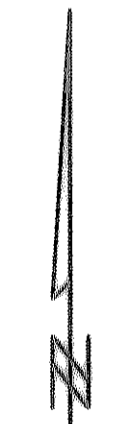

**CAUTION !!!
UNDERGROUND UTILITIES**

EXISTING UTILITIES AND UNDERGROUND FACILITIES INDICATED ON THESE PLANS HAVE BEEN LOCATED FROM REFERENCE INFORMATION SUPPLIED BY VARIOUS OWNERS OF THE FACILITIES. THE ENGINEER DOES NOT ACCEPT THE RESPONSIBILITY FOR THE UTILITY LOCATIONS SHOWN. IT SHALL BE THE RESPONSIBILITY OF THE CONTRACTOR TO VERIFY BOTH HORIZONTALLY AND VERTICALLY THE LOCATION OF ALL EXISTING UTILITIES AND UNDERGROUND FACILITIES PRIOR TO CONSTRUCTION. TO TAKE NECESSARY PRECAUTIONS IN ORDER TO PROTECT ALL FACILITIES ENCOUNTERED, AND TO NOTIFY THE ENGINEER PROMPTLY OF ALL CONFLICTS OF THE WORK WITH EXISTING FACILITIES. THE CONTRACTOR SHALL PRESERVE AND PROTECT ALL EXISTING UTILITIES FROM DAMAGE DURING CONSTRUCTION. ANY DAMAGE BY THE CONTRACTOR TO EXISTING UTILITIES SHALL BE REPAIRED BY THE CONTRACTOR AT HIS EXPENSE.

RECORD DRAWINGS
07-16-08

THE INFORMATION SHOWN ON THESE PLANS HAS BEEN REVISED TO REFLECT CHANGES TO THE PUBLIC IMPROVEMENTS MADE DURING CONSTRUCTION PROVIDED TO THE ENGINEER BY THE CONTRACTOR UNLESS NOTED OTHERWISE. THE CONSTRUCTION OF THE PUBLIC IMPROVEMENTS IS IN GENERAL CONFORMANCE WITH THESE PLANS BASED ON THE INFORMATION PROVIDED BY THE CONTRACTOR AND THE RESPONSIBILITY FOR ACCURACY AND COMPLETENESS BELONGS TO THE CONTRACTOR.

ULYS LANE, III
DATE 7-16-08

PREPARED BY:
WIER & ASSOCIATES, INC.
ENGINEERS SURVEYORS LAND PLANNERS
701 HIGHLANDER BLVD., SUITE 300 ARLINGTON, TEXAS 76015 METRO (817)467-7700
1380 U.S. HIGHWAY 281 N. SUITE 101 WANSFIELD, TEXAS 76063 METRO (817)477-8700
6849 EDM STREET FROSTO, TEXAS 75034 METRO (214)381-8000
www.wierassociates.com

NO.	DATE	DESCRIPTION	BY

LOT 4, BLOCK A
SOJOURN PLAZA
TOWN OF ADDISON
DALLAS COUNTY, TEXAS

GRADING PLAN



COPYRIGHT ©
WIER & ASSOCIATES, INC.
LAST SHEET EDIT
DATE 07-16-2008
WA# 01095.03
SHEET NO. G101