


6 omi REVISE PER AS BUILT 6-14-84

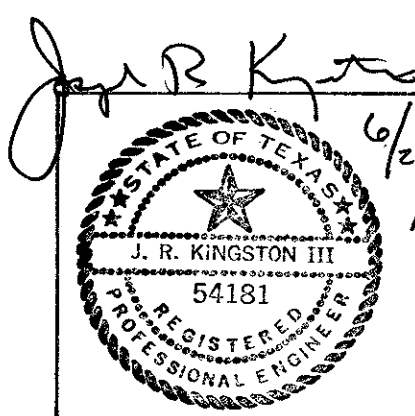

NO.	DESCRIPTION	ISSUE DATE
5	RELOCATE DRAIN & HYDRANT	9-12-83
4	EXTEND PIPES	8-2-83
3	RELOCATE TRANSFORMER PAD	8-9-83
2	WIDEN LANDSCAPE BUFFER LOCATE T.P.	7-12-83
1	RELOCATE WATER LINE	6-17-83

BAY SIZE	SPAN	CUSTOMER BUILDERS
FRAMING	ROOF SLOPE	EAVE HEIGHT
DRAWN BY	CHECKED BY	LENGTH
DESIGNED BY	ILL.	JOB NO.
ISSUE BY	DESCRIPTION	ISSUE DATE

Delta Steel Buildings
CECO

4300 WEST GROVE ROAD
ADDISON AIRPORT

UTILITY SITE PLAN

163-J-83

6/16/83

4505

6