


# CONSTRUCTION PLANS FOR MILLION AIR TERMINAL / HANGAR - PHASE 2 LEASE PARCEL No. 70 - WESTGROVE ROAD TOWN OF ADDISION, DALLAS COUNTY, TEXAS

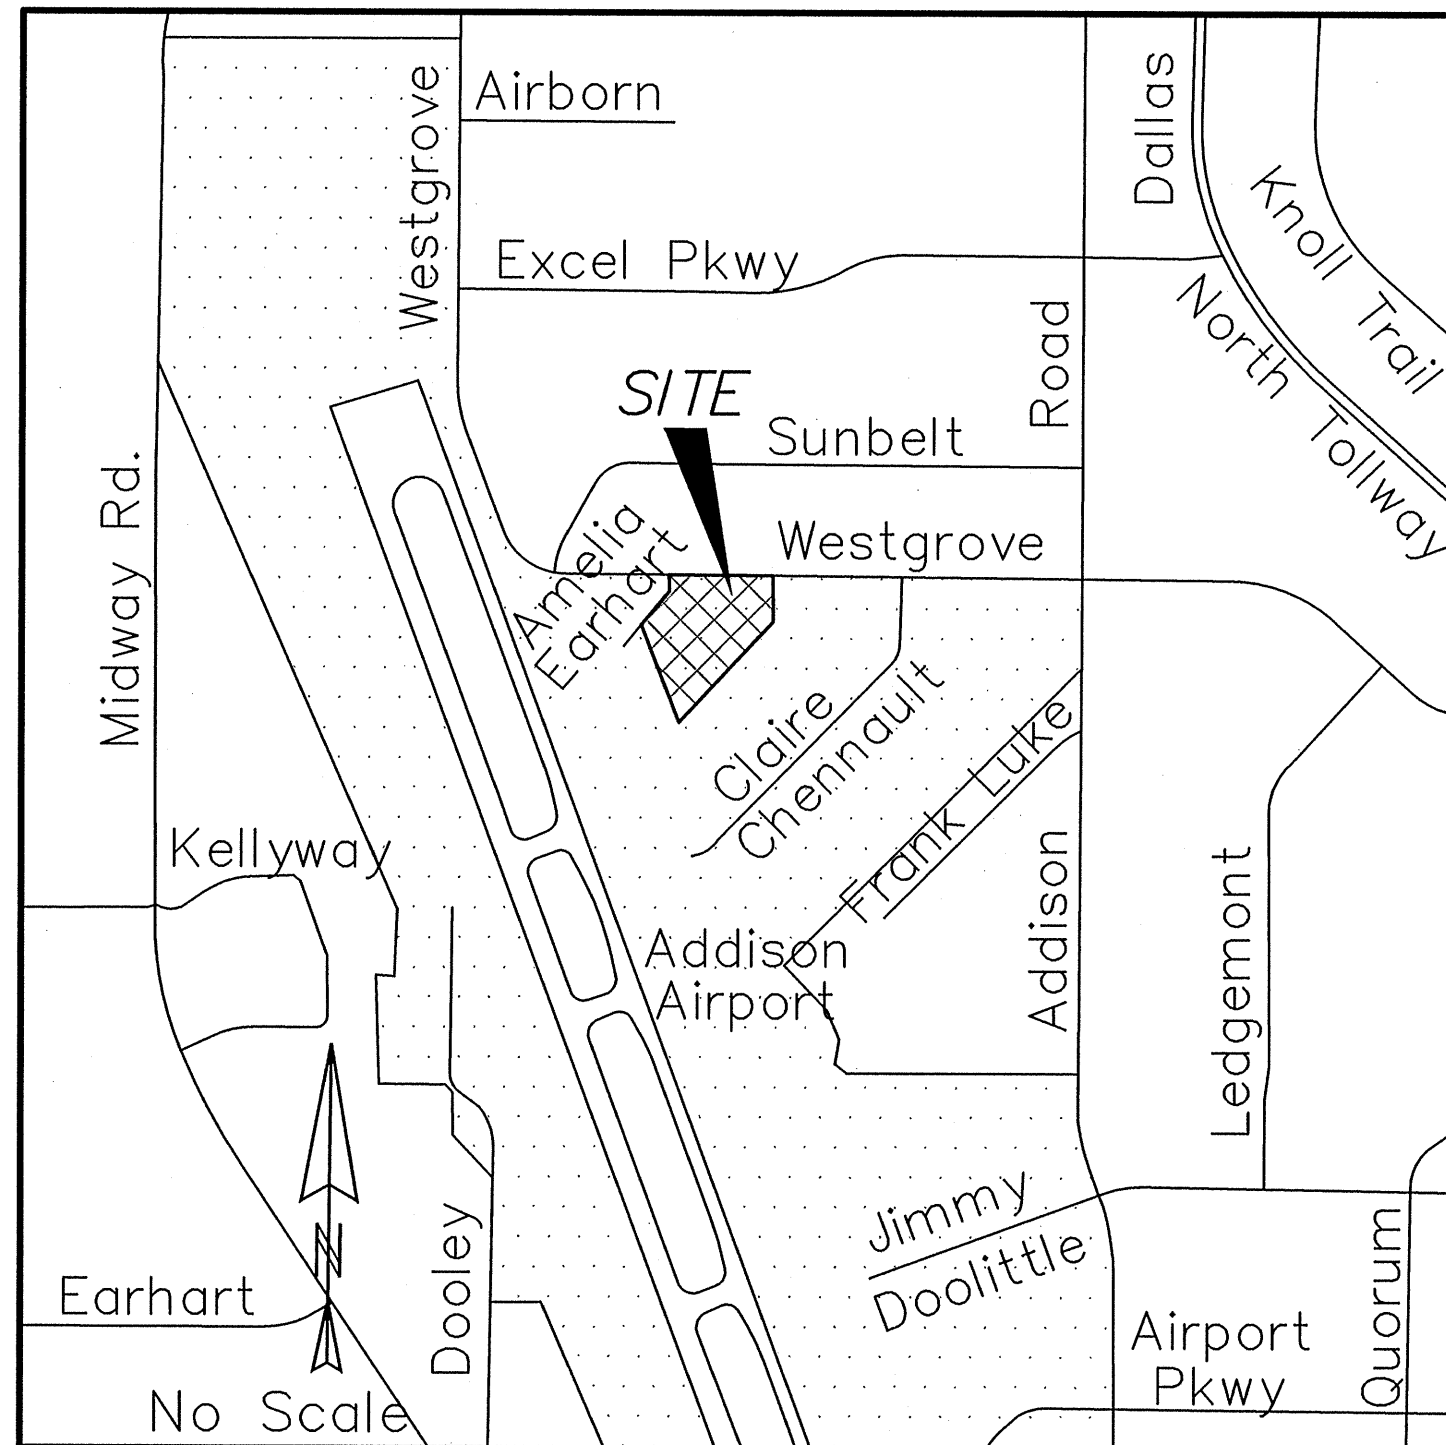


VICINITY MAP

## SHEET INDEX

SHEET NO.	DESCRIPTION
1	COVER
2	DEMOLITION PLAN
3	DIMENSIONAL CONTROL PLAN
4	DRAINAGE AREA MAP
5	GRADING & PAVING PLAN
6	CIRCLE AREA GRAD/PAVING
7	RAMP JOINT PLAN
8 - 10	UTILITY PLAN & PROFILES
11 & 12	EROSION CONTROL & NOTES
13 & 14	DETAILS & NOTES

RECORD DRAWING  
*[Signature]*  
DATE: *October 26, 2010*

Based on information furnished from the Contractor and to the best of the design engineer's knowledge, the constructed work is substantially in accordance with this plan.

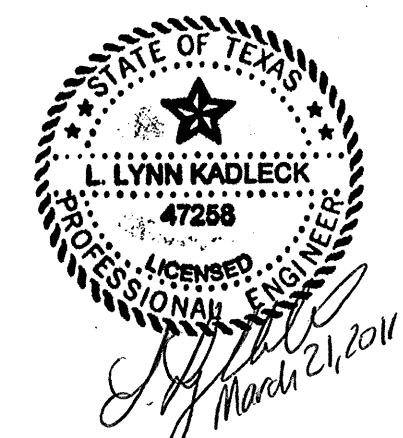

*[Signature]*  
March 21, 2011

THE MISSION COMPANIES  
P.O. BOX 639  
ADDISION, TEXAS 75001  
PH: (972)248-4500

PREPARED BY  
**KADLECK & ASSOCIATES**  
ENGINEERING PLANNING SURVEYING  
2000 N. CENTRAL EXPY. SUITE 113  
(972) 881-0771 PLANO, TX 75074  
TBPB Reg. No. T-6460 TBPBS Reg. No. 100555-00

K&A PROJECT #10544