

ERIC L. DAVIS ENGINEERING, INC.
 F-3987
 120 East Main Street
 Forney, Texas 75126
 972/564-0592 Fax 972/564-6523
 E-Mail ericdavis@eldengineering.com



UTILITY PLAN
 ENGINEERED FOR:
BENTLEY CUSTOM HOMES

PLAN: GRADING
 ELD JOB NO.:
 DRAWN BY: BW
 FIRM REGISTRATION #: 3987

BUILDER: BENTLEY CUSTOM HOMES
 ADDITION:
 ADDRESS: 4397 WESTGROVE
 LOT: BLOCK: A
 CITY: ADDISON, TEXAS


SCALE: 1"=20'

SHEET G02

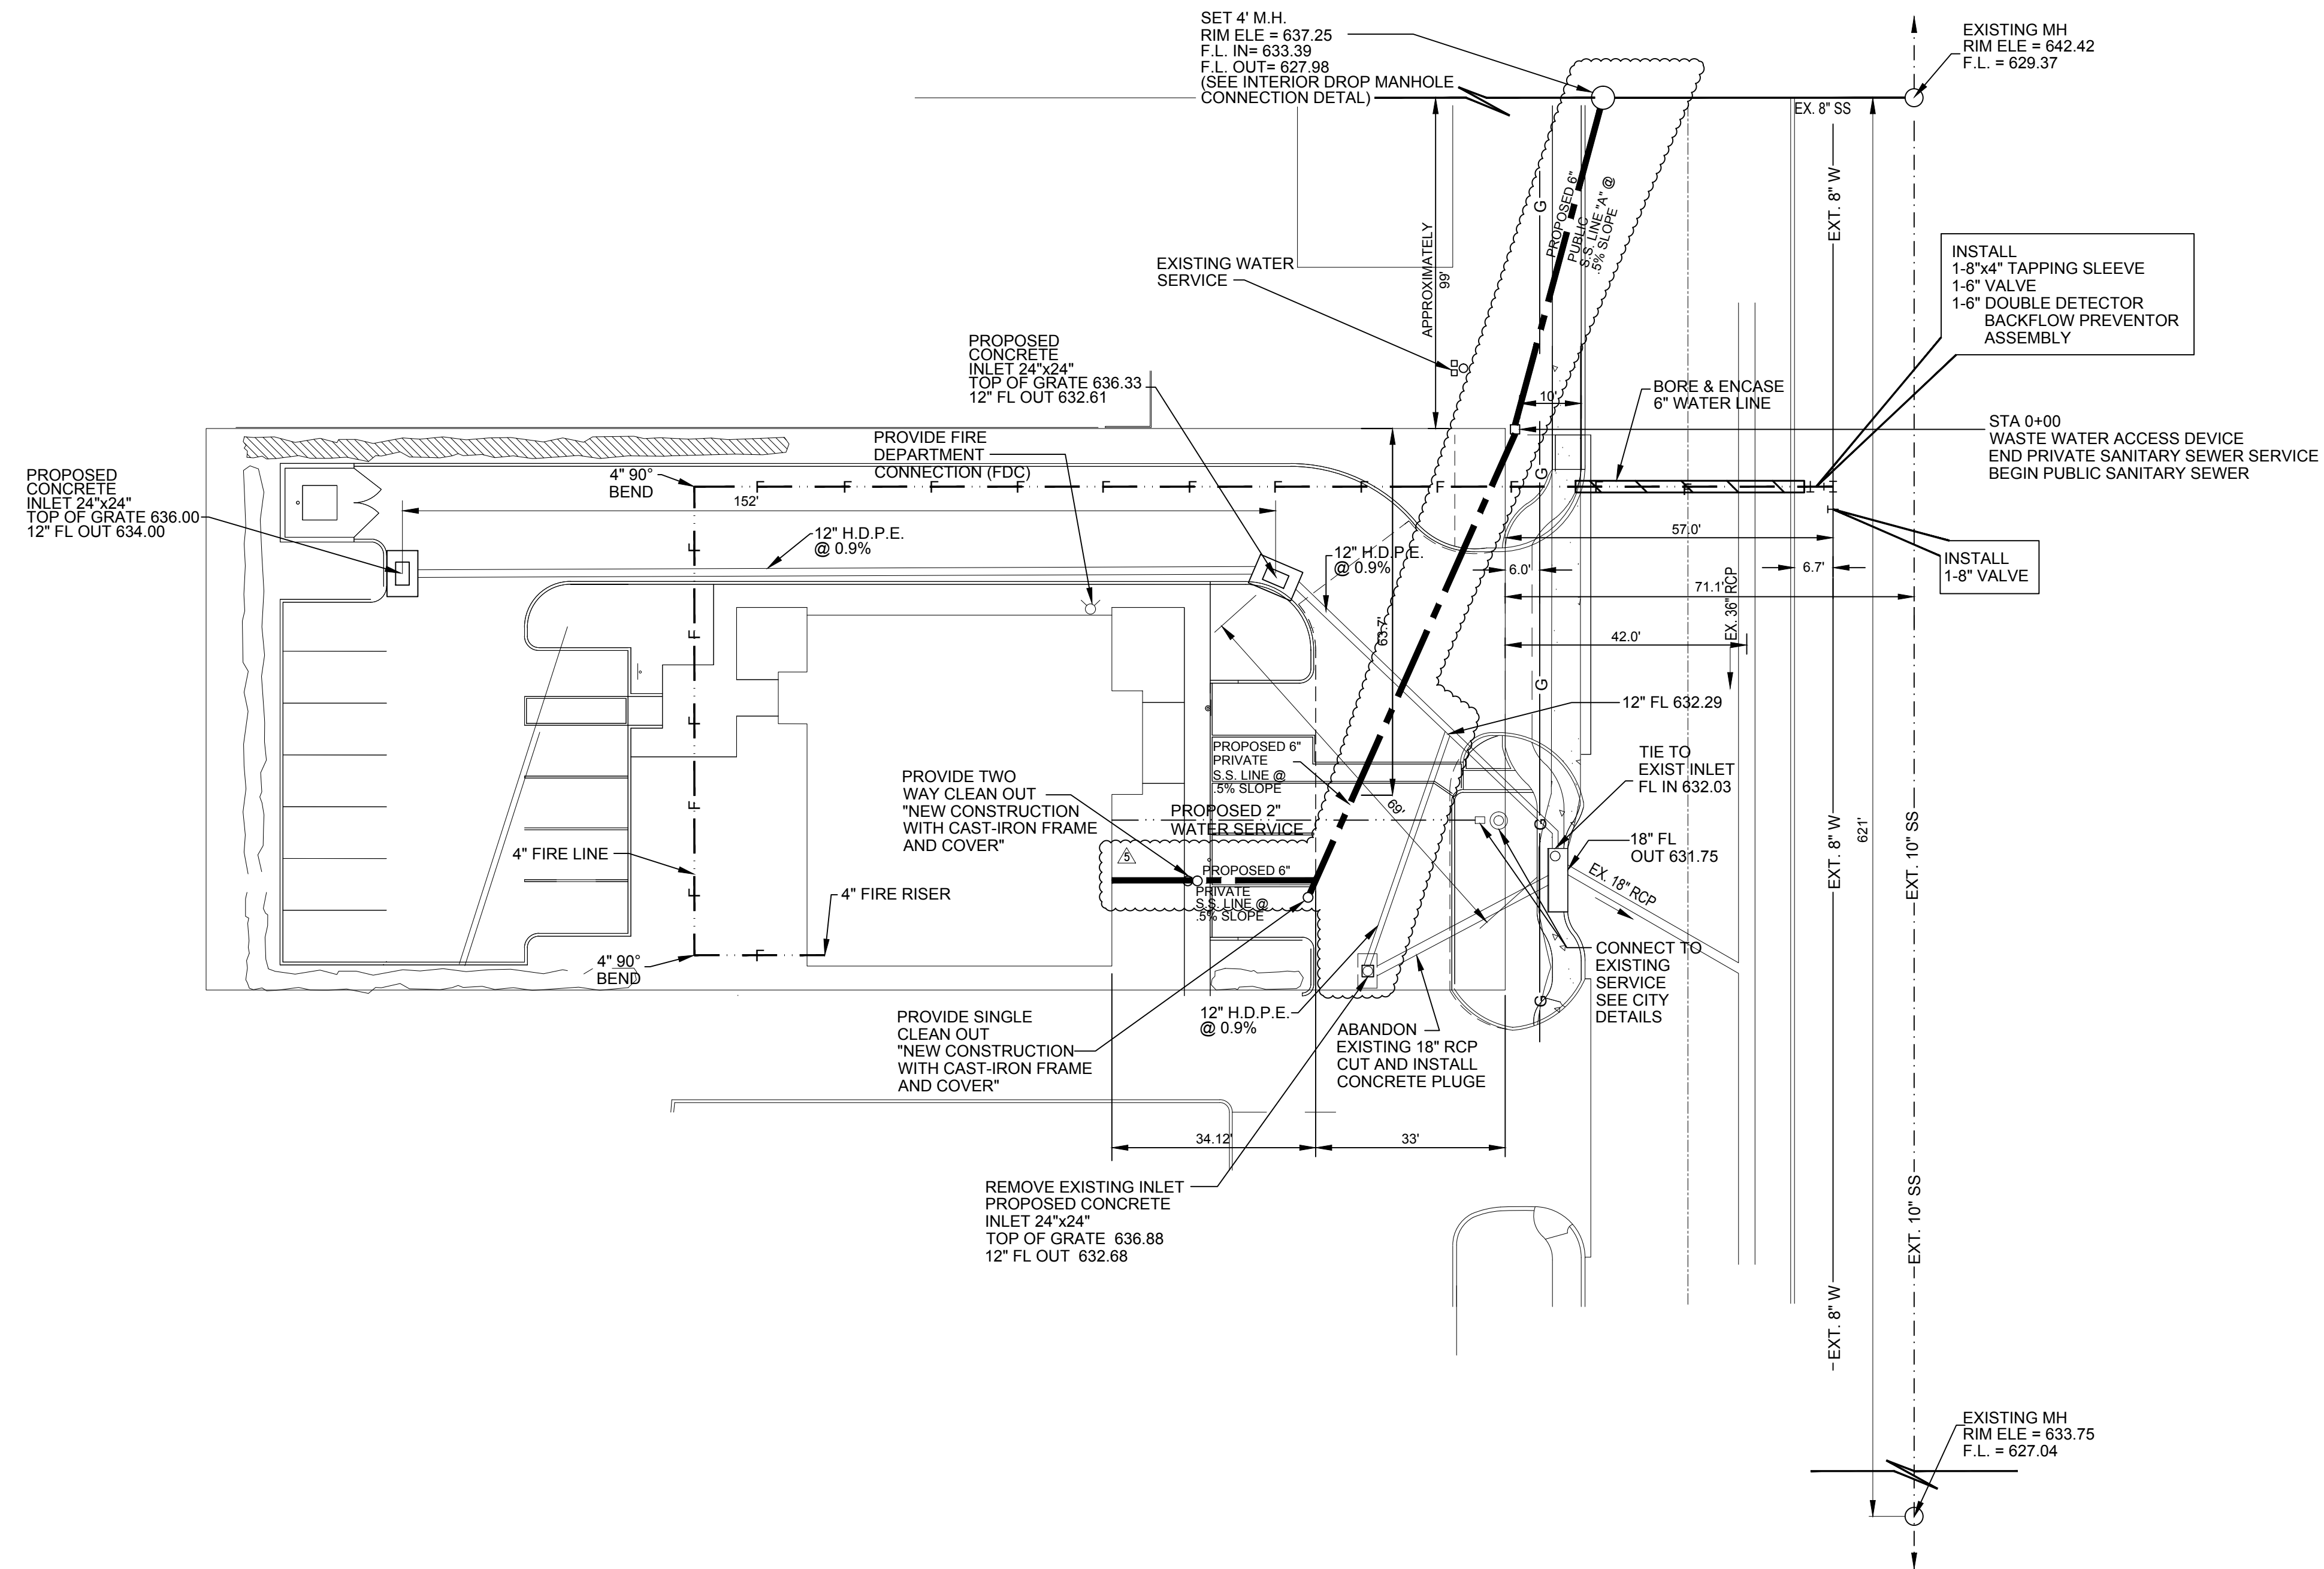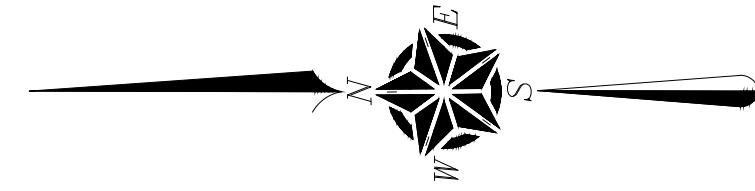

REVISIONS	CODE
1. 5/12/14 RELOCATE SAN. SEWER LINE	T
2. 1/29/15 CITY COMMENTS	T
3. 1/21/16 RELOCATE SAN. SEWER LINE	T
4. 1/28/16 CITY COMMENTS	T
5. 2/09/16 CITY COMMENTS	T

NOTE:
 ELEVATIONS AND LOCATIONS ARE FROM BEST SOURCES AVAILABLE. CONTRACTOR TO VERIFY ALL UTILITY LOCATIONS AND ELEVATIONS PRIOR TO WORK. IF DISCREPANCIES ARE NOTED, CONTACT ENGINEER IMMEDIATELY.

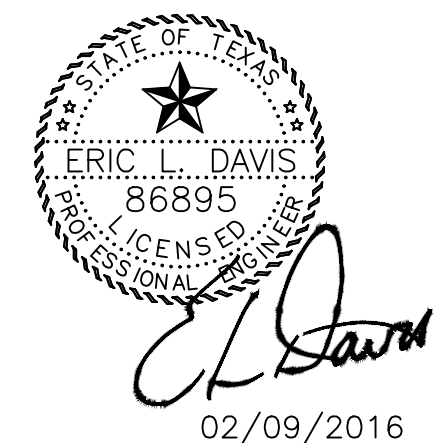

02/09/2016