

CONSTRUCTION PLANS FOR MEHRDAD HANGAR ADDISON AIRPORT


LEASEHOLD ESTATE TRACT II
GROUND LEASE #080A-29 ALP#U23
1.458 ACRES (63,510.5 SQ.FT.)
HANGAR FACILITY
4700 WESTGROVE DRIVE
ADDISON TX 75001
CITY PROJECT #2016-14

APPROVED FOR CONSTRUCTION		
	DATE	SIGNATURE
PLANNING & ZONING		
ENGINEERING		
BUILDING INSPECTION		
FIRE PREVENTION		
PARKS & LEISURE		
PUBLIC WORKS		
HR/ADA		

APPROVED FOR CONSTRUCTION			
	COMPANY NAME	DATE	SIGNATURE
ELECTRIC			
GAS			
PHONE			
CABLE			
SOLID WASTE			

INDEX OF DRAWINGS

- C1 EXISTING CONDITIONS
- C2 SITE PLAN
- C3 OFFSITE DRAINAGE AREA MAP
- C4 DRAINAGE AREA MAP
- C5 GRADING PLAN
- C6 PAVING PLAN
- C6.1 TYPICAL PAVING DETAILS
- C7.1 WATER AND WASTEWATER PLAN
- C7.2 WASTEWATER PROFILE
- C8 FRANCHISE UTILITY PLAN
- C9 EROSION CONTROL PLAN
- C10 SWPPP
- C11 GENERAL NOTES
- C12 DETAILS
- C13 DETAILS
- C14 DETAILS
- C15 DETAILS
- L1.01 LANDSCAPE PLAN
- L1.02 LANDSCAPE SPECIFICATIONS
- EE1 EASEMENT EXHIBIT

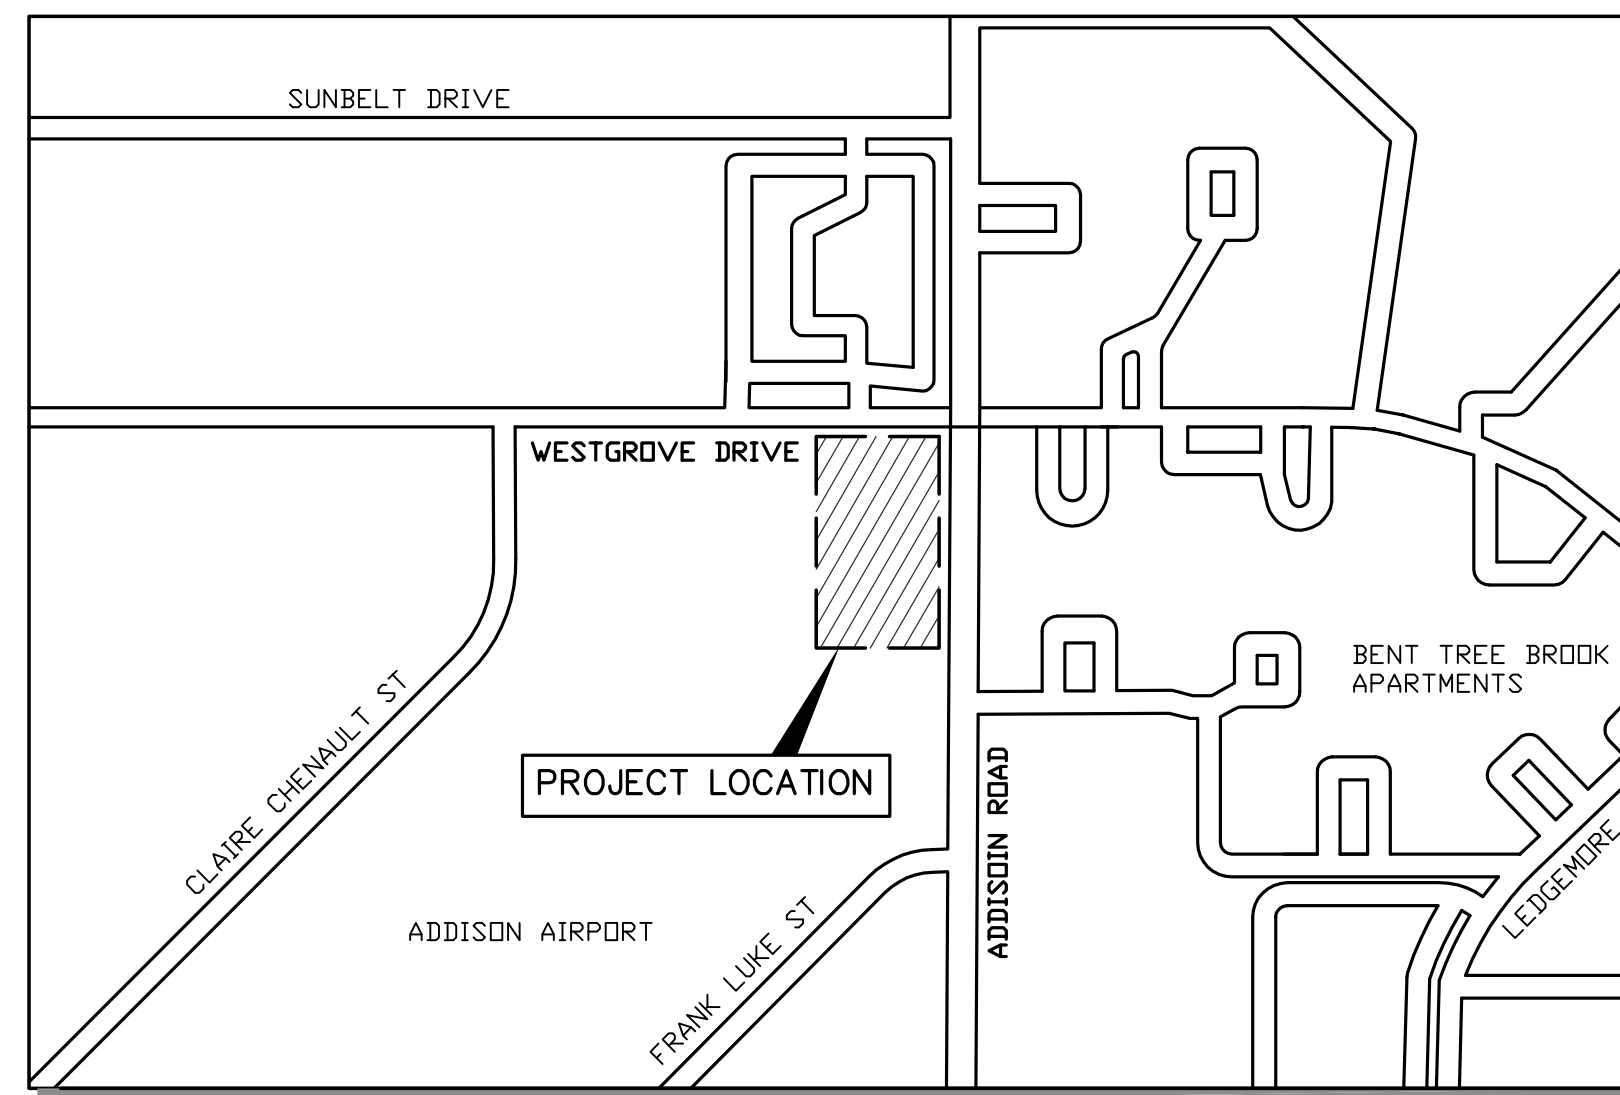

LOCATION MAP
N.T.S.

OWNER AND APPLICANT:

CENTURION AMERICAN DEVELOPMENT GROUP
1800 VALLEY VIEW LANE SUITE 300
FARMERS BRANCH, TX 75234
PHONE: 469.892.7200
FAX: 469.892.7201

CIVIL ENGINEER:

VIEWTECH INC.
TEXAS FIRM REG. #F-2658
4205 BELTWAY DRIVE
ADDISON, TEXAS 75001
PHONE: (972) 661-8187
FAX: (972) 661-8172
CONTACT: AARON WOLF, P.E.
EMAIL: AW@VTINC.NET

AS-BUILT
10/25/2018

THE SEAL APPEARING ON THIS DOCUMENT WAS AUTHORIZED BY VICTOR LISSIAK, JR., P.E. 30565 ON 10/25/2018



ISSUED FOR CONSTRUCTION: 10/24/16