




Addison! PUBLIC WORKS DEPARTMENT

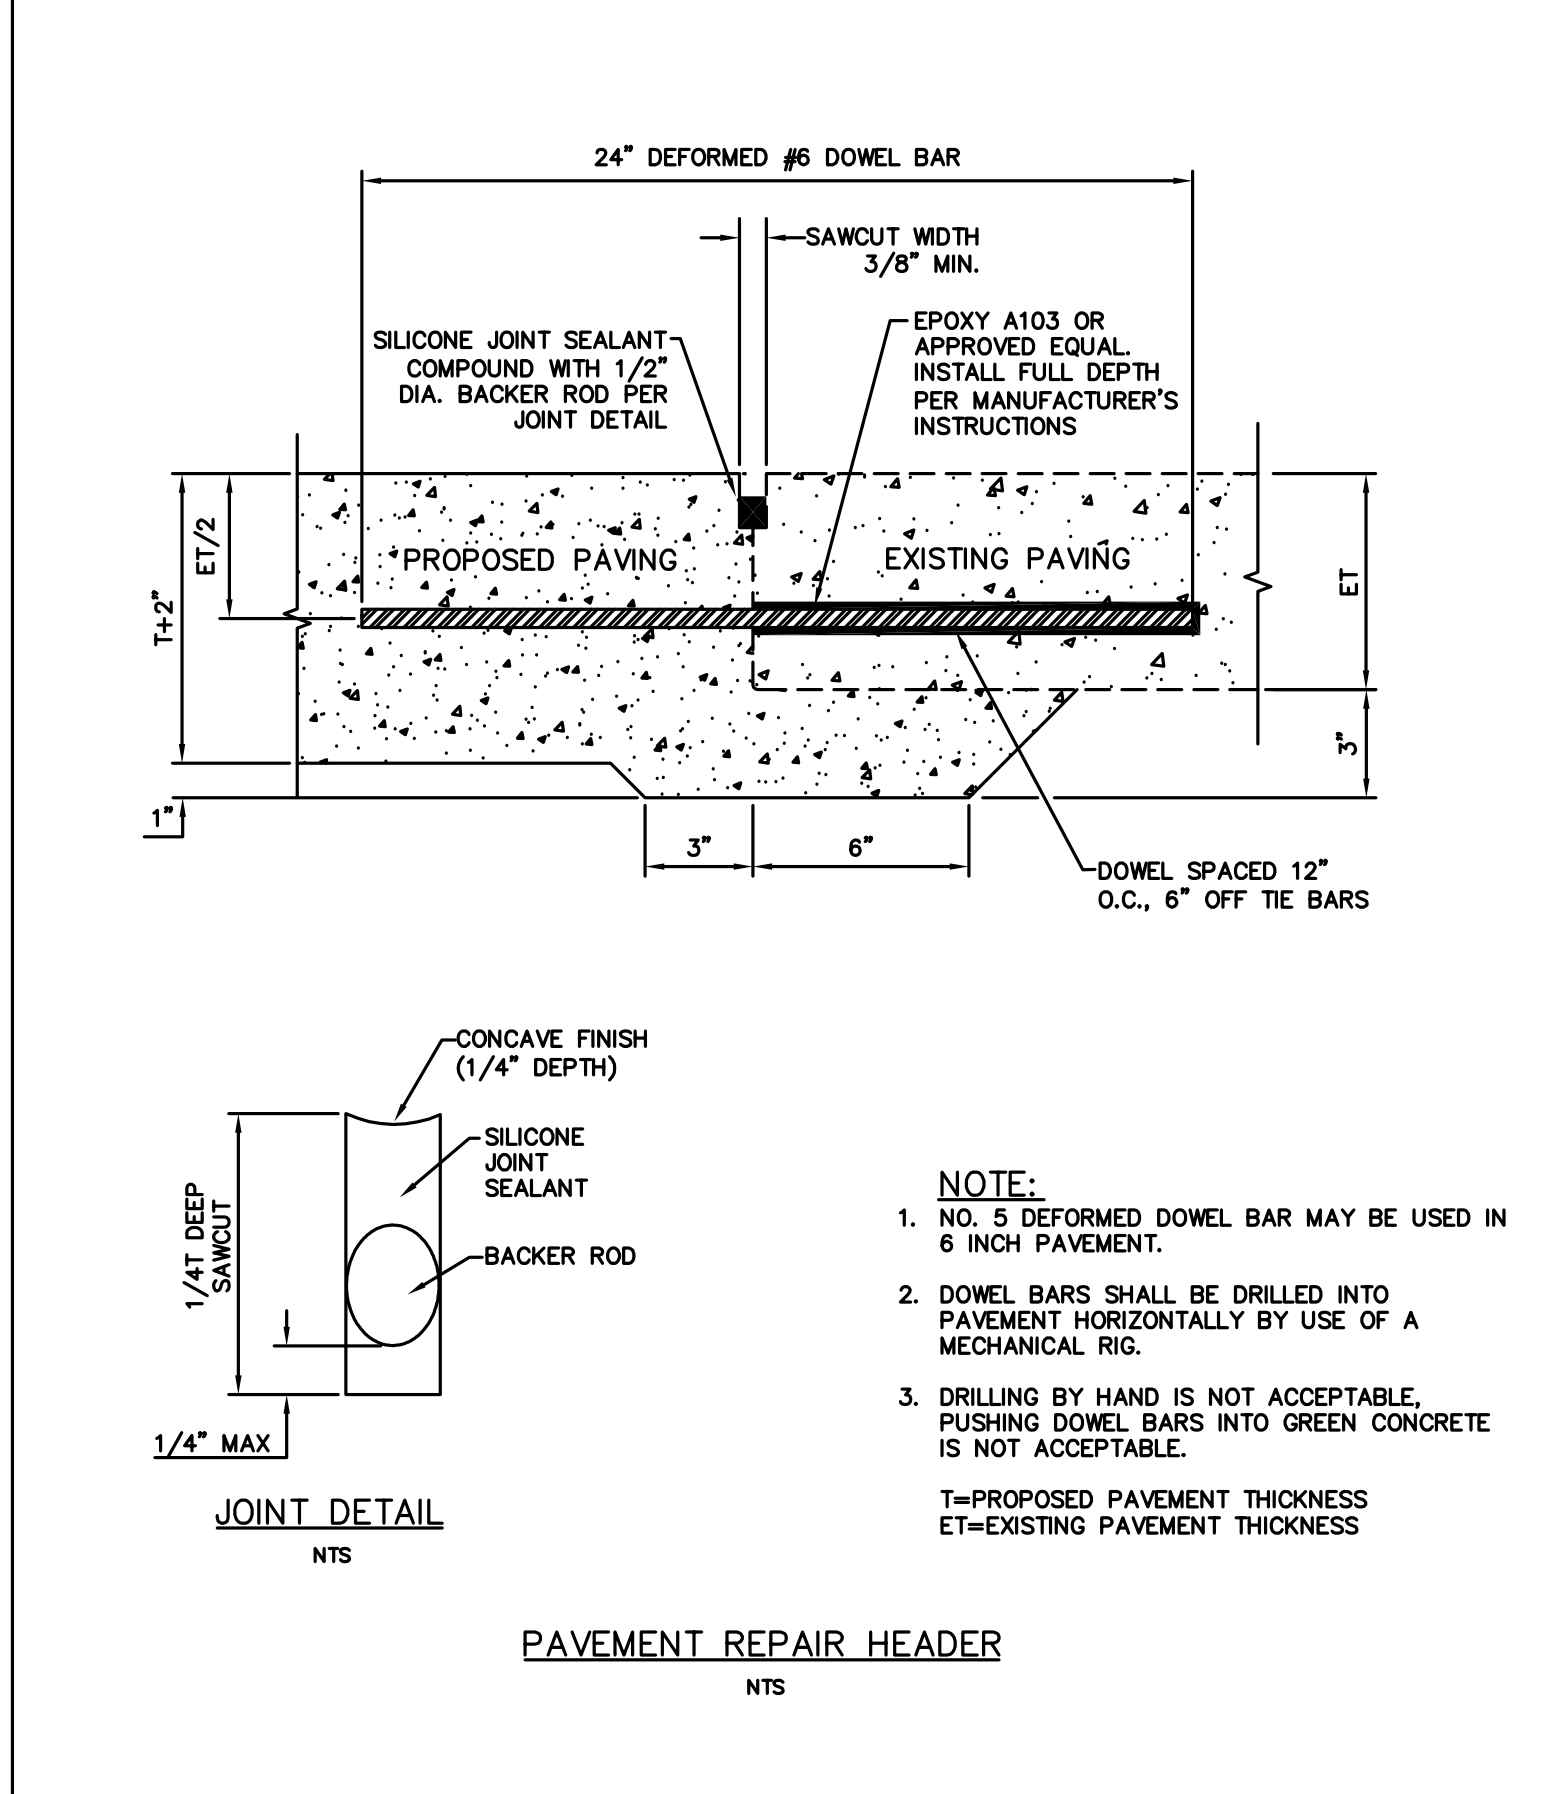


Addison! PUBLIC WORKS DEPARTMENT

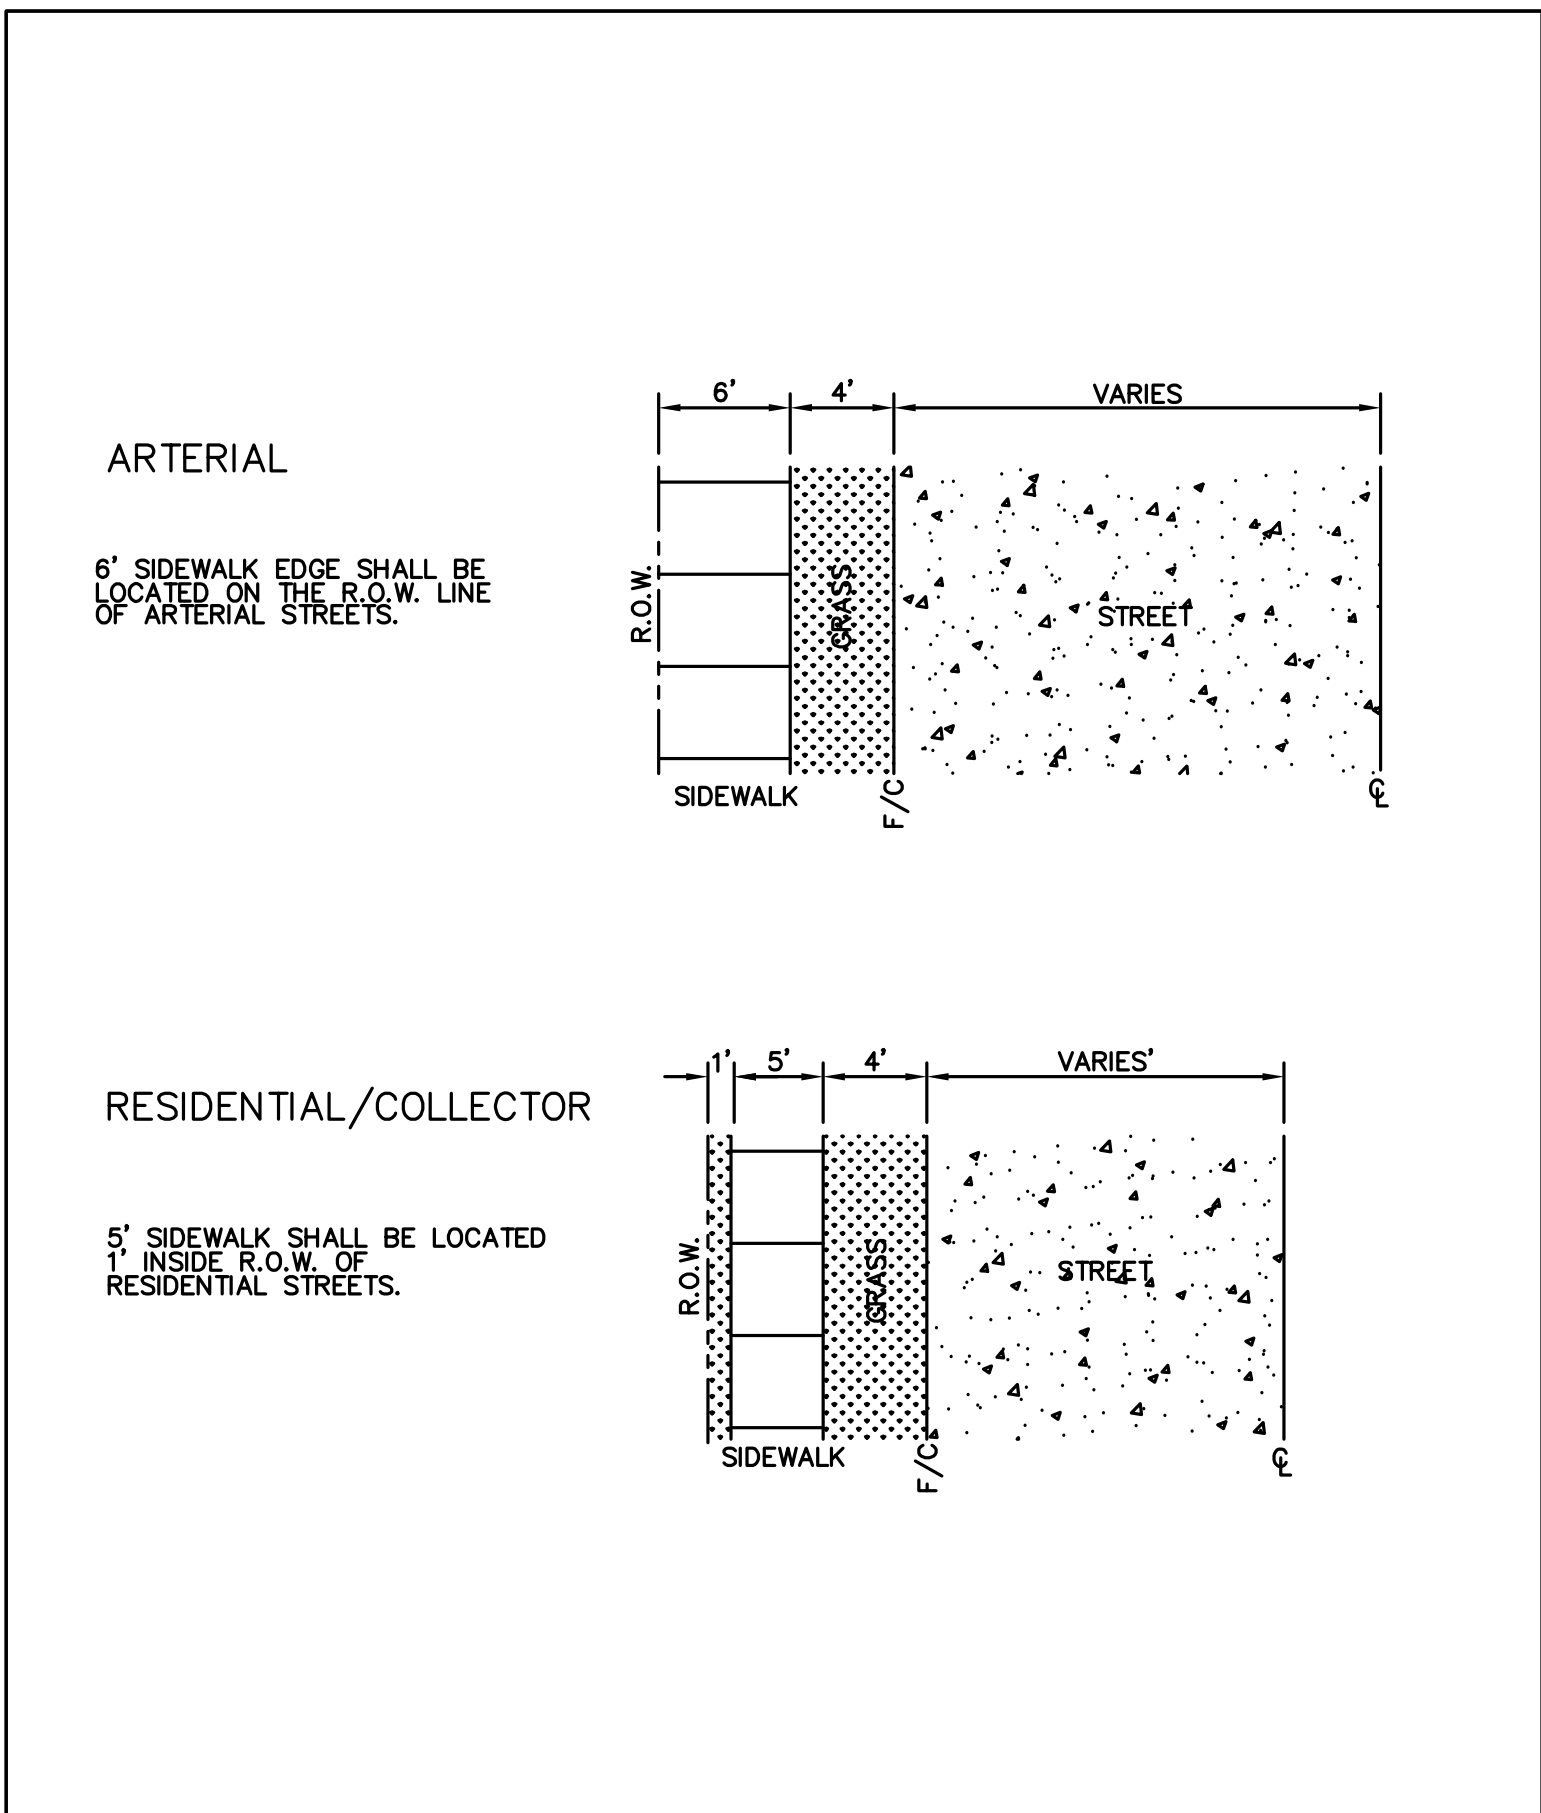

Addison! PUBLIC WORKS DEPARTMENT

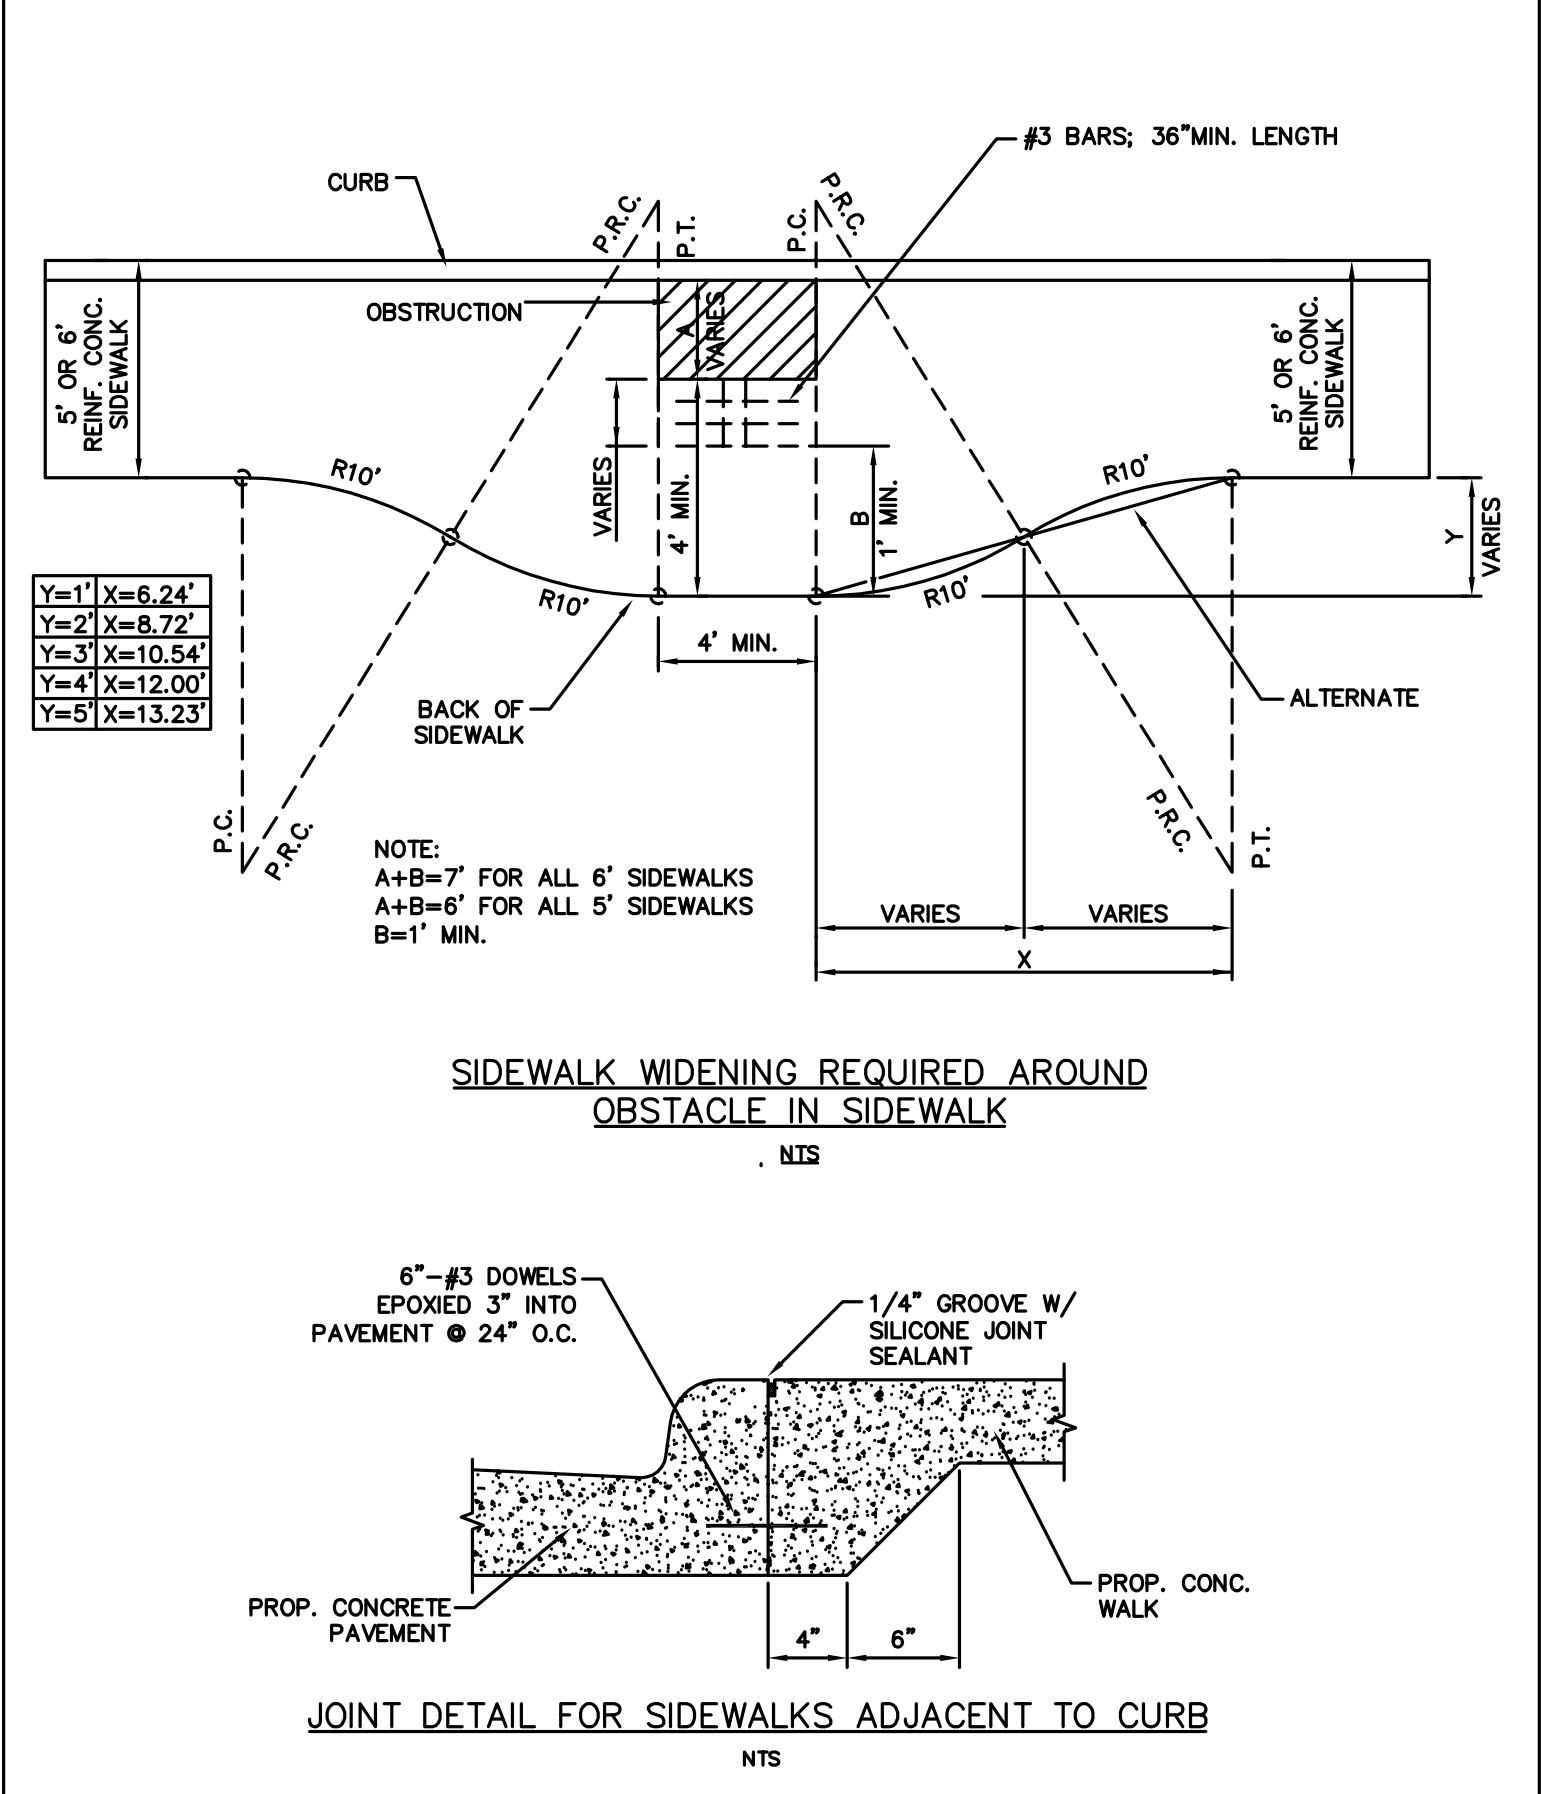

Addison! PUBLIC WORKS DEPARTMENT

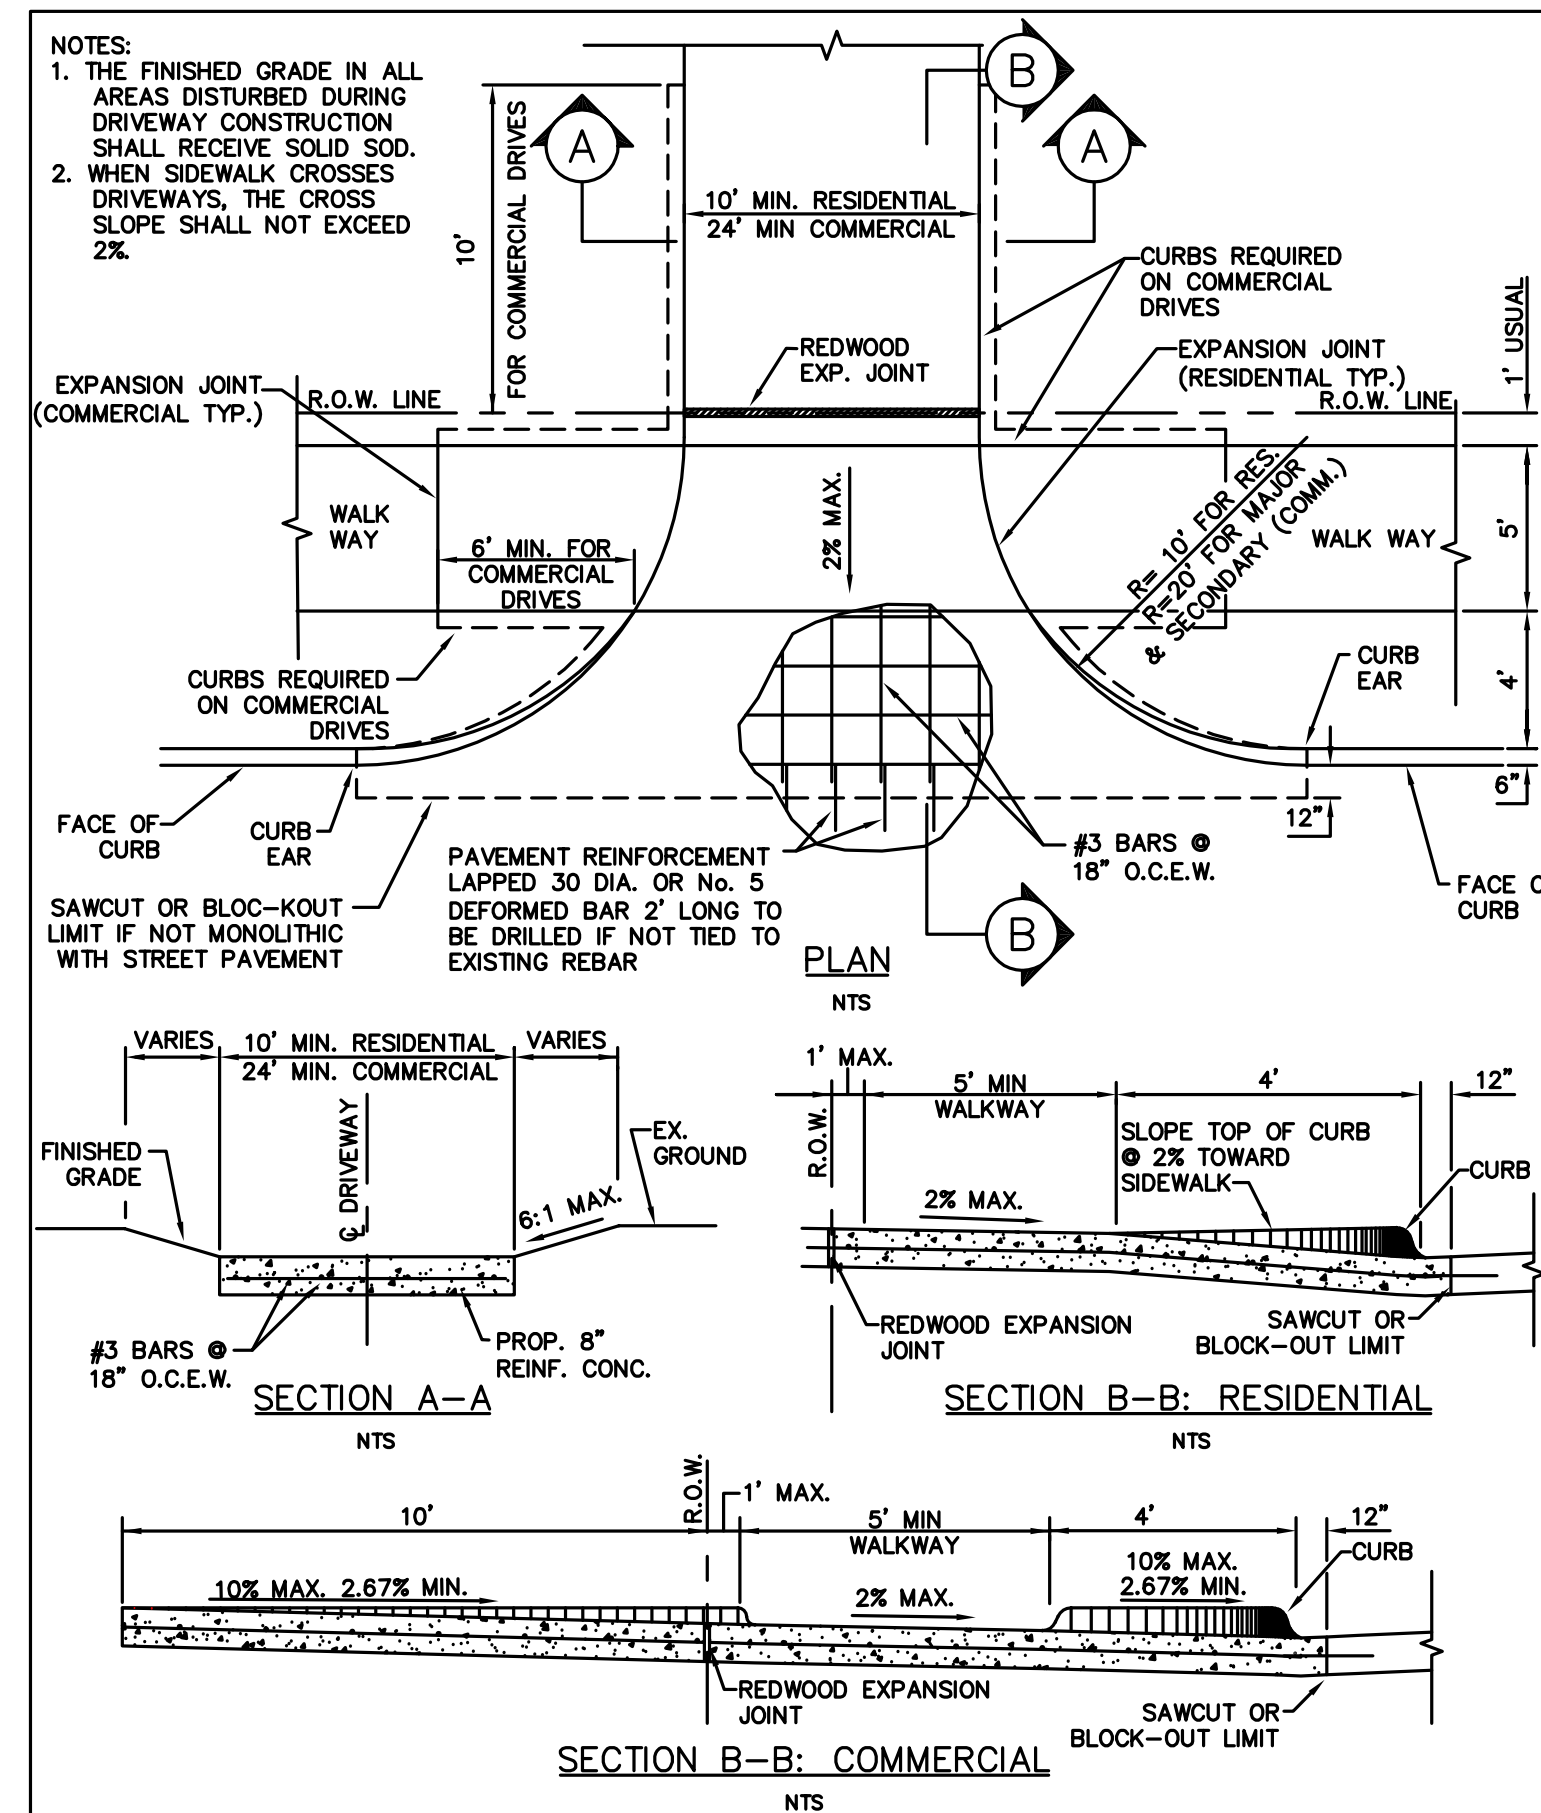

Addison! PUBLIC WORKS DEPARTMENT

AS-BUILT
10/25/2018

THE SEAL APPEARING ON THIS DOCUMENT WAS AUTHORIZED BY VICTOR LISSIAK, JR., P.E. 30565 ON 10/25/2018

STATE OF TEXAS
VICTOR LISSIAK, JR.
30565
REGISTERED PROFESSIONAL ENGINEER

STANDARD DETAILS					
MEHRDAD HANGAR					
ADDISON AIRPORT					
LEASEHOLD ESTATES TRACT II					
1458 ACRES GROUND LEASE #080A-29 ALP#U23					
4700 WESTGROVE DRIVE					
ADDISON, TEXAS					
VIEWTECH INC. TEXAS FIRM REGISTRATION NO. F2658					
4205 BELTWAY DR. ADDISON, TX. 75001 (972) 661-8187 FAX (972) 661-8172					
DESIGN	DRAWN	DATE	SCALE	JOB #	SHEET
AW	AW	10/24/16		2015-224	C14