


5-33-85

CITIES OF ADDISON & CARROLLTON DALLAS & COLLIN COUNTIES, TEXAS

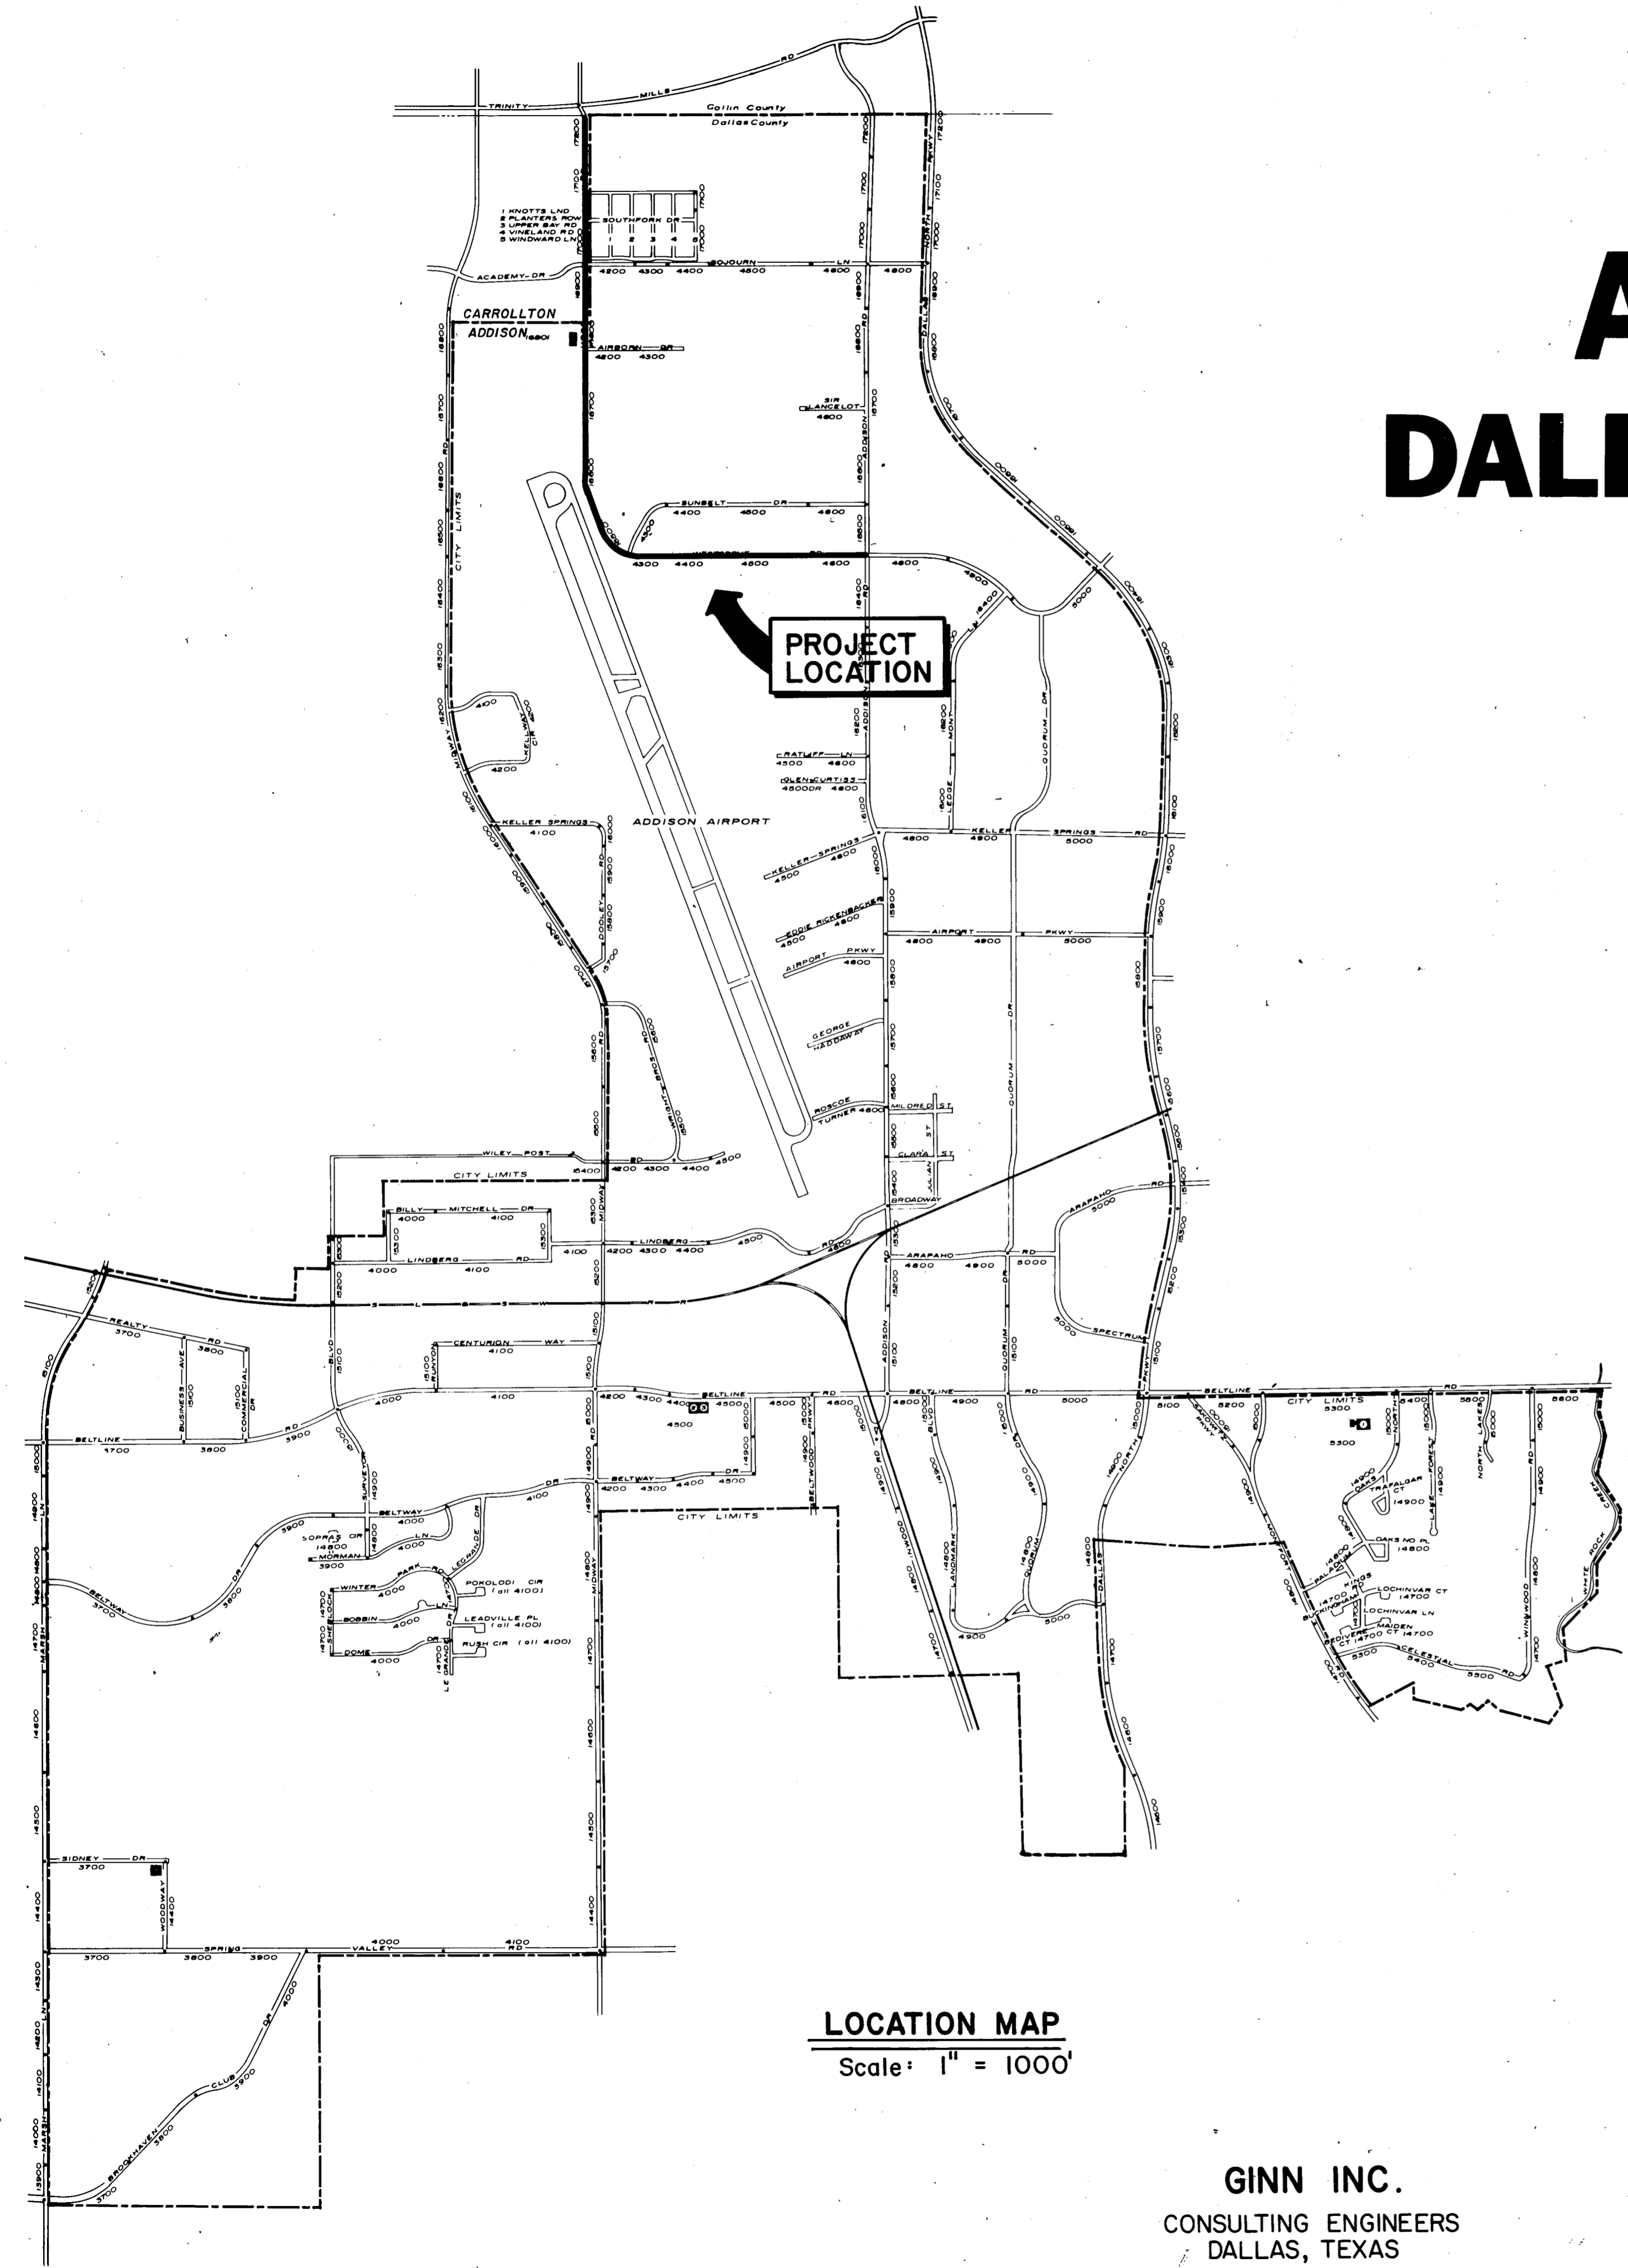

LOCATION MAP
Scale: 1" = 1000'

GINN INC.
CONSULTING ENGINEERS
DALLAS, TEXAS

CONSTRUCTION PLANS FOR :

WESTGROVE RD.-VOSS RD.
PAVING AND DRAINAGE IMPROVEMENTS
PROJECT LENGTH: ± 6591'

1982

CITY OF CARROLLTON

LEDDIE TAYLOR - MAYOR
COUNCIL MEMBERS:
CAROLYN STANDRIDGE
DAVE GILMORE
PAT ARNOLD
KENNY MARCHANT
MILBURN GRAVLEY
JOE KING
DICK ERICKSON
CLONIS LUAllen - CITY MANAGER
JIM JENNE - DIRECTOR of
COMMUNITY DEVELOPMENT

CITY OF ADDISON

JERRY J. REDDING - MAYOR
COUNCIL MEMBERS:
JOHN B. ALLEN
RICHARD RODER
WILLIAM F. SELLMAYER
BARRY FINKELSTEIN
STEWART BEATTY
RONALD N. WHITEHEAD - CITY MANAGER
GEORGE DOWLING, P.E. - DIRECTOR of
COMMUNITY DEVELOPMENT

CITY OF CARROLLTON

Approved By: *[Signature]*

Date: 9-30-82

CITY OF ADDISON

Approved By: *[Signature]*

Date: 9-30-82

WESTGROVE RECORD SET

53-9