

☉ CURVE DATA
 $\Delta = 20^\circ 42' 30''$
 $R = 425.00'$
 $T = 77.65'$
 $L = 153.61'$

ADDISON AIRPORT


VOSS ROAD

SUNBELT DEVELOPMENT CO.

BAIRD PROPERTIES, INC.

B.M.#7 - Top F.H. 28.5' Rt. Sta. 34+91.50
 ELEV. 649.13

NOTE: All Driveway Radii are 10' unless otherwise noted

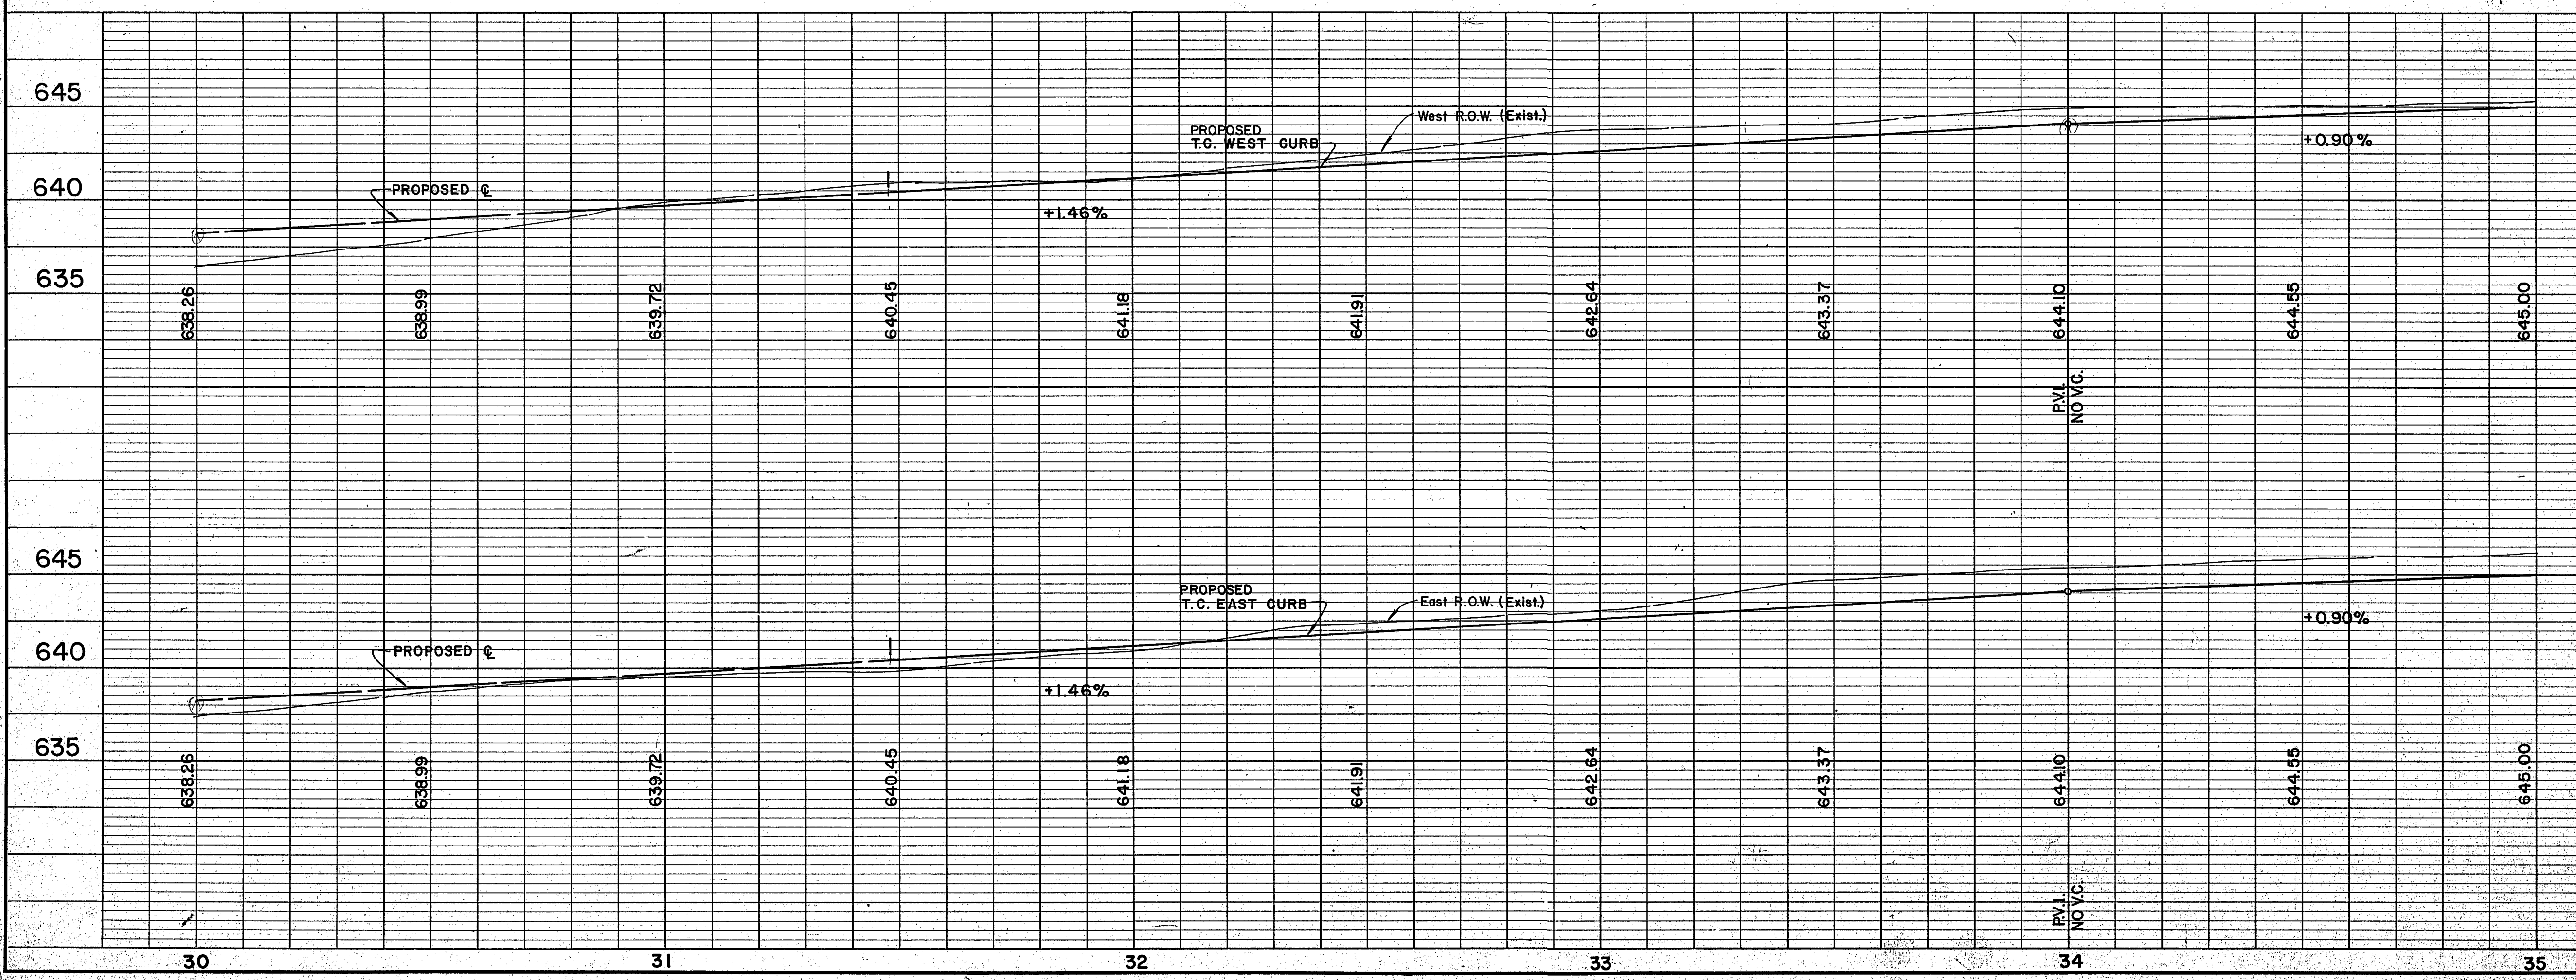

Record Set 5/9/85

NO.	REVISION	BY	DATE
CITY OF ADDISON DALLAS COUNTY, TEXAS			
WESTGROVE/VOSS ROAD IMPROVEMENTS			
PAVING Sta. 30+00 to 35+00			
GINN, INC. Consulting Engineers - Dallas, Texas			
DESIGNED-HJ	DRAWN-RGB/LA	DATE-SEPT., 1982	FILE J-192
APPROVED-HWG	CHECKED-HBJ	SCALE-H-1"=20'/V-1"=5'	SHEET 10 OF 10