



ADDISON AIRPORT

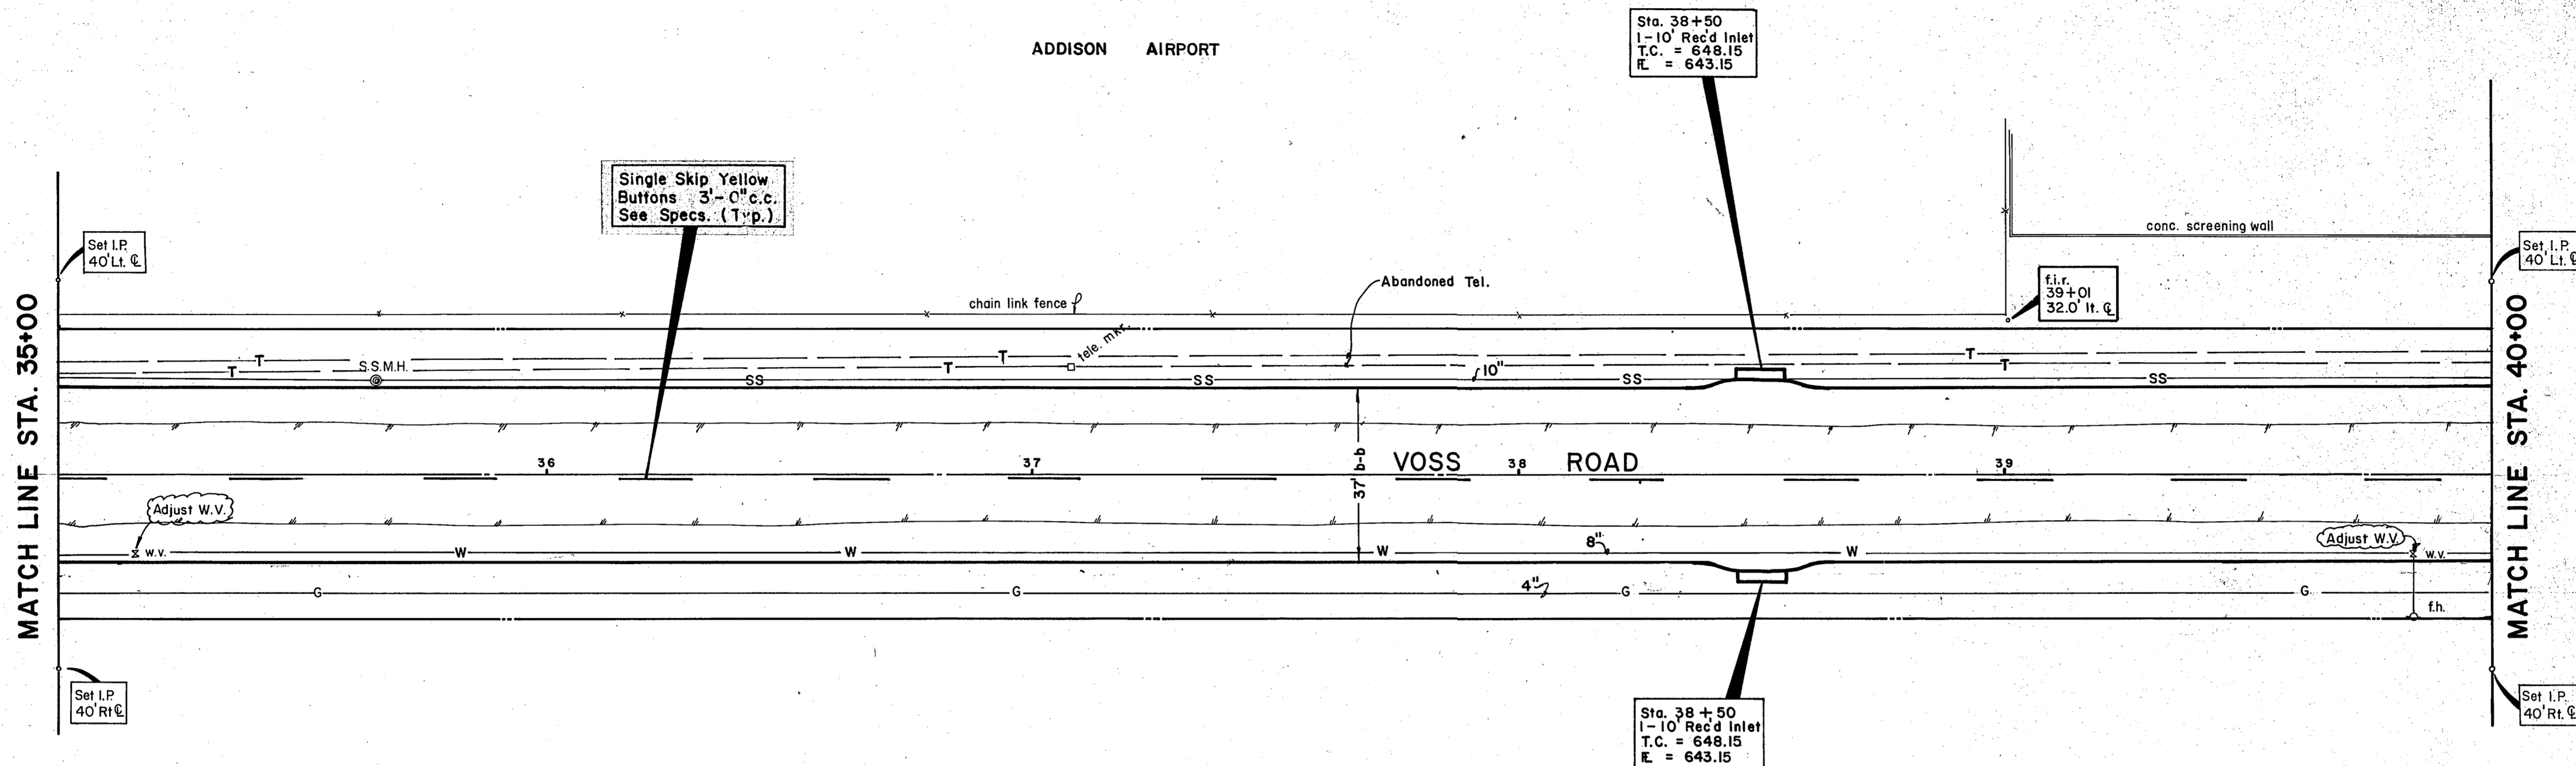

BAIRD PROPERTIES, INC.

B.M. # 7 - Top F.H. 28.5 Rt. Sta. 34+91.5  
ELEV. 649.13

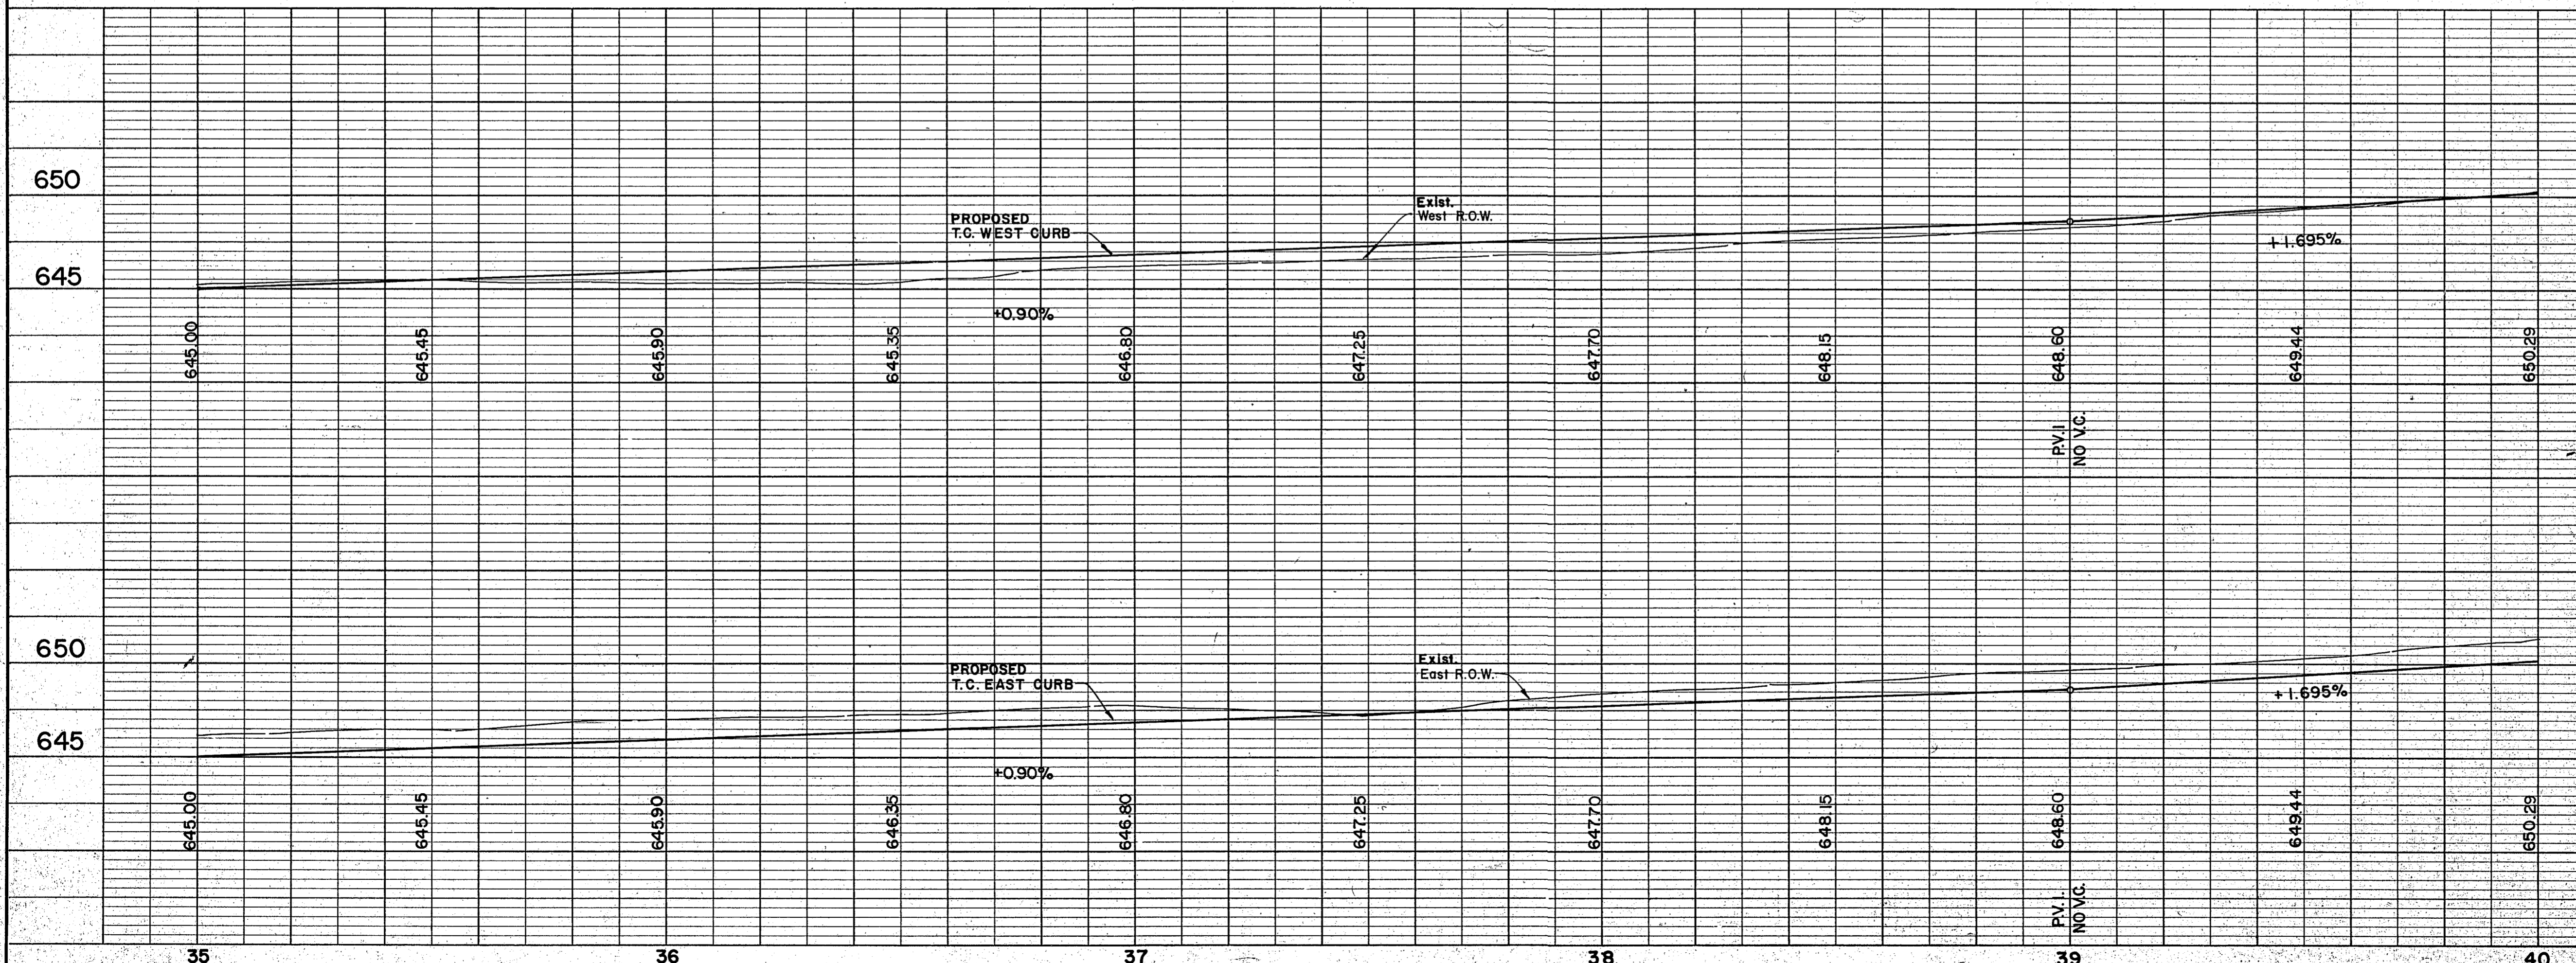

Record Set 5/9/85

NO.	REVISION	BY	DATE
CITY OF ADDISON DALLAS COUNTY, TEXAS			
<b>WESTGROVE/VOSS ROAD IMPROVEMENTS</b>			
PAVING Sta. 35+00 to 40+00			
GINN, INC. Consulting Engineers Dallas, Texas			
DESIGNED-HJ	DRAWN-RB/LA	DATE-SEPT., 1982	FILE J-192
APPROVED-HWG	CHECKED-HBJ	SCALE-H-1"=20'/V-1"=5'	SHEET 11 OF