


NOTE: All Driveway Radii are 10' unless otherwise noted

B.M.#8 - "□" cut on T.C. No. side of Drive
50' Lt. Sta. 42+55
ELEV. 654.92

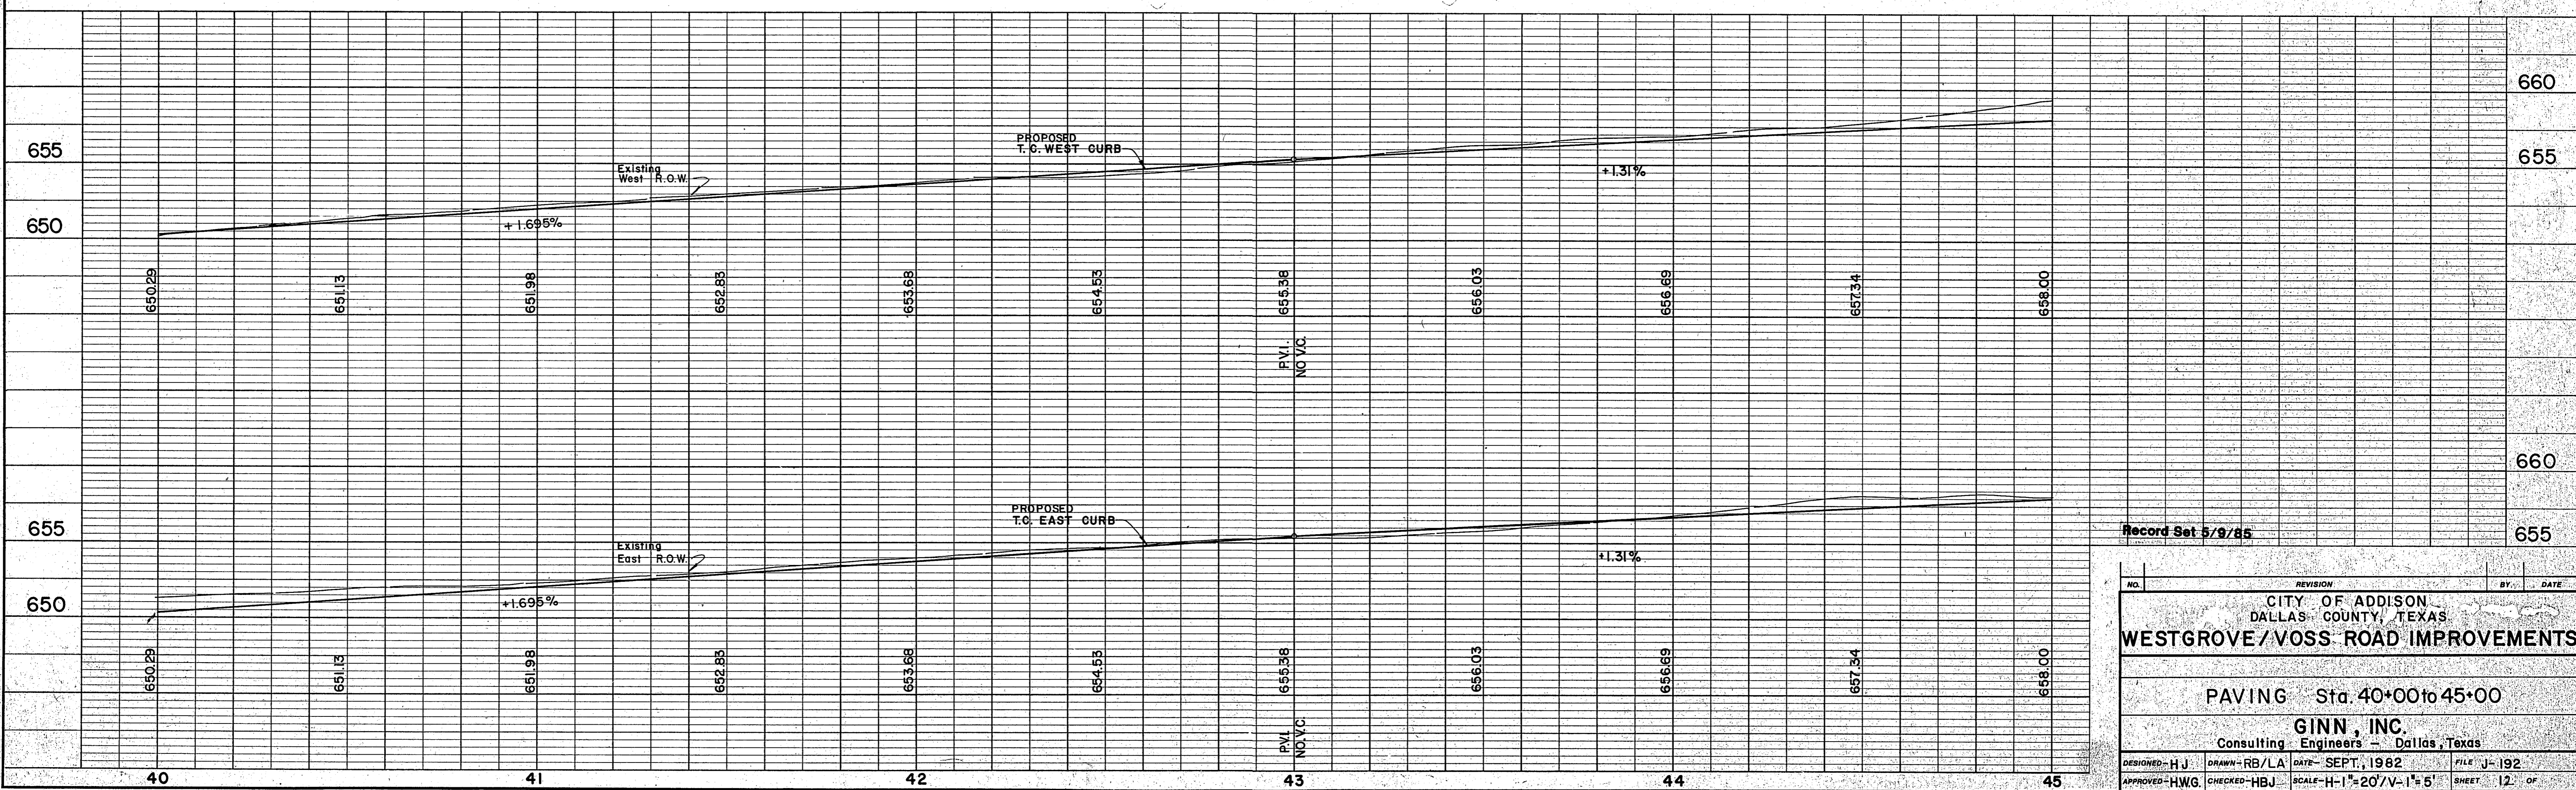

Record Set 5/9/85

NO.	REVISION	BY	DATE
CITY OF ADDISON DALLAS COUNTY, TEXAS WESTGROVE/VOSS ROAD IMPROVEMENTS			
PAVING Sta. 40+00 to 45+00			
GINN, INC. Consulting Engineers - Dallas, Texas			
DESIGNED - HJ	DRAWN - RB/LA	DATE - SEPT, 1982	FILE - J-192
APPROVED - HWG	CHECKED - HB	SCALE - H-1"=20' V-1"=5'	SHEET 12 OF 12