

☉ DATA
 ACADEMY DR.
 Δ = 45°00'00"
 R = 235.00'
 T = 97.34'
 L = 184.57'


Single Skip Yellow
 Buttons 3'-0" c.c.
 See Specs. (Typ.)

STA. 54+35
 1-10' Rec'd Inlet
 T.C. = 660.08
 E. = 659.08
 INV. = 656.08

STA. 54+35
 1-10' Rec'd Inlet
 T.C. = 660.08
 E. = 659.08
 INV. = 656.08

NOTE: All Driveway Radii are 10' unless otherwise noted

B.M.#9 - "□" cut on T.C. No. side Sojourn Ln.
 55' Rt. Sta. 51+25
 ELEV. 660.49

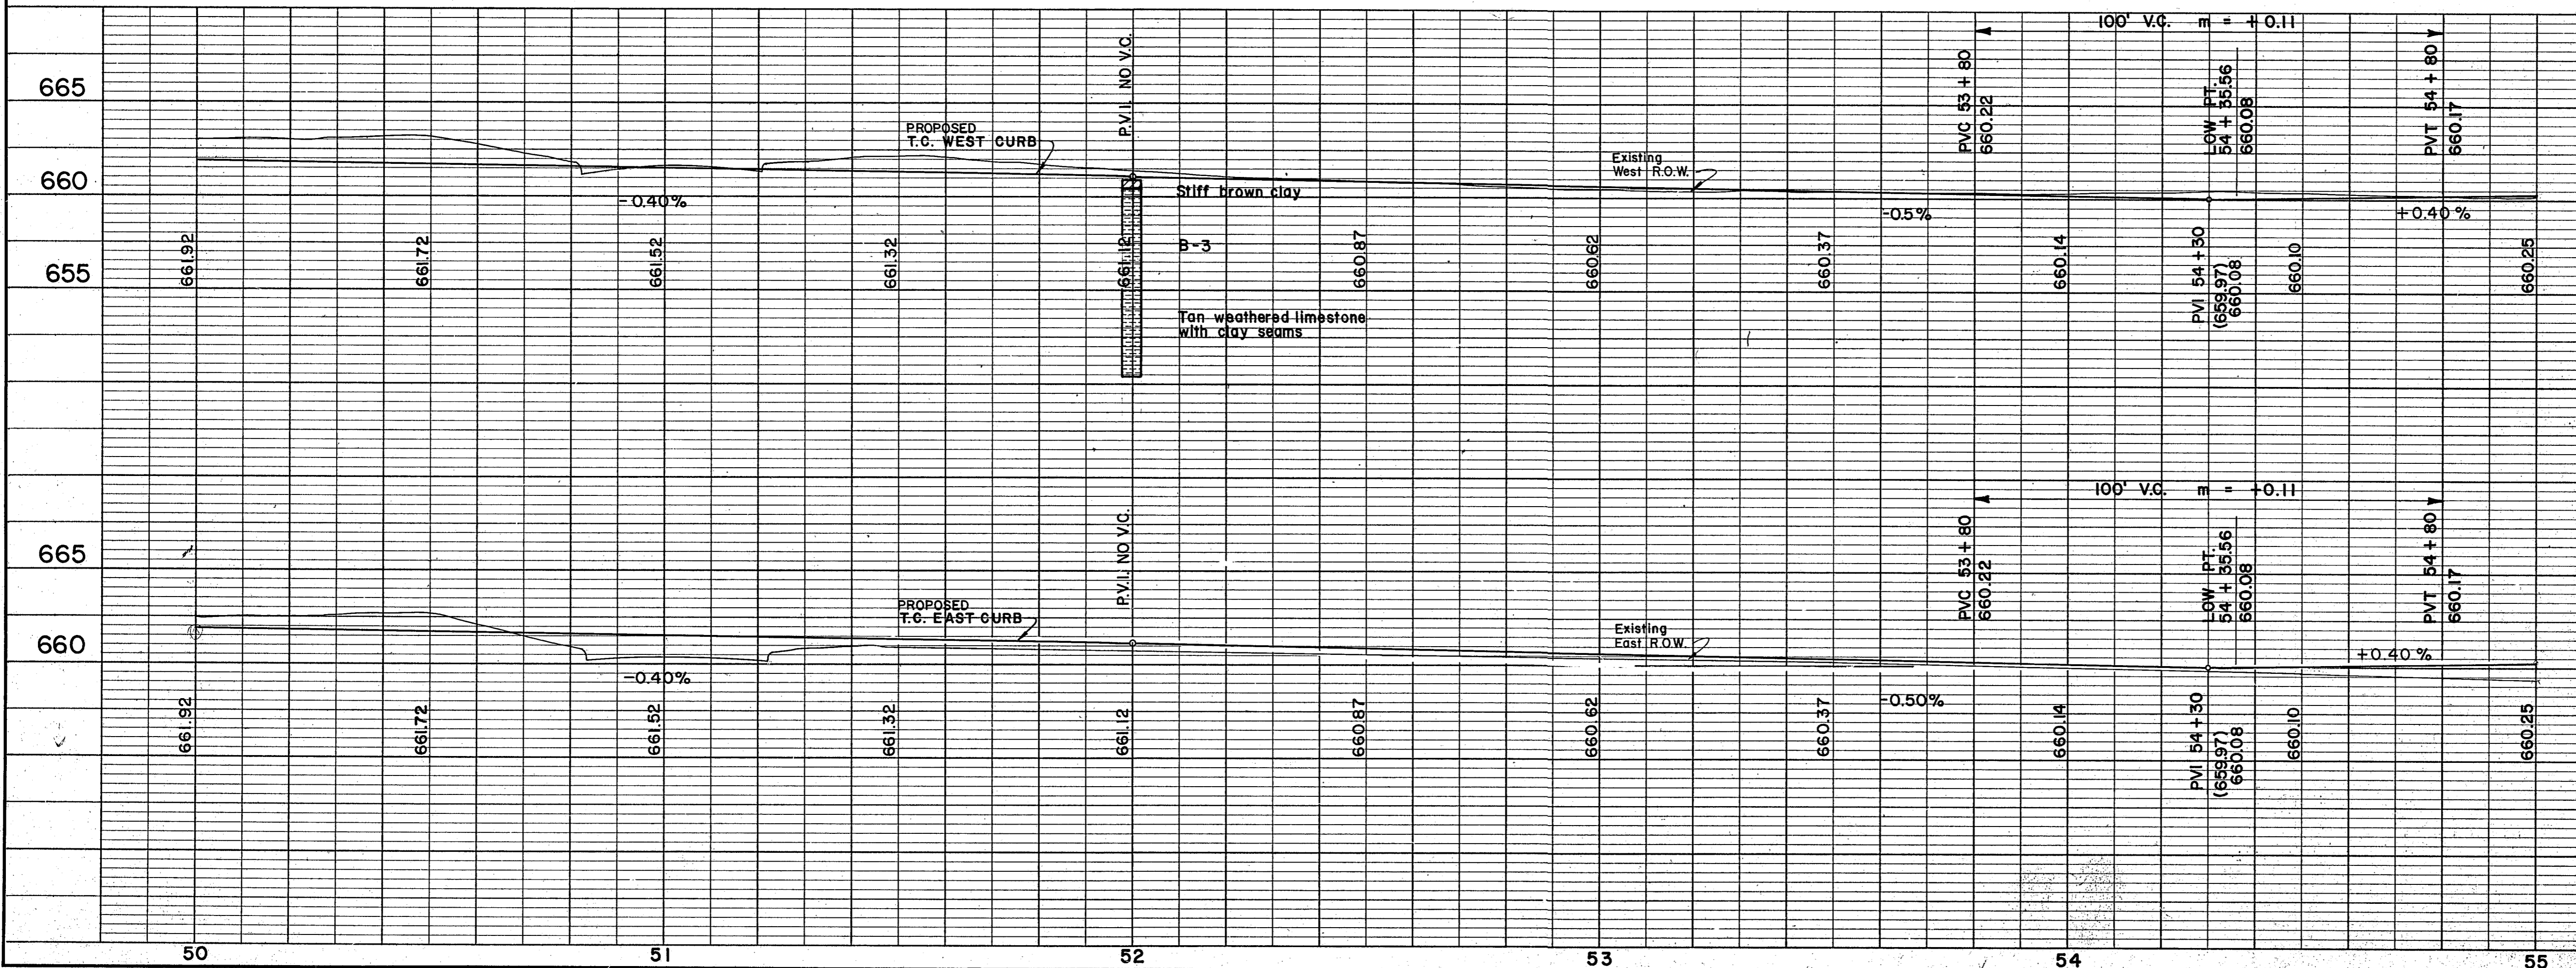

Record Set 5/9/85

NO.	REVISION	BY	DATE
CITY OF ADDISON DALLAS COUNTY, TEXAS			
WESTGROVE/VOSS ROAD IMPROVEMENTS			
PAVING Sta. 50+00 to 55+00			
GINN, INC. Consulting Engineers - Dallas, Texas			
DESIGNED-H.J.	DRAWN-RB/LA	DATE- SEPT., 1982	FILE J-192
APPROVED-HWG	CHECKED-HBJ	SCALE- H-1"=20'/V-1"=5'	SHEET 14 OF