



MATCH LINE STA. 60+00

MATCH LINE STA. 65+00

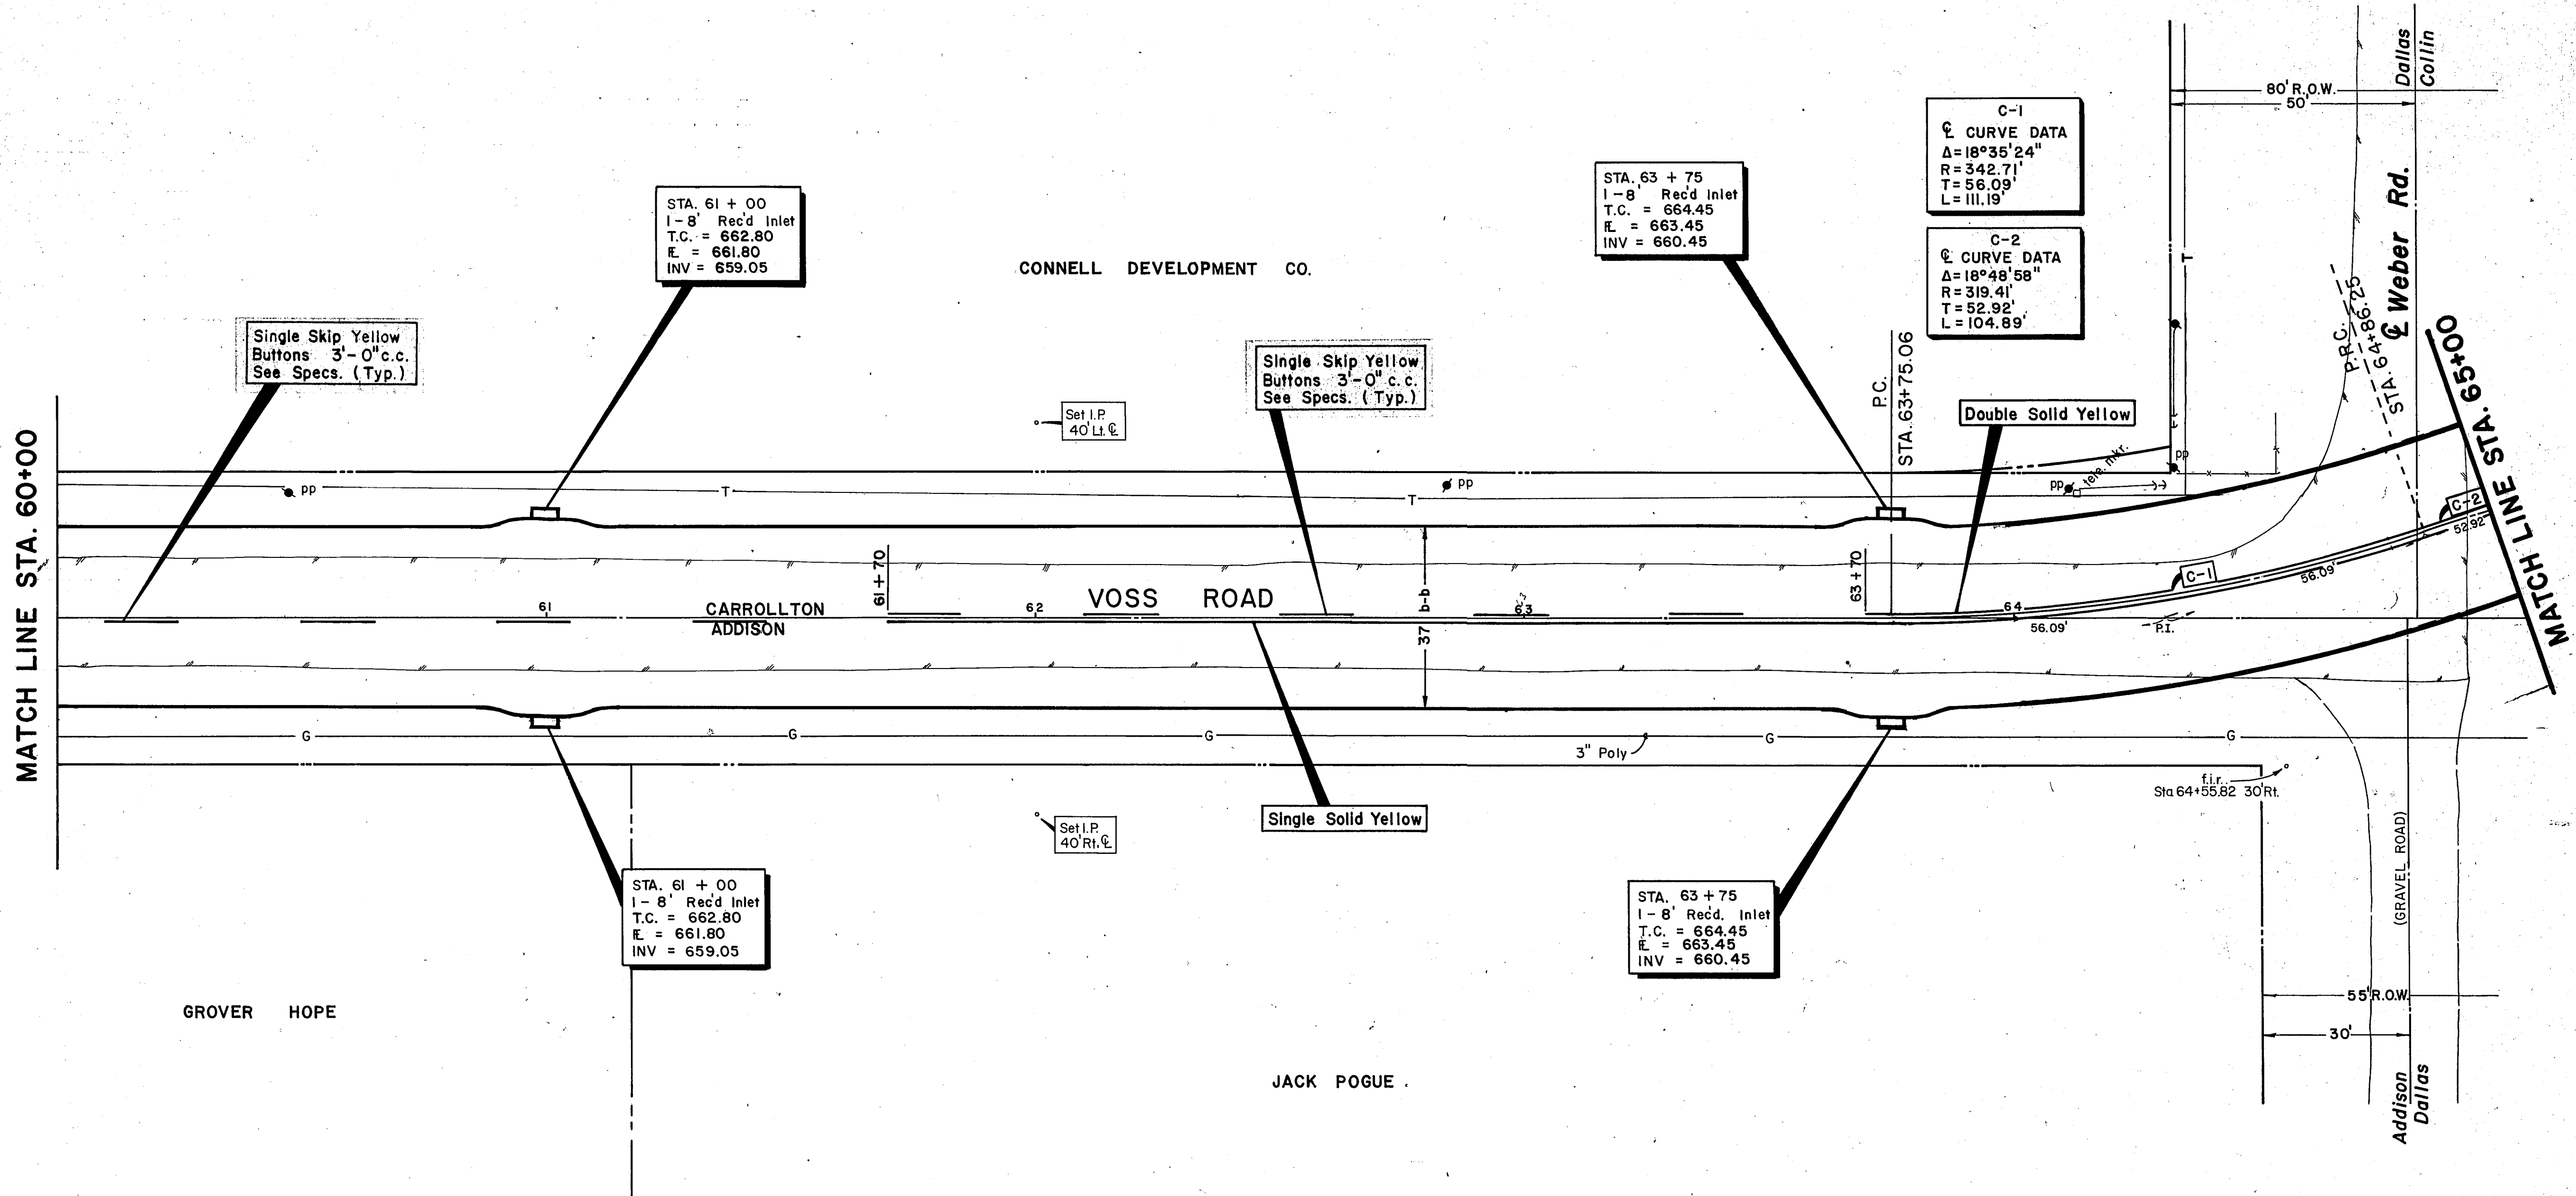

B.M. #9 - "□" cut on T.C. No. side Sojourn Ln.
55' Rt. Sta. 51+25
ELEV. 660.49

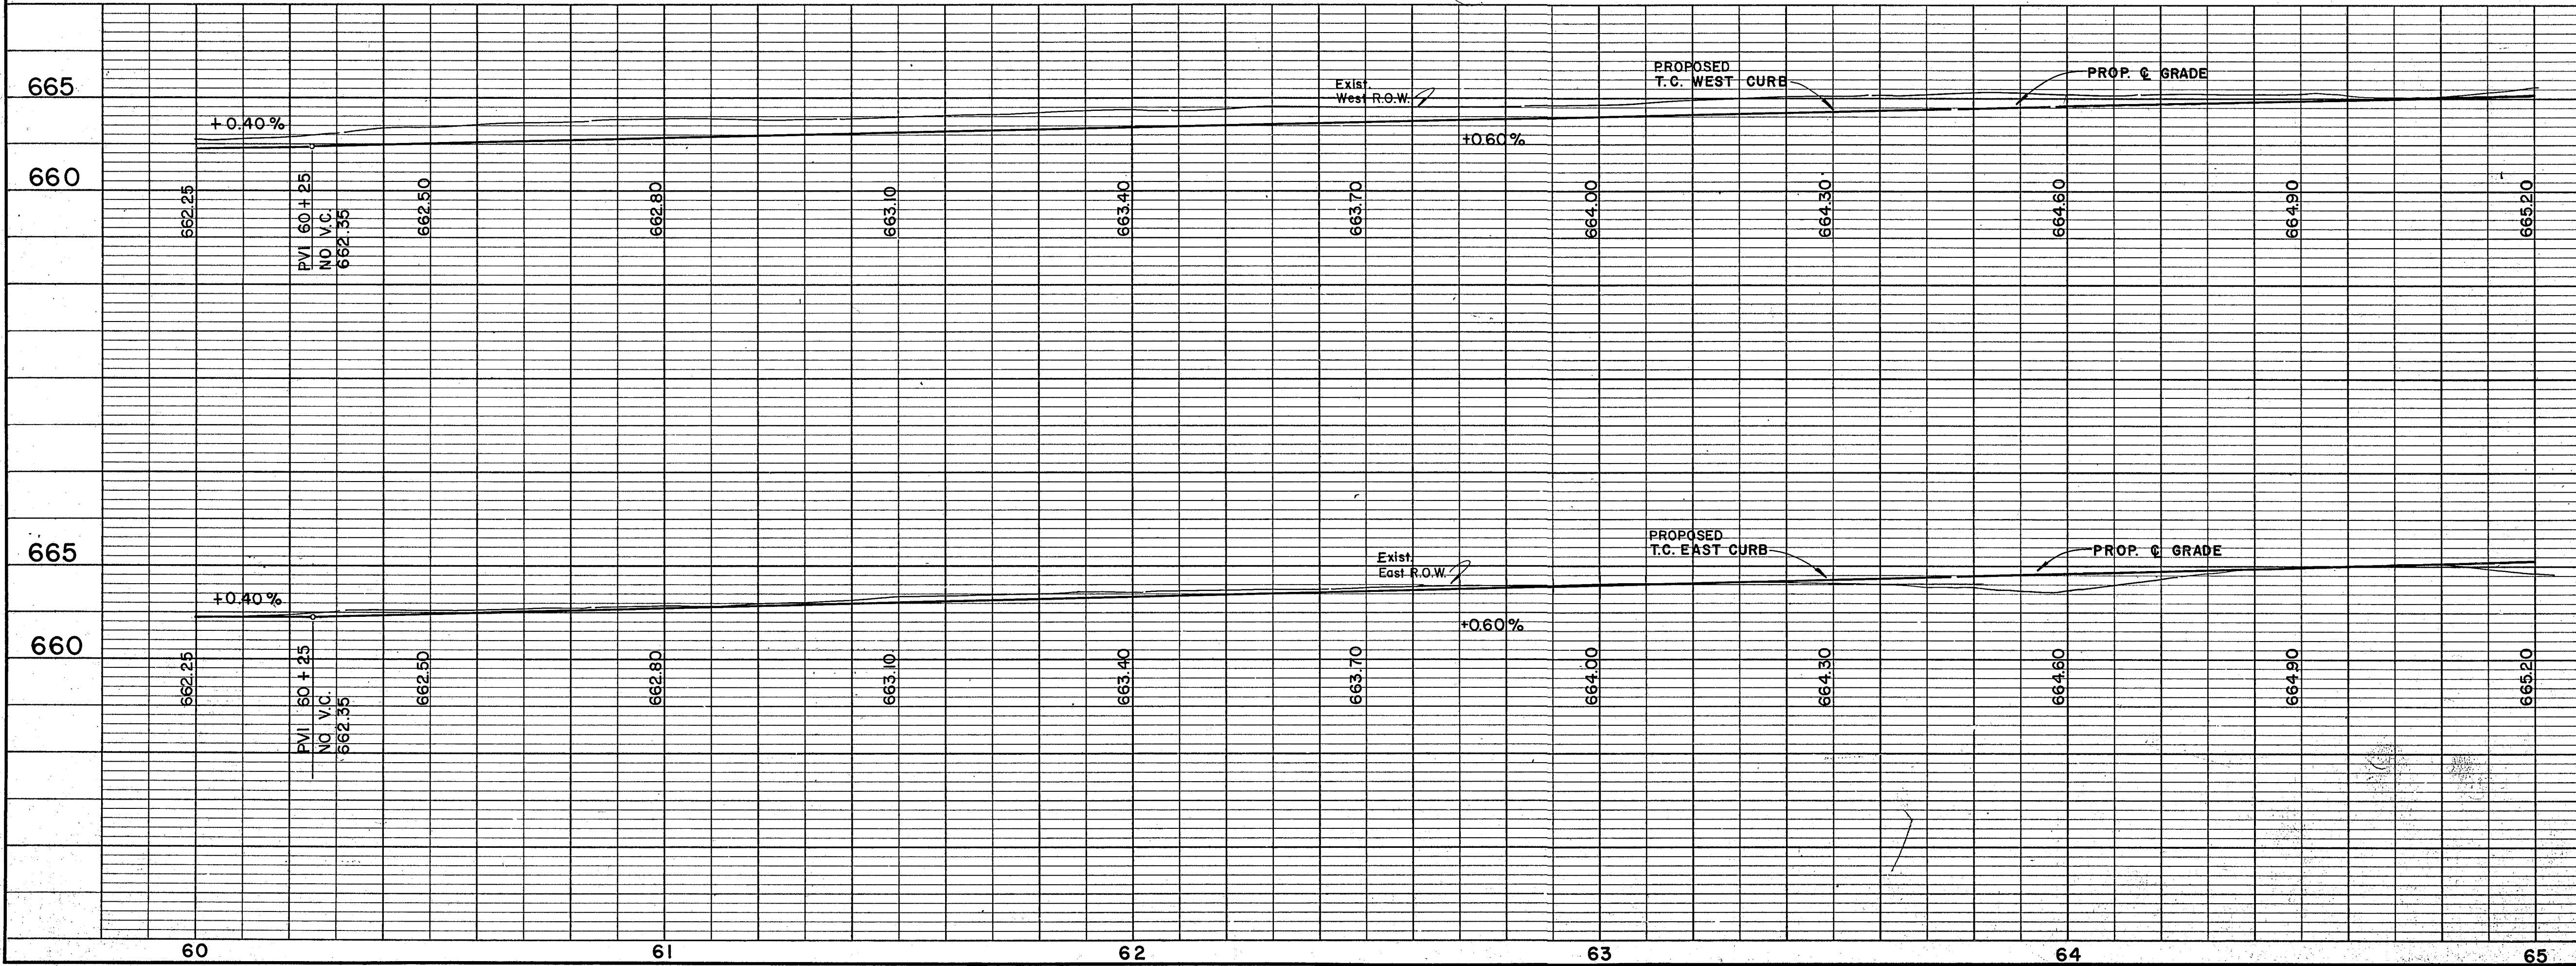

Record Set 5/9/85

| NO. | REVISION | BY | DATE |
|----------------------------------------------------|-------------|------------------------|----------------|
| CITY OF ADDISON DALLAS COUNTY, TEXAS | | | |
| WESTGROVE / VOSS ROAD IMPROVEMENTS | | | |
| PAVING Sta. 60+00 to 65+00 | | | |
| GINN, INC. Consulting Engineers - Dallas, Texas | | | |
| DESIGNED-HJ | DRAWN-RB/LA | DATE- SEPT., 1982 | FILE J-192 |
| APPROVED-HWG | CHECKED-HBJ | SCALE-H-1"=20'/V-1"=5' | SHEET 16 OF 16 |