
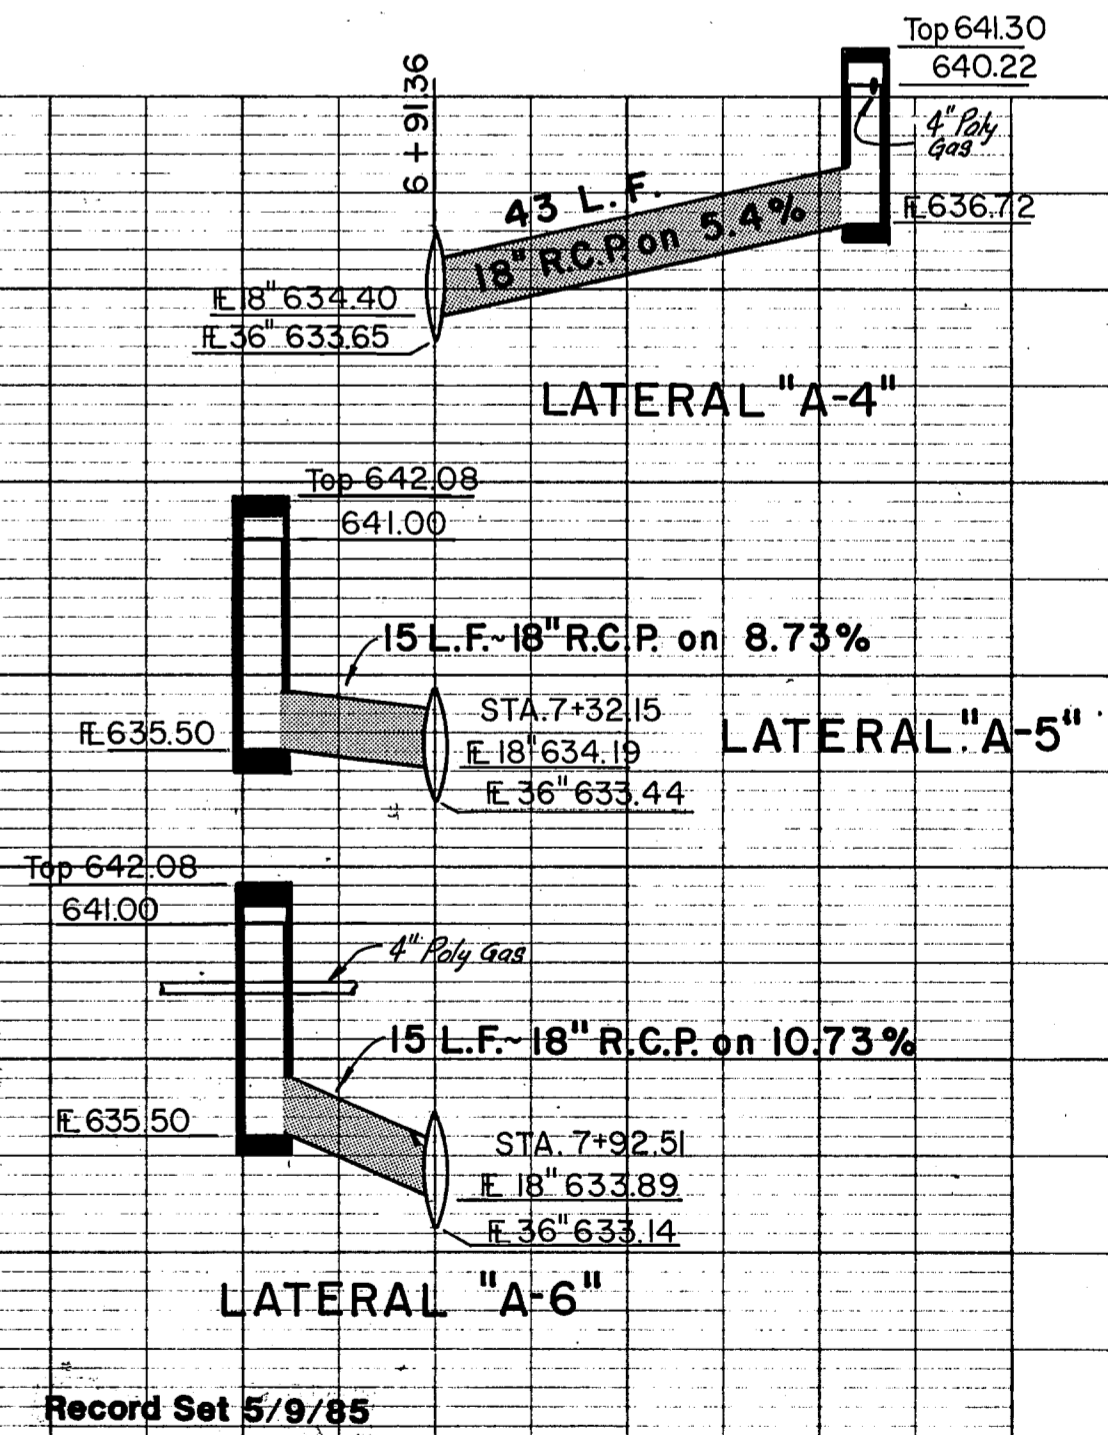


B.M. #2 - "I" cut on first step East corner 4559 Westgrove, Sta. 5+50± ELEV. 644.46

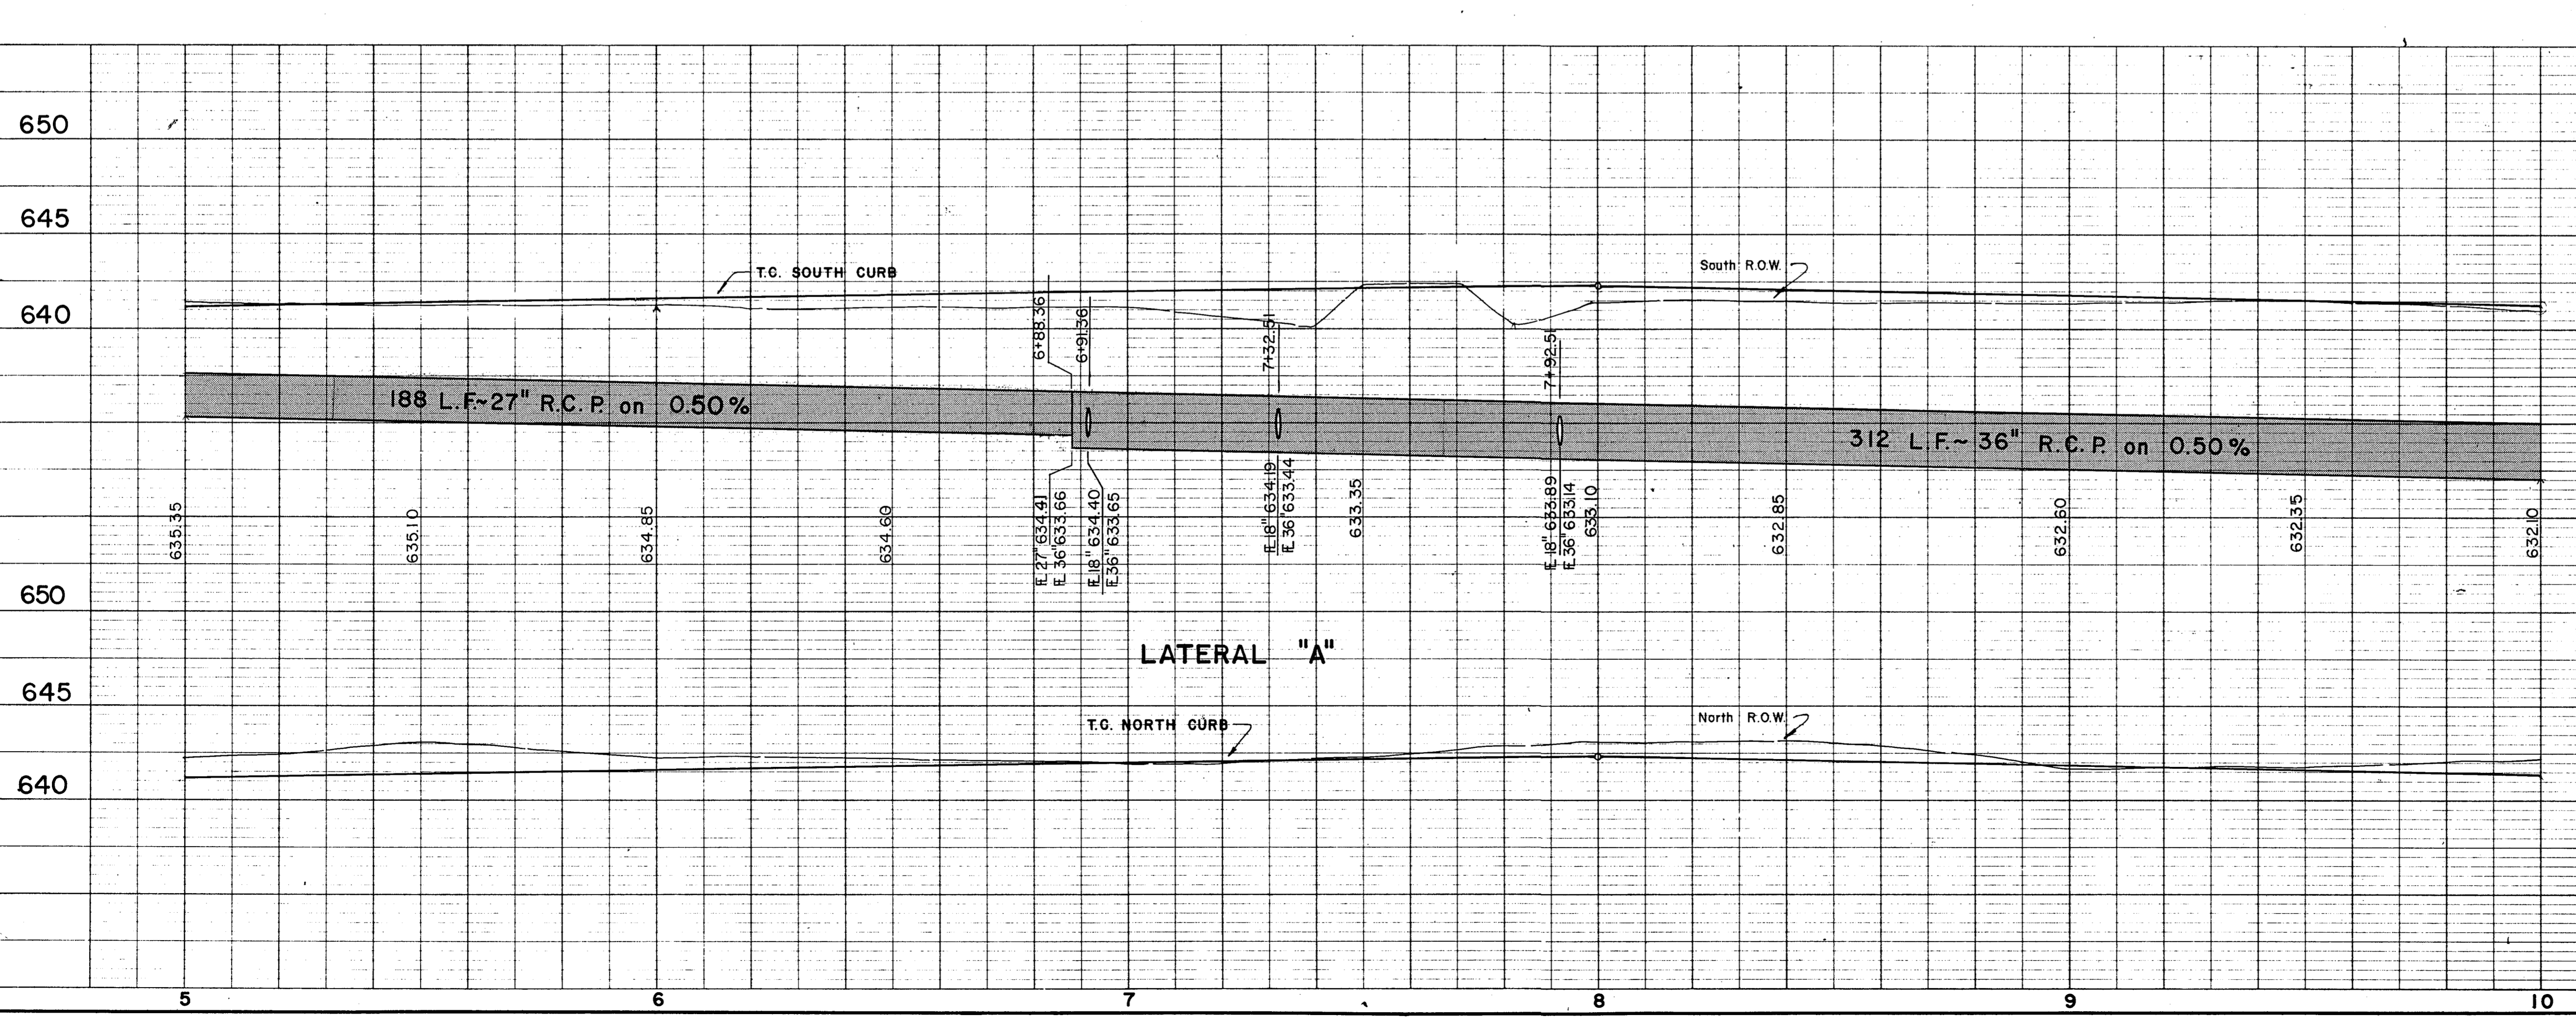

NO.	REVISION	BY	DATE
CITY OF ADDISON DALLAS COUNTY, TEXAS			
WESTGROVE/VOSS ROAD IMPROVEMENTS			
DRAINAGE - STA. 5+00 to STA. 10+00			
GINN, INC. Consulting Engineers - Dallas, Texas			
DESIGNED - GF	DRAWN - R.G.B.	DATE SEPT., 1982	FILE J-192
APPROVED - H.W.G.	CHECKED - H.B.J.	SCALE - H-1"=20'/V-1"=5'	SHEET 22 OF