



SCALE 3/8" = 1'

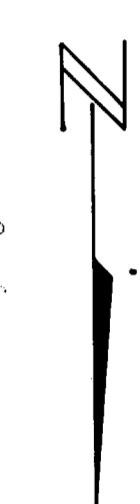

B.M.#4 - 4" x 4" cut on T.C. 41' Rt Sta. 17+00  
ELEV. 632.89

NOTE: All Driveway Radii are 10' unless otherwise noted

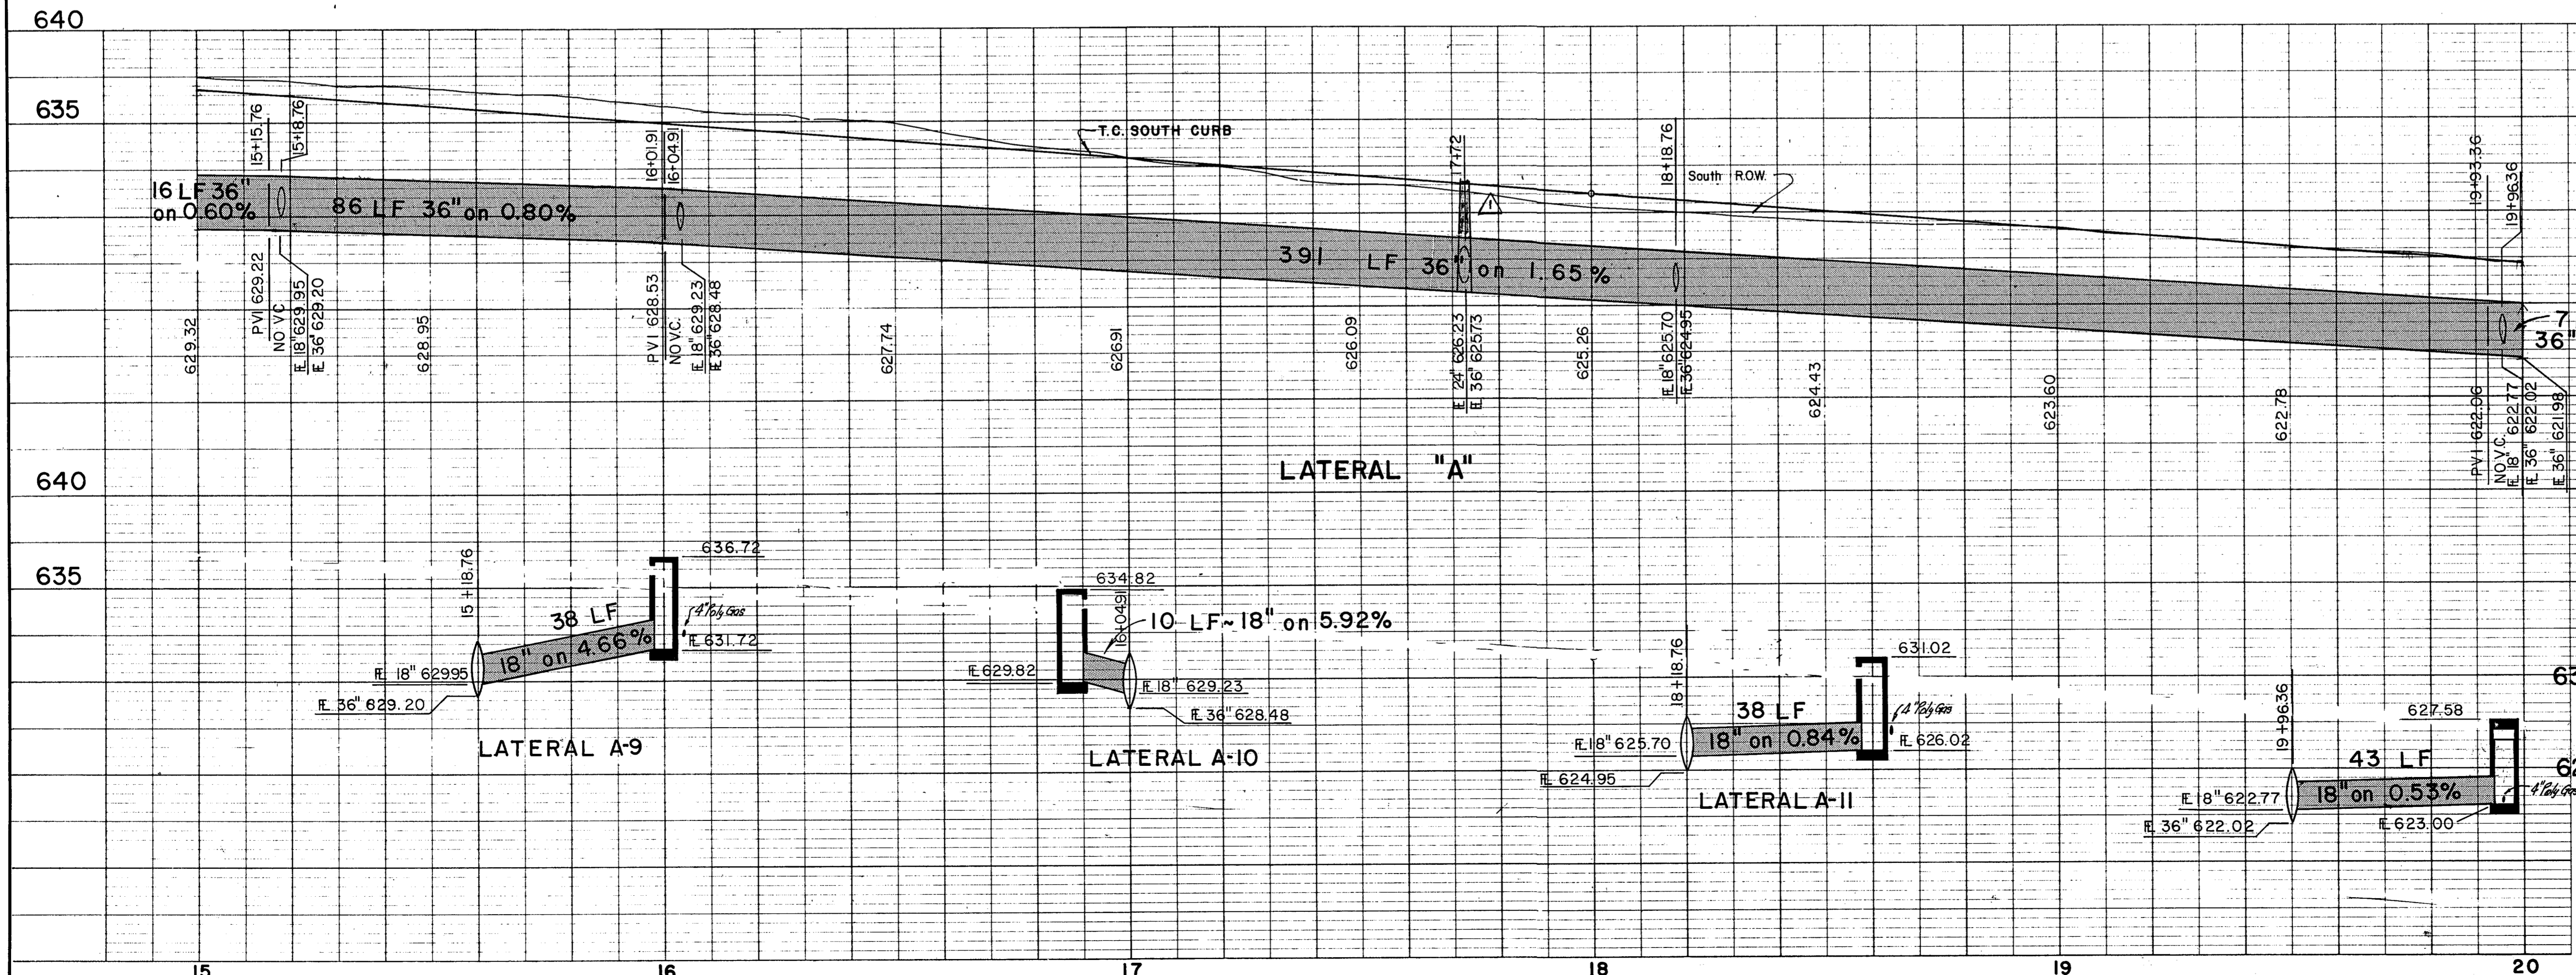

Record Set 5/9/85

Added 4" Diam. Manhole

DESIGNED - GF DRAWN - RGB DATE - SEPT., 1982 FILE J-192  
 APPROVED - HWG CHECKED - HBJ SCALE - H-1"=20'/V-1"=5' SHEET 24 OF

CITY OF ADDISON  
 DALLAS COUNTY, TEXAS

**WESTGROVE / VOSS ROAD IMPROVEMENTS**

**DRAINAGE - STA. 15+00 to STA. 20+00**

**GINN, INC.**  
 Consulting Engineers - Dallas, Texas

DESIGNED - GF DRAWN - RGB DATE - SEPT., 1982 FILE J-192  
 APPROVED - HWG CHECKED - HBJ SCALE - H-1"=20'/V-1"=5' SHEET 24 OF