


BAIRD PROPERTIES, INC.

B.M. #7- Top F.H. 28.5 Ft. Sta. 34+91.5  
ELEV. 649.13

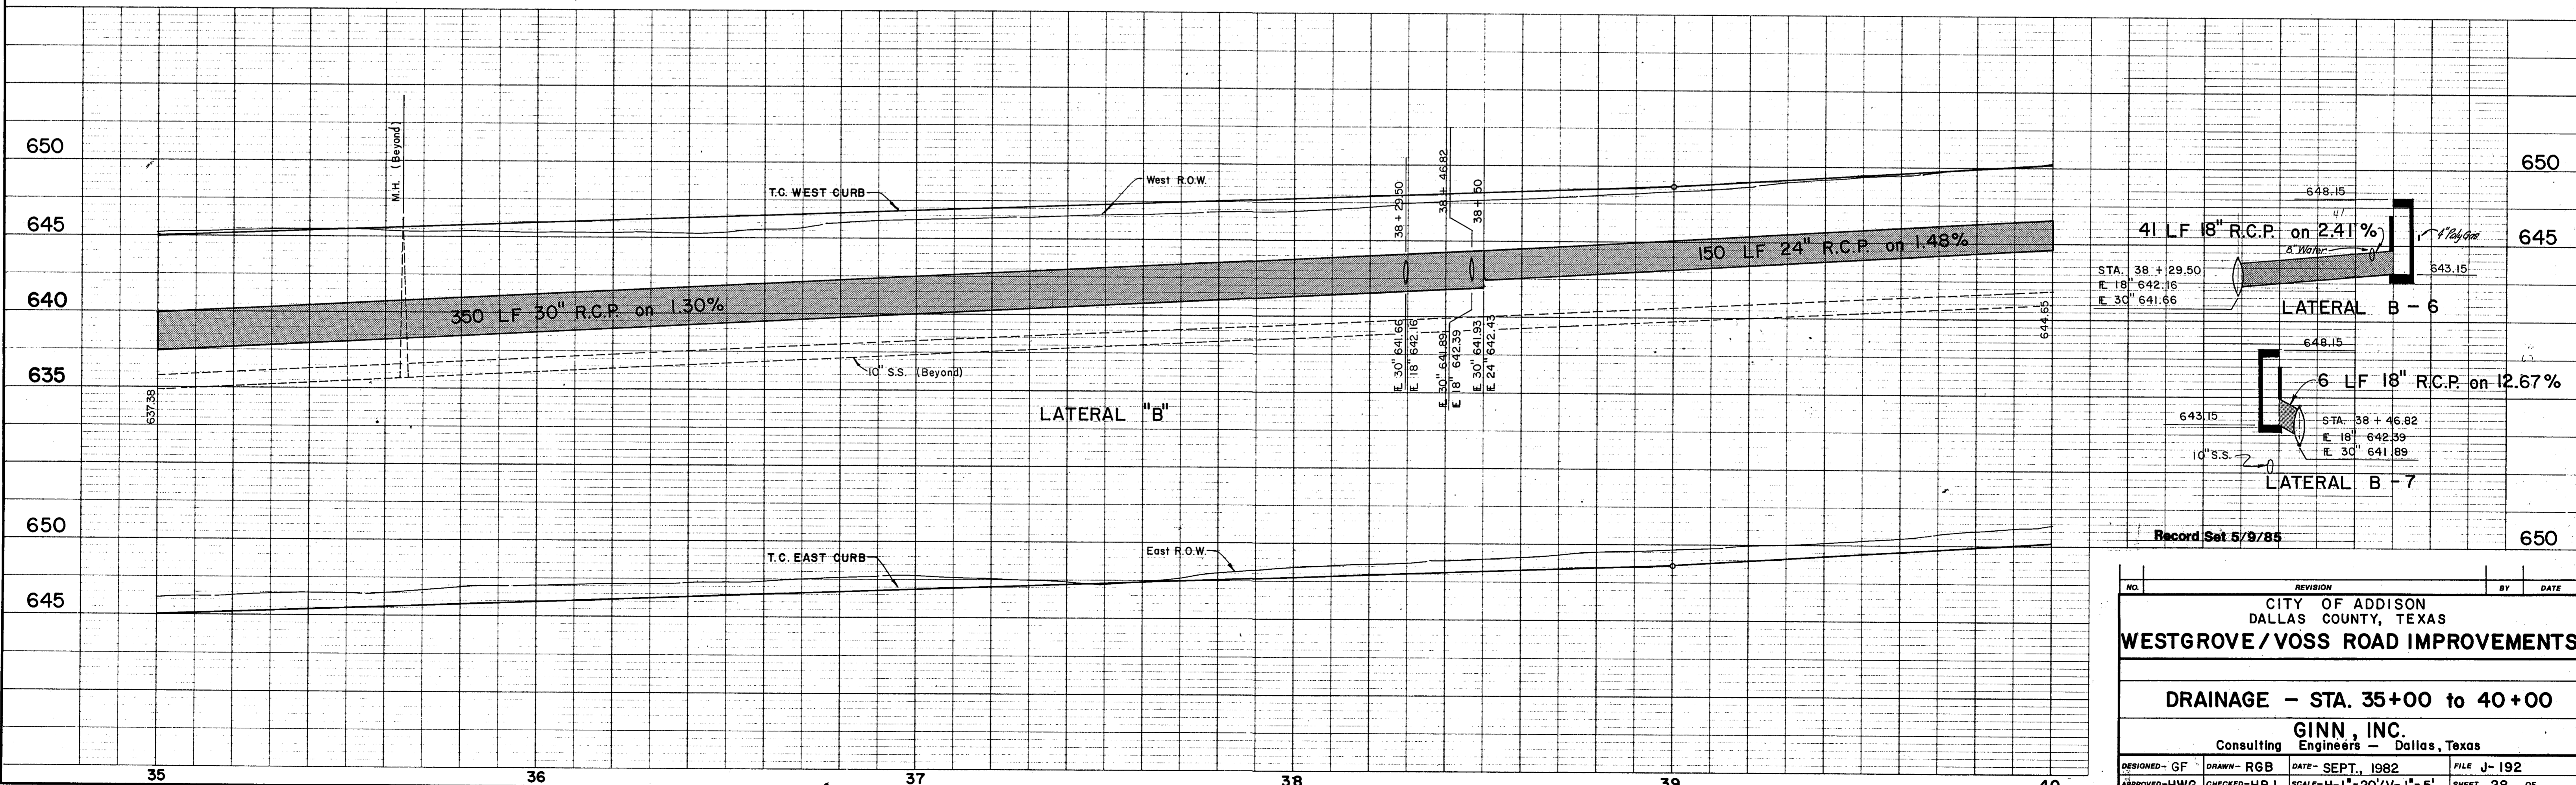

Record Set 5/9/85

NO.	REVISION	BY	DATE
CITY OF ADDISON DALLAS COUNTY, TEXAS			
<b>WESTGROVE / VOSS ROAD IMPROVEMENTS</b>			
<b>DRAINAGE - STA. 35+00 to 40+00</b>			
<b>GINN, INC.</b> Consulting Engineers - Dallas, Texas			
DESIGNED - GF	DRAWN - RGB	DATE - SEPT., 1982	FILE J-192
APPROVED - HWG	CHECKED - HBJ	SCALE - H-1" = 20'/V-1" = 5'	SHEET 28 OF