
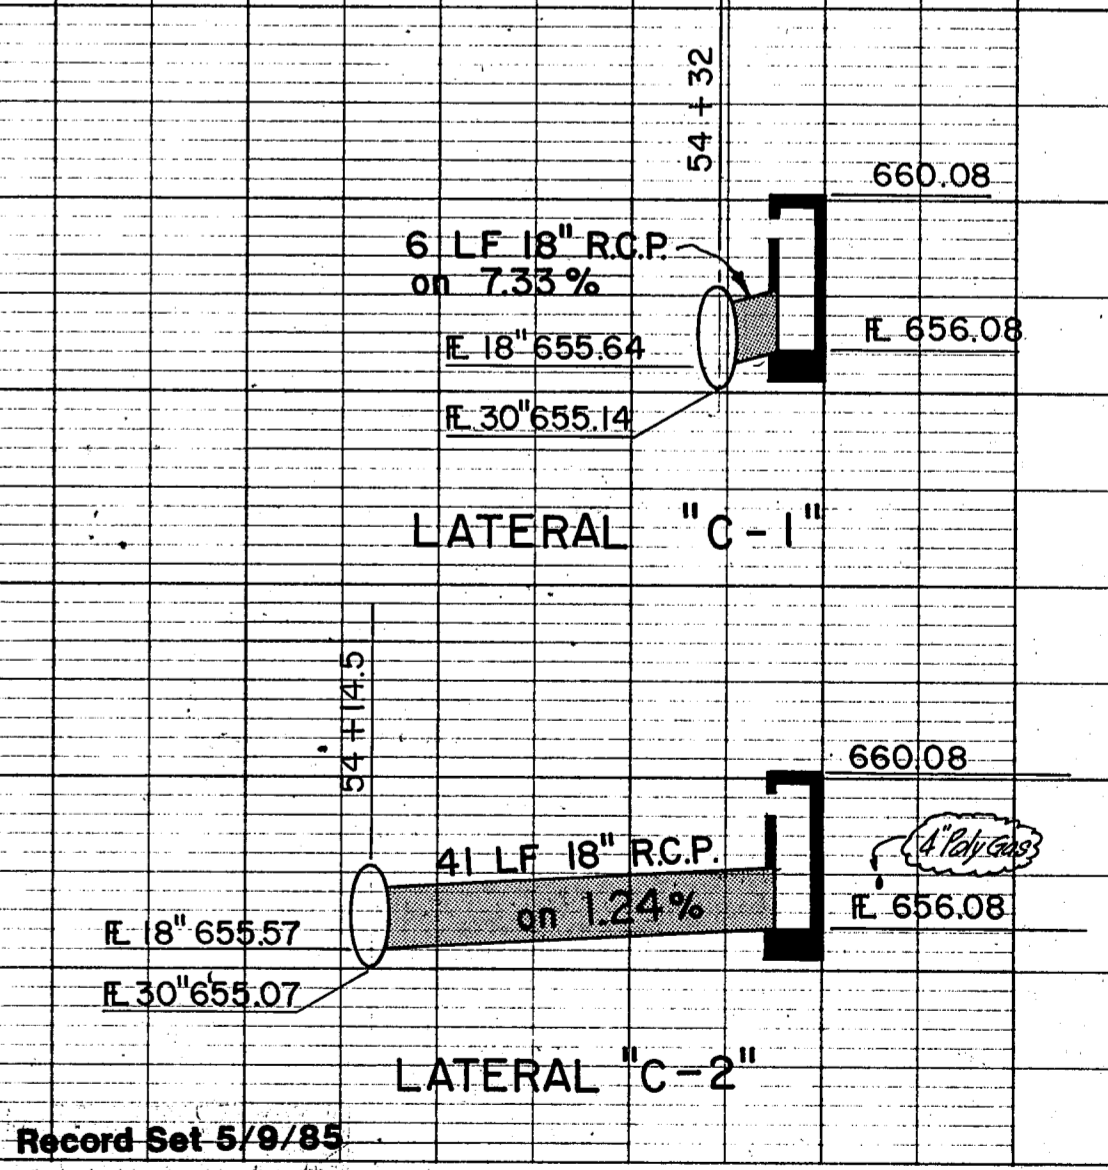


B.M.#9 - "D" cut on T.C. No. side Sojourn Ln.  
55' Rt. Sta. 51+25  
ELEV. 660.49

NOTE: All Driveway Radii are 10' unless otherwise noted

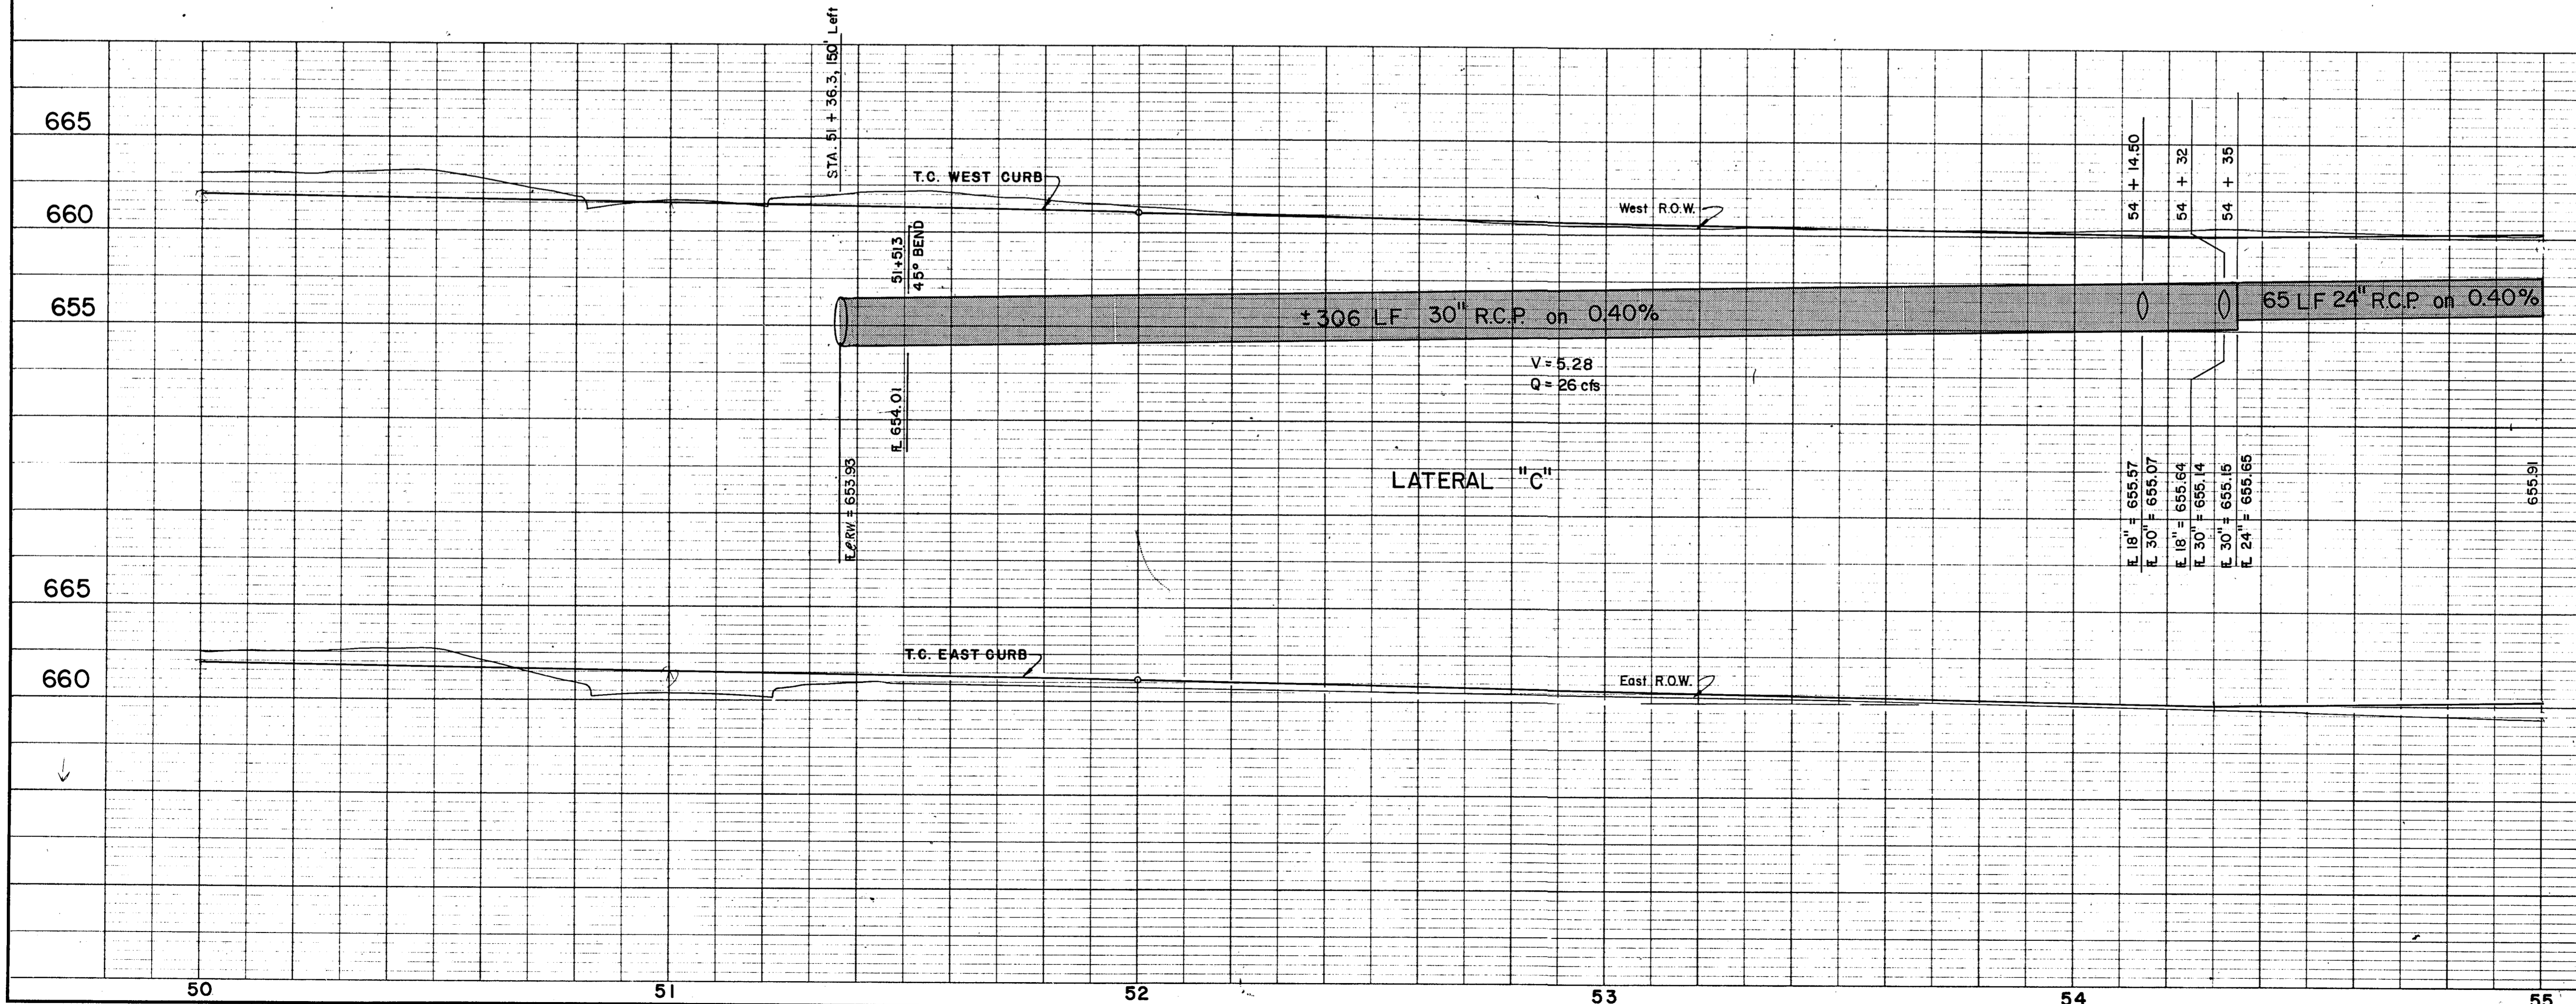

NO.	REVISION	BY	DATE
CITY OF ADDISON DALLAS COUNTY, TEXAS			
<b>WESTGROVE/VOSS ROAD IMPROVEMENTS</b>			
<b>DRAINAGE - STA. 50+00 to 55+00</b>			
<b>GINN, INC.</b> Consulting Engineers - Dallas, Texas			
DESIGNED - GF	DRAWN - R.G.B.	DATE - SEPT., 1982	FILE - J-192
APPROVED - HWG	CHECKED - HBJ	SCALE - H-1"=20'/V-1"=5'	SHEET 31 OF