


B.M. #3 - "□" cut on T.C. 40' Rt. Sta. 10+82
(4411 Westgrove)
ELEV. 641.74

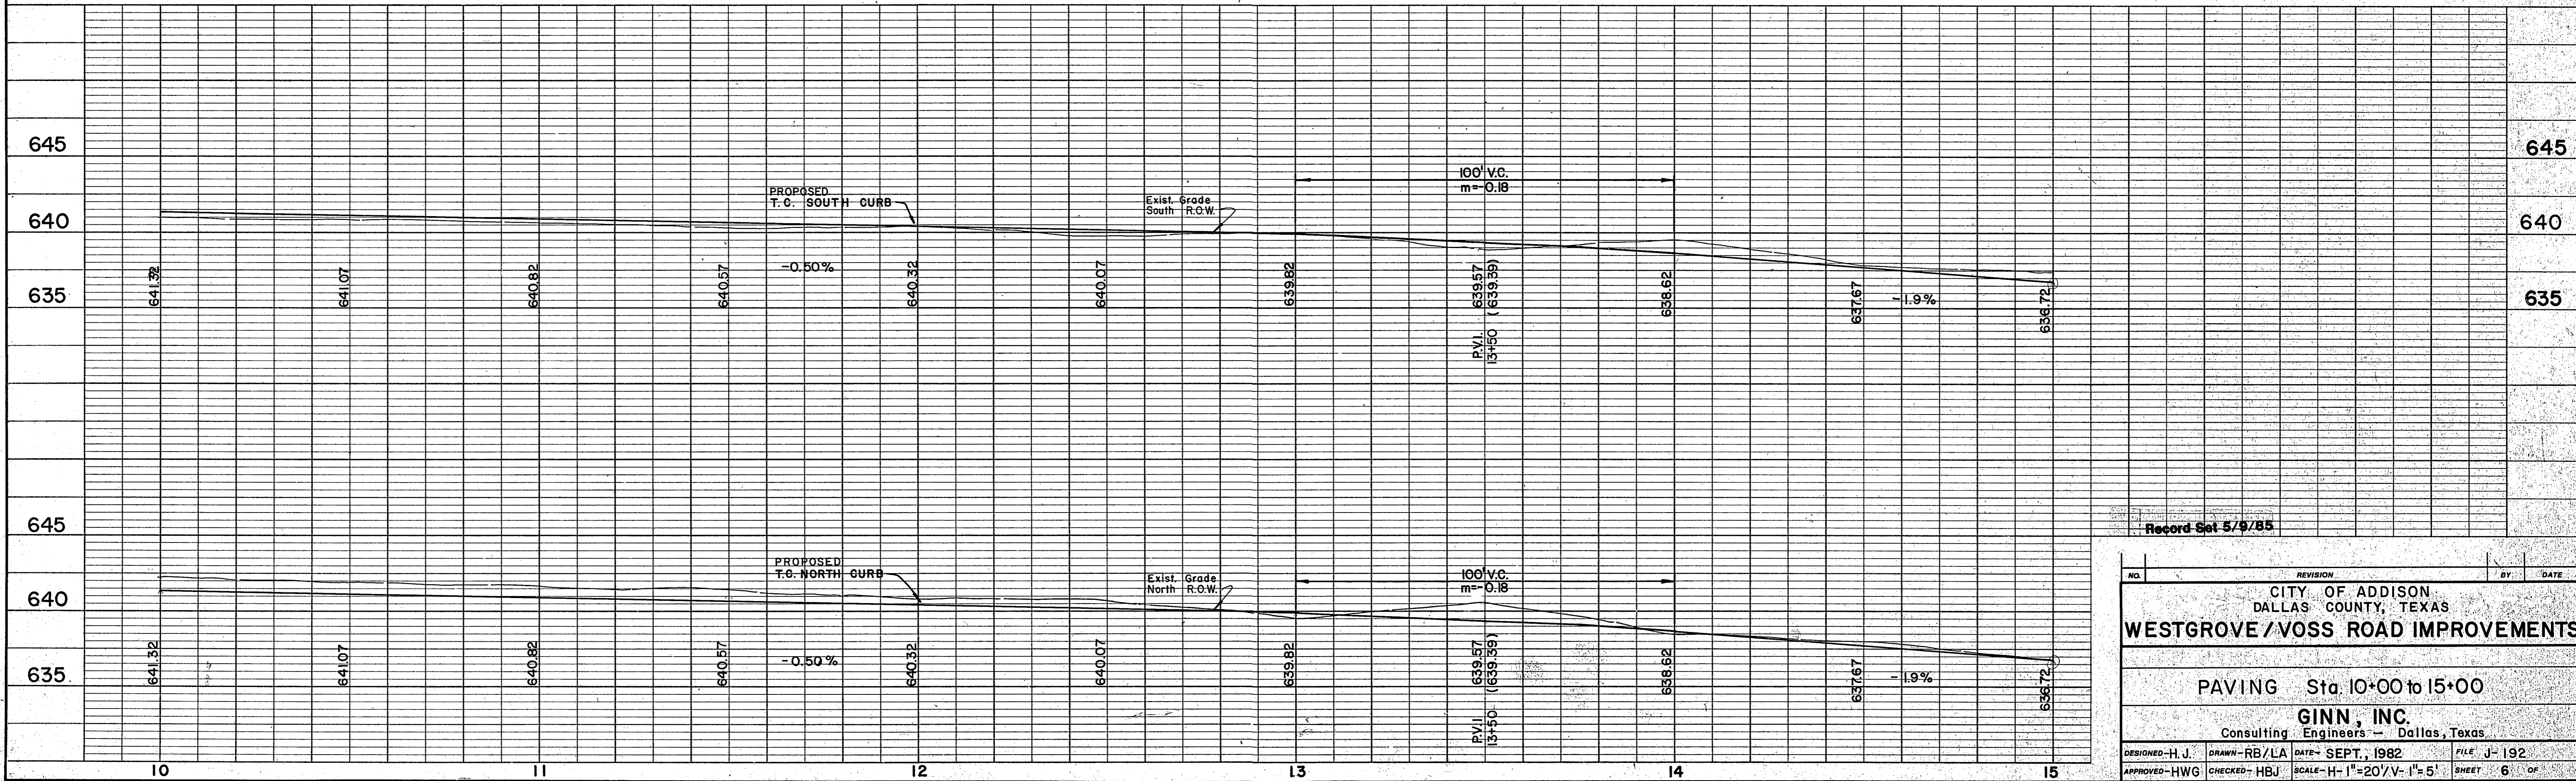

Record Set 5/9/85

NO.	REVISION	BY	DATE
CITY OF ADDISON DALLAS COUNTY, TEXAS			
WESTGROVE / VOSS ROAD IMPROVEMENTS			
PAVING Sta. 10+00 to 15+00			
GINN, INC. Consulting Engineers - Dallas, Texas			
DESIGNED - H.J.	DRAWN - RB/LA	DATE - SEPT., 1982	FILE - J-192
APPROVED - HWG	CHECKED - HB	SCALE - H-1"=20'/V-1"=5'	SHEET 6 OF 6