

B19-8

TNP PROJECT NUMBER: ADD 01333


TOWN OF ADDISON, TEXAS

CONSTRUCTION PLANS FOR

WRIGHT BROTHERS / WILEY POST

WATER LINE REPLACEMENT

ADDISON, TEXAS

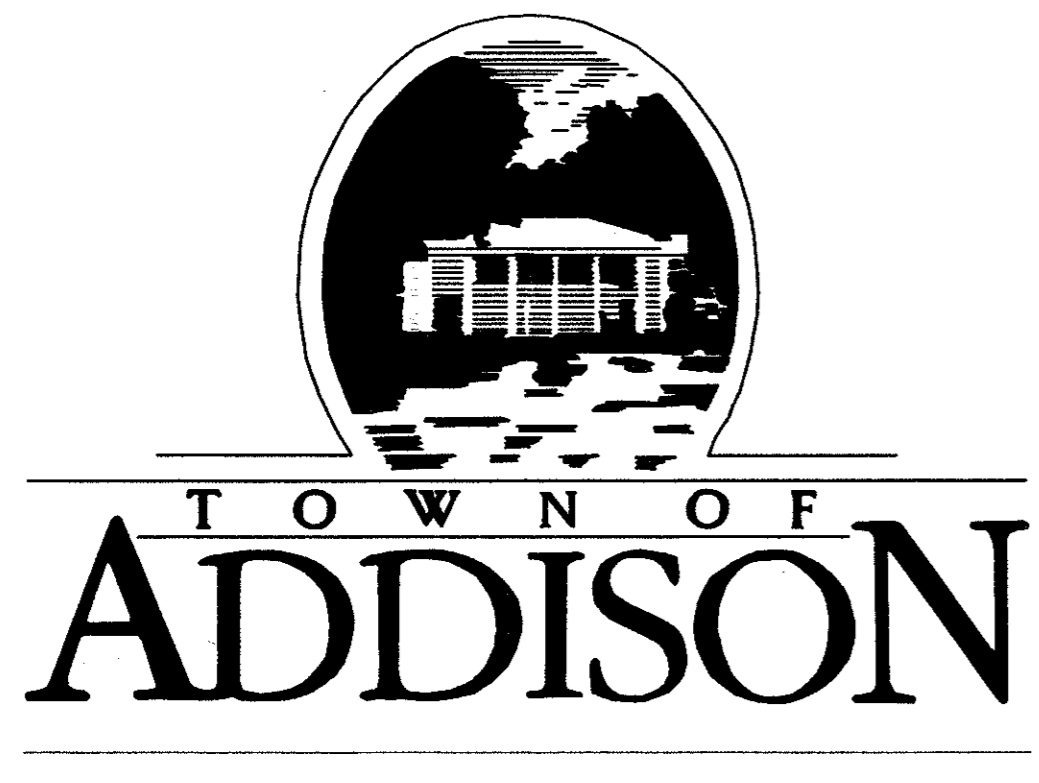

MAYOR
R. SCOTT WHEELER


MAYOR PRO-TEM
CATHY WAYS

DEPUTY MAYOR PRO-TEM
BOB BARRETT

COUNCIL MEMBERS
DIANE MALLORY
GLYNDA TURNER
JOE CHOW
FREDERICK M. SILVER

CITY MANAGER
RON WHITEHEAD

PUBLIC WORKS DIRECTOR
MICHAEL MURPHY, P.E.

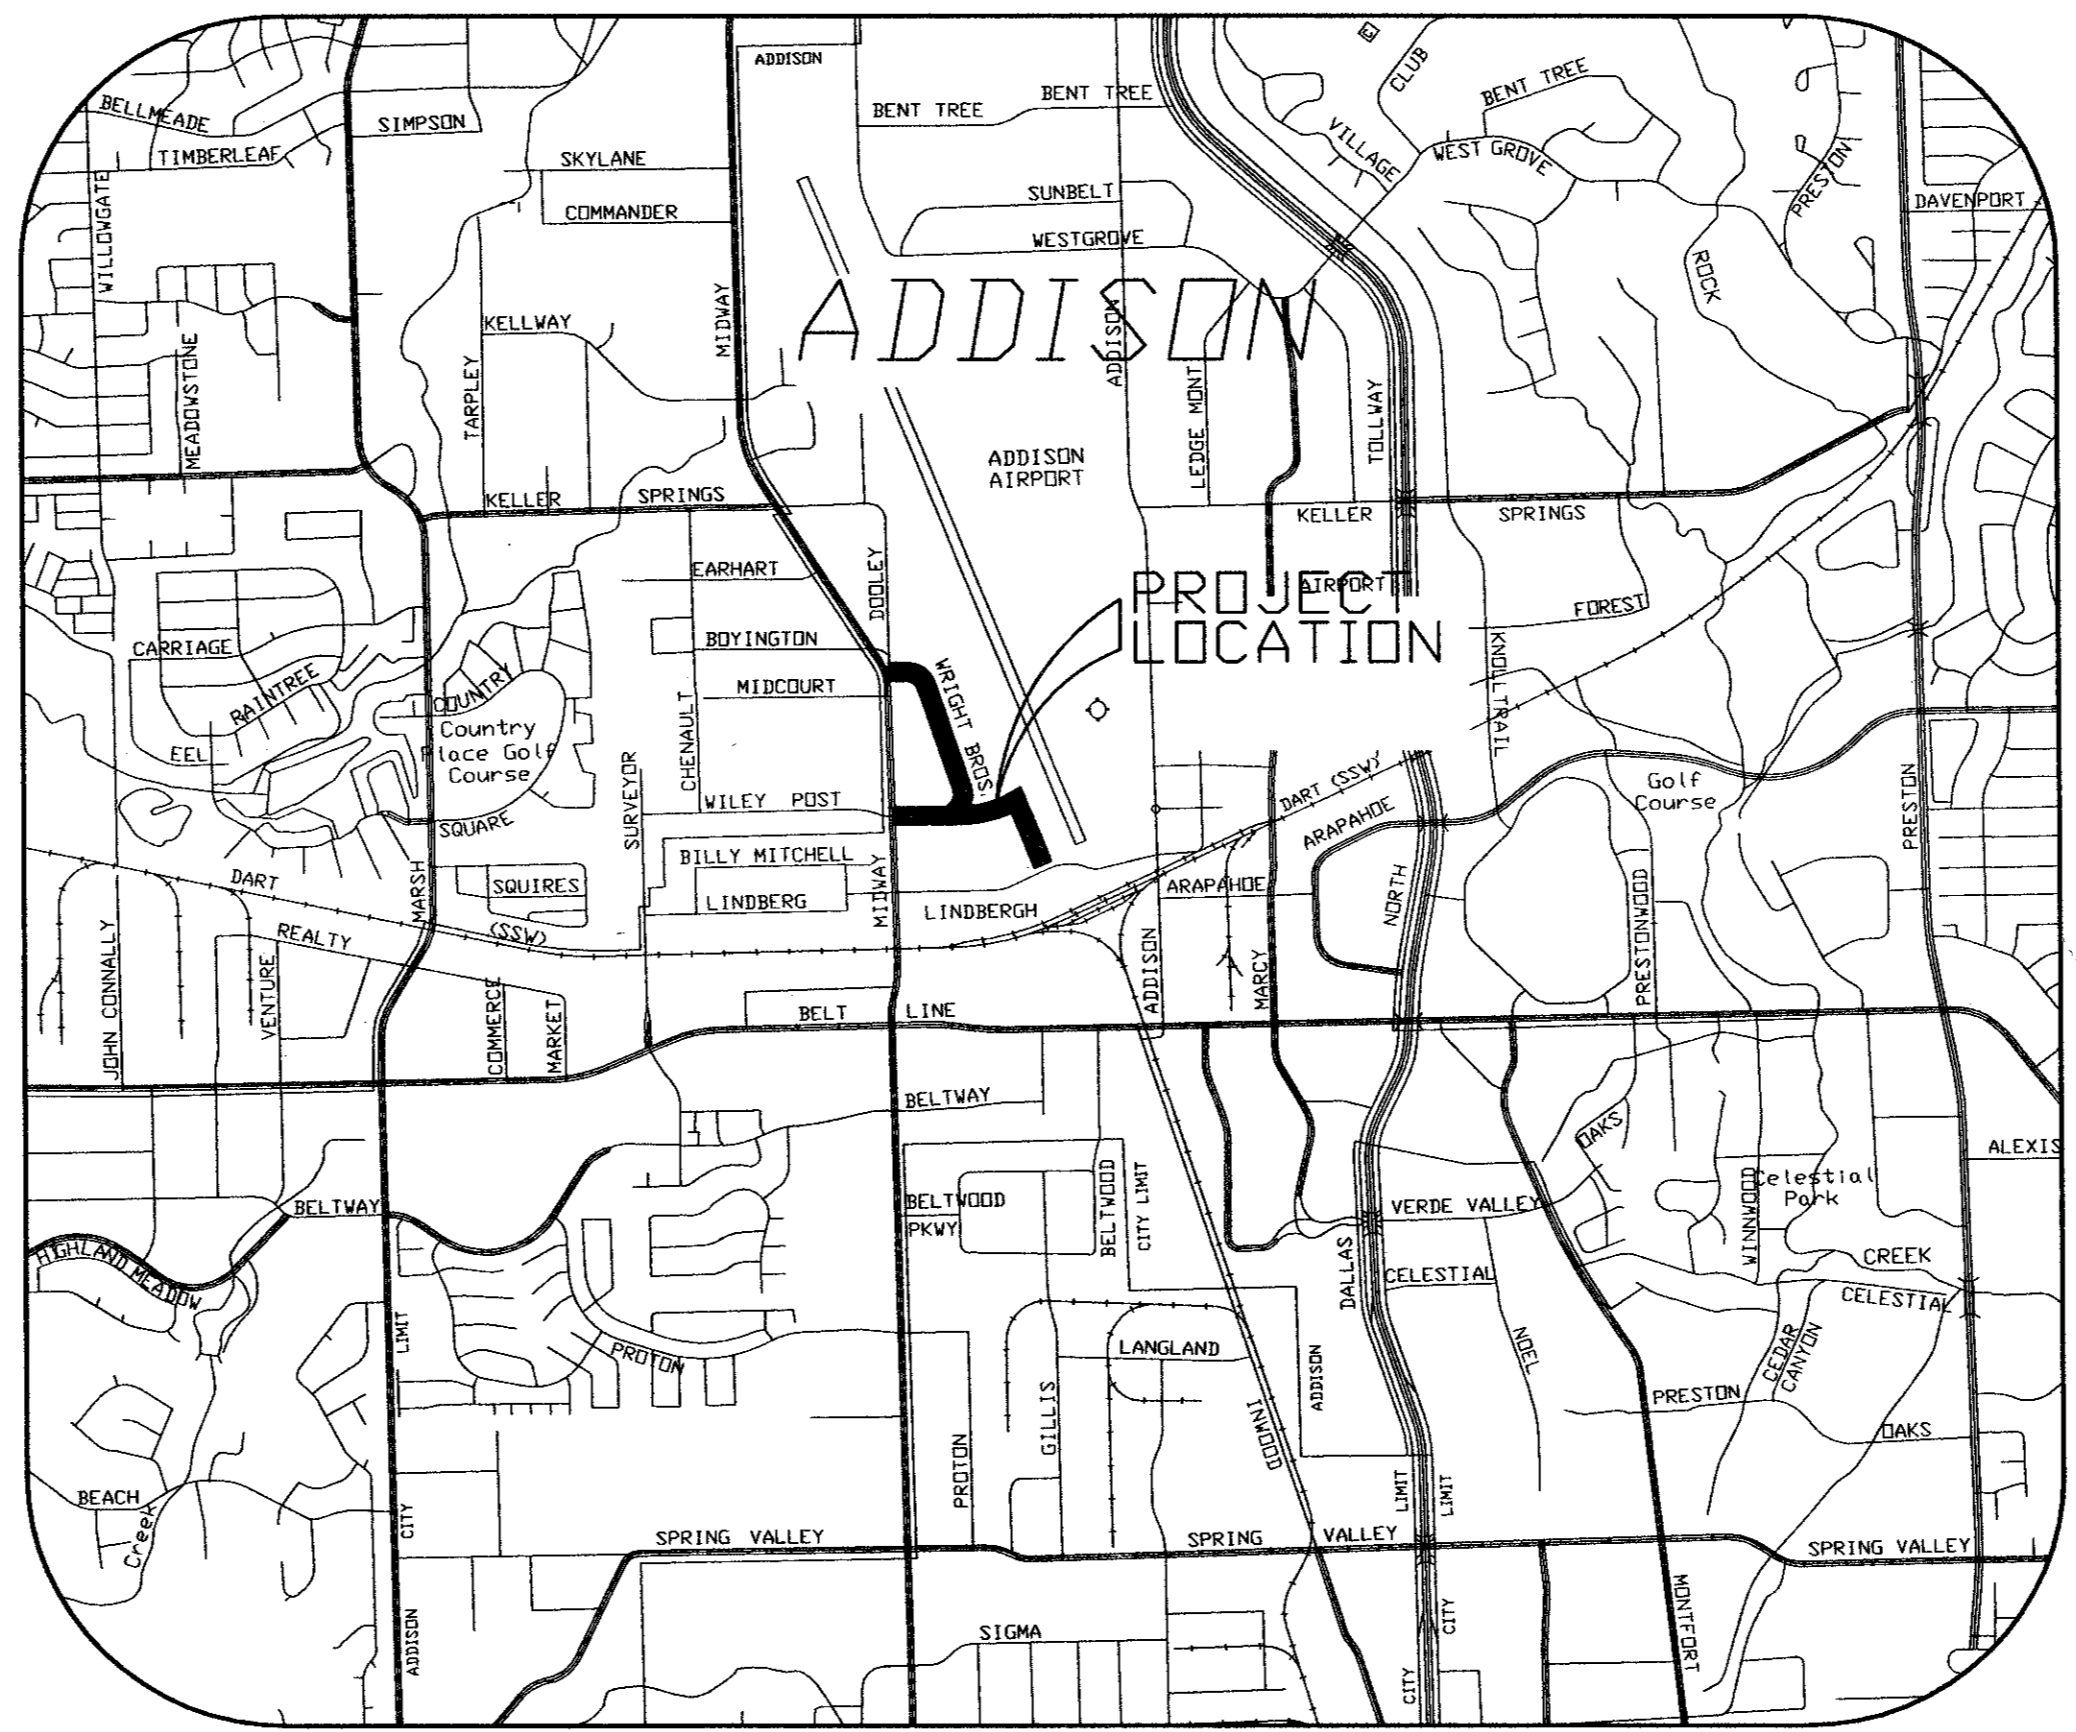

LOCATION MAP

JULY 2002



TEAGUE NALL AND PERKINS
CONSULTING ENGINEERS

SHEET INDEX	
SHEET NO.	DESCRIPTION
1	COVER SHEET
2	GENERAL NOTES & LEGEND
3	WATER LINE PLAN - WRIGHT BROTHERS STA. 0+00.00 TO STA. 5+00.00
4	WATER LINE PLAN - WRIGHT BROTHERS STA. 5+00.00 TO STA. 10+00.00
5	WATER LINE PLAN - WRIGHT BROTHERS STA. 10+00.00 TO STA. 15+00.00
6	WATER LINE PLAN - WRIGHT BROTHERS STA. 15+00.00 TO STA. 17+33.34
7	WATER LINE PLAN - WILEY POST STA. 0+00.00 TO STA. 5+00.00
8	WATER LINE PLAN - WILEY POST STA. 5+00.00 TO STA. 10+00.00
9	WATER LINE PLAN - WILEY POST STA. 10+00.00 TO STA. 15+00.00
10	WATER LINE PLAN - WILEY POST STA. 15+00.00 TO STA. 18+84.98
11	MISCELLANEOUS DETAILS 1
12	MISCELLANEOUS DETAILS 2

Const. mark-up



Mark E. Riddle
MARK E. RIDDLE, P.E.
DATE: 07.10.02

B19-8

TNP PROJECT NO.: ADD 01333

Const. mark-up

Notes added

WRIGHT BROTHERS / WILEY POST WATER LINE REPLACEMENT