

CAUTION !!!
COMMUNICATION CABLE &
CONDUIT IN FIRE LINE DITCH

- NOTES:**
1. EXISTING GAS SERVICES ARE PRESENT; EXACT LOCATIONS NOT KNOWN.
 2. THE CONTRACTOR SHALL PRESERVE AND PROTECT EXISTING DRIVEWAYS AT ALL TIMES DURING CONSTRUCTION.
 3. THE CONTRACTOR SHALL MAINTAIN WATER SERVICE AT ALL TIMES DURING CONSTRUCTION. SEE NOTE #4 ON GENERAL NOTES & LEGEND SHEET.
 4. THE CONTRACTOR SHALL TAKE THE NECESSARY PRECAUTIONS TO PROTECT ALL OVERHEAD UTILITIES FROM DAMAGE. REPAIR OF DAMAGED UTILITIES WILL BE AT THE CONTRACTOR'S OWN EXPENSE.
 5. THE CONTRACTOR SHALL BE RESPONSIBLE FOR MAKING SERVICE CONNECTIONS TO ALL NEW WATER METERS. IF SERVICE CONNECTION CROSSES STREET, THE CONTRACTOR SHALL BORE UNDER THE STREET IN ORDER TO MAKE THE CONNECTION.

WRIGHT BROTHERS DRIVE

B.M.:

CROSS CUT SET IN THE SOUTH EDGE OF A DRIVEWAY IN THE NORTH SIDE OF WRIGHT BROTHERS 29.3' EAST OF THE EAST EDGE OF MIDWAY AND 23' NORTH OF THE CURB LINE OF WRIGHT BROTHERS DRIVE. ELEV.=648.99

BOX CUT IN THE CENTER OF AN INLET AT THE NORTHEAST CORNER OF WILEY POST AND MIDWAY ALONG THE NORTH SIDE OF WILEY POST. ELEV.=631.53

CUT CROSS FOUND AT THE SOUTH SIDE OF WILEY POST ROAD AT THE PROJECTION OF CENTERLINE OF WRIGHT BROTHERS ROAD 12.6' WEST OF A 4' INLET. ELEV.=637.24


NO.	REVISION	BY	DATE

MSW
DESIGNED
DAS
DRAWN
JRP
CHECKED

TOWN OF
ADDISON

SCALE
HORIZ
1"=20'
VERT
N/A
DATE
JULY 2002

TEAGUE NALL AND PERKINS
CONSULTING ENGINEERS
1100 Macon Street
Fort Worth, Texas 76102
(817) 336-5773
2001 West Irving Blvd.
Irving, Texas 75061
(972) 254-1765

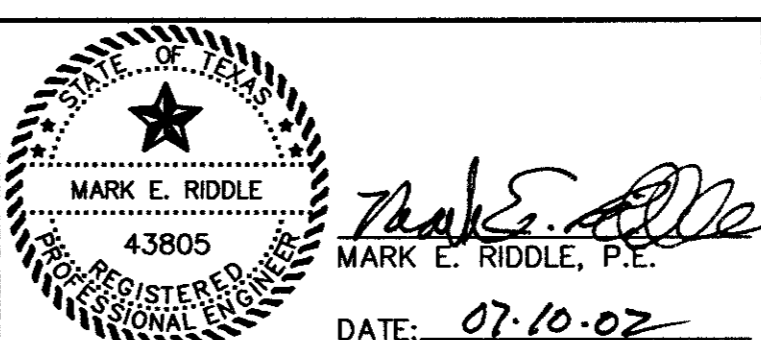

TOWN OF ADDISON
WRIGHT BROTHERS / WILEY POST
WATER LINE REPLACEMENT
WATER LINE PLAN - WRIGHT BROTHERS
STA. 10+00.00 TO STA. 15+00.00

TNP PROJECT
ADD01333
SHEET
5
OF
12