



C/L STORM SEWER CURVE DATA

NO.	DELTA	RADIUS	TANGENT	LENGTH
①	11°40'40"	130.00'	13.29'	26.50'
②	14°27'48"	70.00'	8.88'	17.67'
③	06°48'31"	110.00'	6.54'	13.07'
④	04°06'10"	200.00'	7.16'	14.32'


- NOTES:
- SEE SHEET 6 FOR SWALE AND FRENCH DRAIN TYPICAL SECTION.
 - REPLACEMENT OF HEDGES/TREES REQUIRED BY CONTRACTOR IF DAMAGED BY CONSTRUCTION. NO TREES OVER 1" DIA. TO BE REMOVED WITHOUT SPECIFIC AUTHORITY BY THE TOWN.

!! CAUTION !!
RELOCATION OF TELEPHONE CABLE BY SWBT REQUIRED PRIOR TO INSTALLATION OF STORM DRAIN.

! EQUATION !
STA. 3+00.00 'A' BACK = STA. 2+94.52 'A' FWD. (SEE SHEET 4)


!! CAUTION !!
RELOCATION OF 6" GAS LINE BY LONE STAR GAS REQUIRED PRIOR TO INSTALLATION OF STORM DRAIN.

!! WARNING !!
LOCATION OF EXISTING UTILITIES SHOWN ARE APPROXIMATE! CONTRACTOR SHALL FIELD VERIFY LOCATIONS OF ALL EXISTING UTILITIES PRIOR TO CONSTRUCTION. CONTRACTOR SHALL CONTACT:
LONE STAR GAS CO. 263-DIGG
SOUTHWESTERN BELL 998-4102
T.U. ELECTRIC 323-8910
STORER CABLE 840-2388

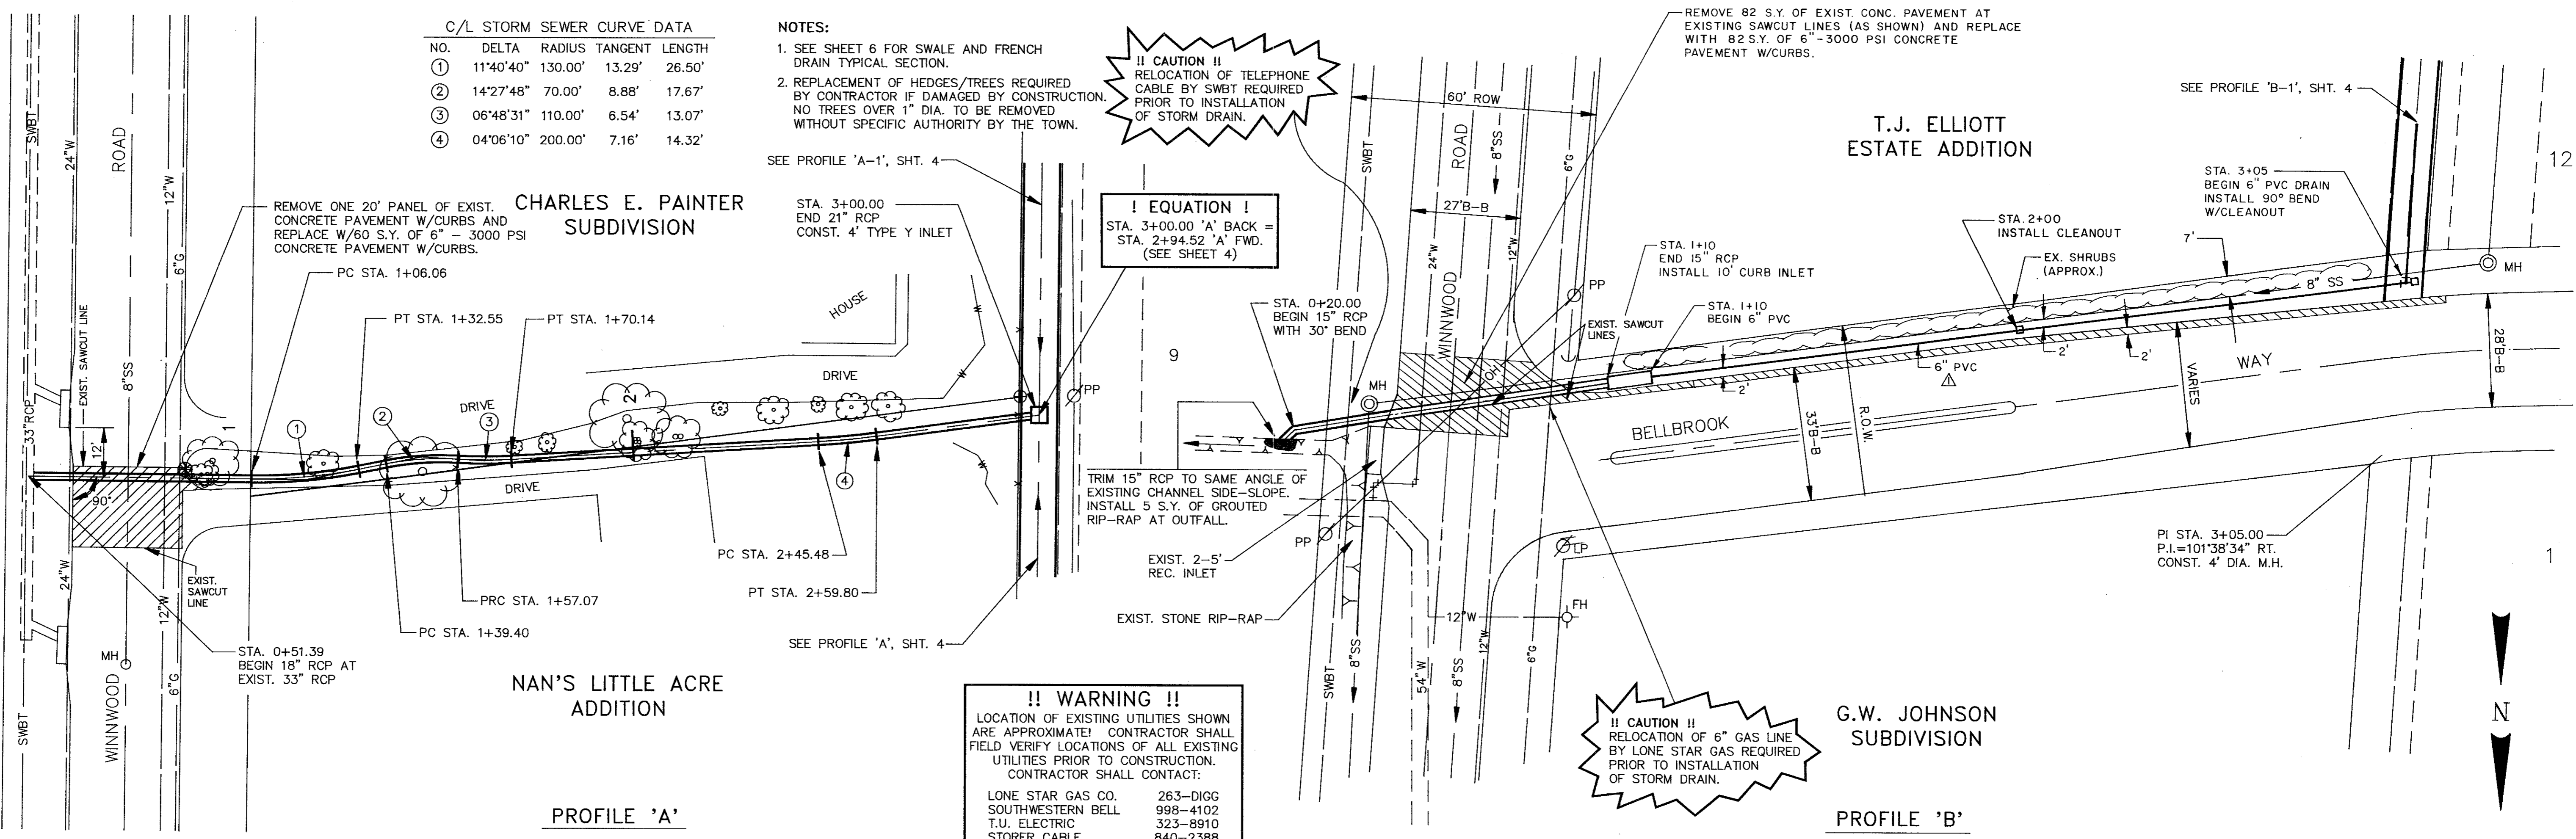

PROFILE 'A'

PROFILE 'B'

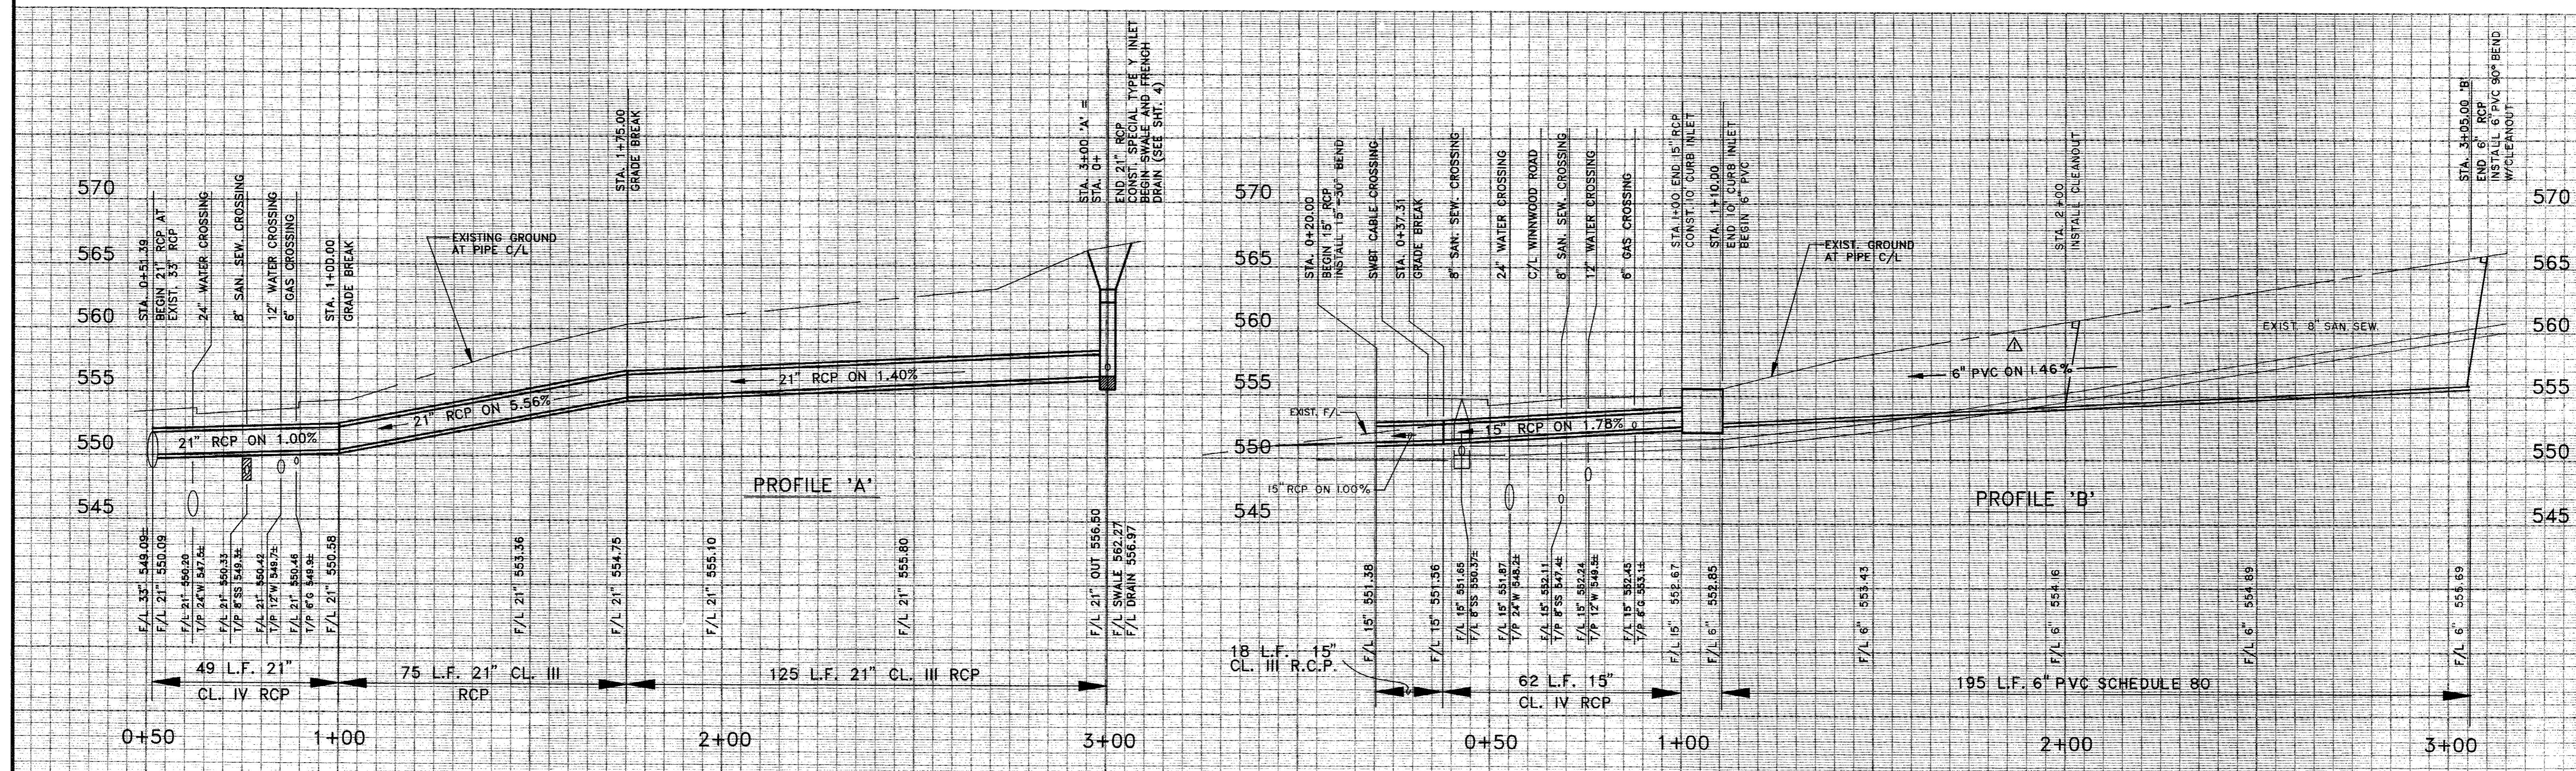


PROFILE 'A'

PROFILE 'B'

NO.	REVISION	BY	DATE
1	ADD 6" PVC	B.G.	7/30/90

DESIGNED BY: E.H.&A.
DRAWN BY: E.H.&A.
CHECKED BY: B. GRANTHAM
SCALE: 1"=6' V: 1"=20' H
DATE: MAY 1990

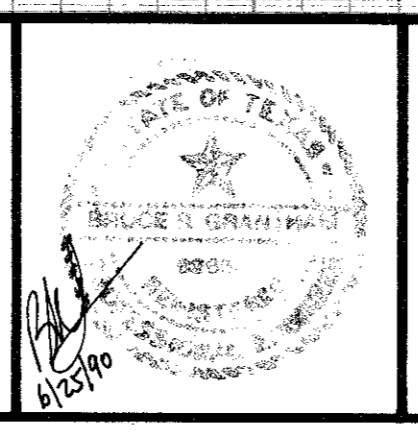

ESPEY, HUSTON & ASSOCIATES, INC.
Engineering & Environmental Consultants
17811 Waterview Parkway Dallas, Texas 75252
(214) 669-9600

PLAN & PROFILE
WINNWOOD/BELLBROOK DRAINAGE
for
THE TOWN OF ADDISON

SHEET NO. 3
OF 6 SHEETS
JOB NO. 12552